
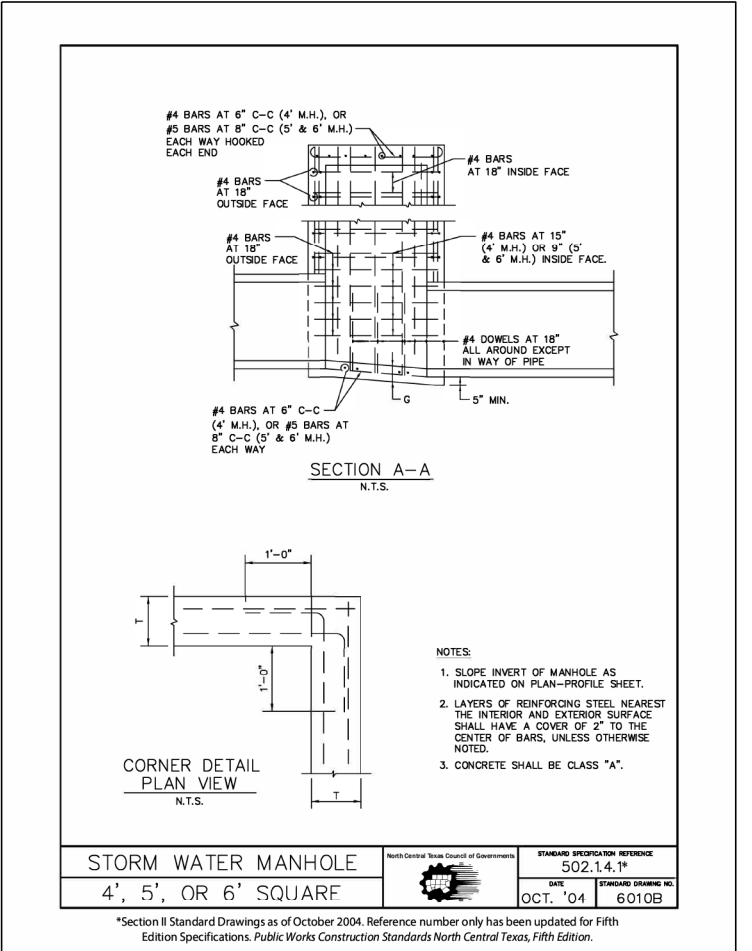
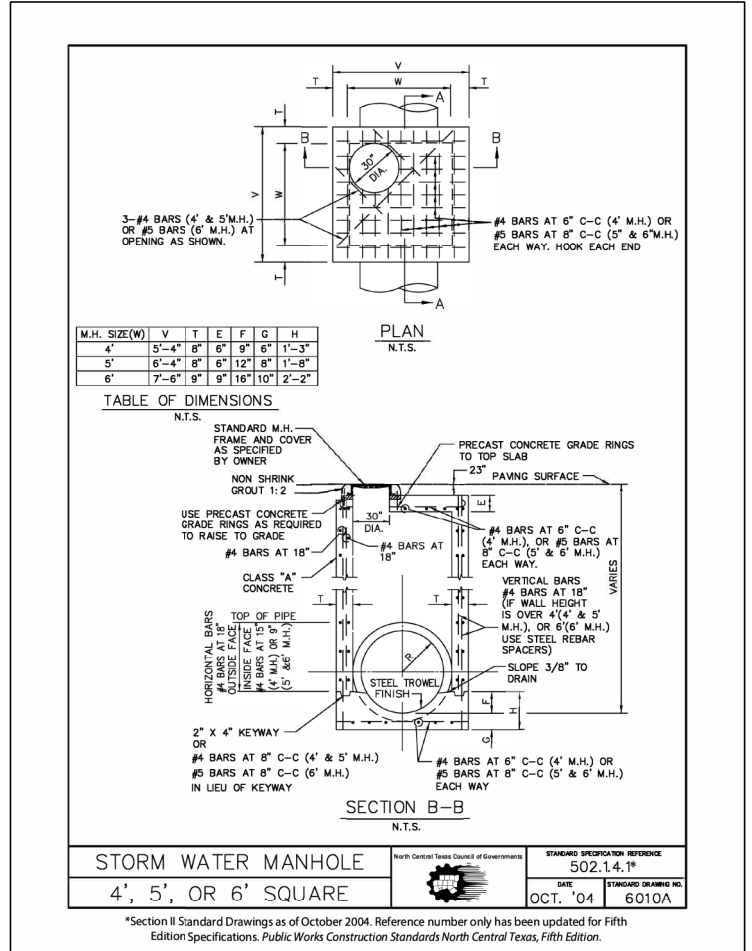


RECORD DRAWINGS

THE INTENT OF THE OWNER AND ENGINEER WAS TO CONSTRUCT THE FACILITIES ACCORDING TO THESE PLANS AS APPROVED BY THE TOWN OF ADDISON, THE OWNER OR ENGINEER DID NOT VERIFY LINES OR GRADES AFTER CONSTRUCTION AND IS NOT AWARE OF ANY CHANGES OR REVISIONS TO THESE PLANS DURING CONSTRUCTION EXCEPT AS NOTED BASED ON INFORMATION PROVIDED BY JOE FUNK CONSTRUCTION, INC., 11226 INDIAN TRAIL, DALLAS, TX 75229

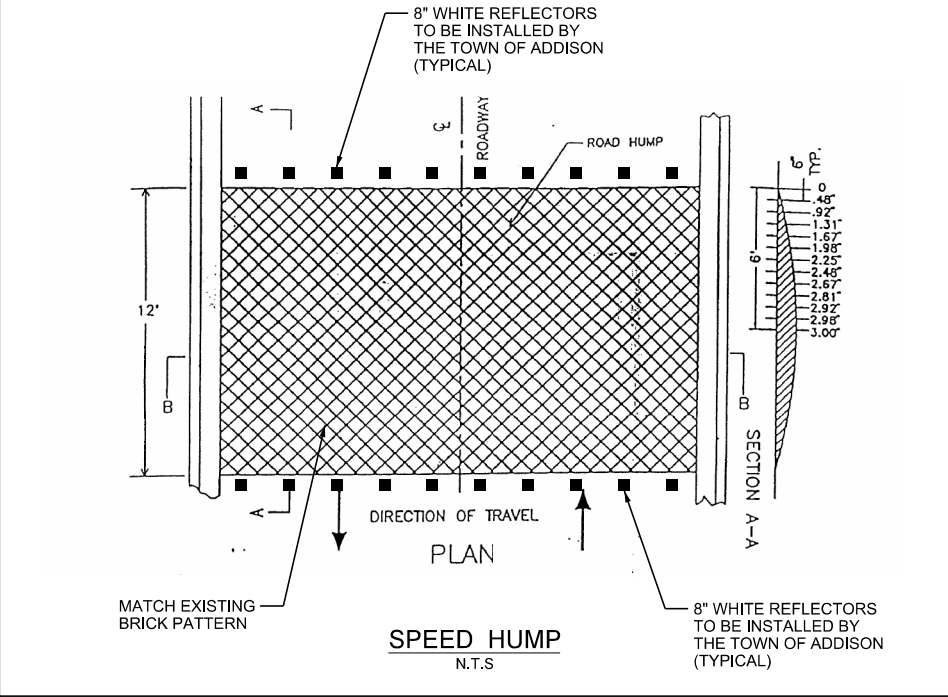

NOV 07, 2019

REV. NO.	DATE	DESCRIPTION	BY

CRIADO 4100 SPRING VALLEY ROAD, SUITE 1001
DALLAS, TX 75244
O: 972-392-9092 F: 972-392-9192
FIRM NO. F-4373

CONSTRUCTION DETAILS
SHEET 3 OF 6

OAKS NORTH DRIVE
DRAINAGE IMPROVEMENTS
TOWN OF ADDISON, TEXAS

DESIGN	DRAWN	DATE	SCALE	NOTES	FILE	NO.
CRIADO	CRIADO	NOV 2019	AS SHOWN	R14285.01	DETAILS	CD-03

DATE: 11/20/2020 TIME: 9:58:44 AM FILE NAME: N:\PROJECTS\R14285.00_Addison_2017 Various Projects\Drainage\07_DON0706_Sheets\1428501_Details.dgn