

CONSTRUCTION PLANS FOR **PARKVIEW AT ADDISON CIRCLE**

AN ADDITION TO
THE TOWN OF ADDISON, TEXAS

Index Of Drawings

C1	COVER SHEET
C2, C3	FINAL PLAT
C4	DRAINAGE AREA MAP
C5, C6	GRADING PLAN
C7	PAVING PLAN & PROFILE SEABOLT DRIVE BREEDLOVE DRIVE
C8	PAVING PLAN & PROFILE PARKVIEW DRIVE CALLOWAY DRIVE
C9	PAVING PLAN & PROFILE PARKVIEW SOUTH DRIVE PARKVIEW NORTH DRIVE PARKVIEW DRIVE
C10A	QUORUM DRIVE IMPROVEMENTS
C10B	QUORUM DRIVE IMPROVEMENTS
C11	PAVING PLAN (PRIVATE ONSITE)
C12	STORM SEWER PLAN
C13, C14, C15	STORM SEWER PROFILES
C16	WATER PLAN
C17	SANITARY SEWER PLAN
C18, C19	SANITARY SEWER PROFILES
C20	TXU DUCTBANK PLAN
C21	TXU DUCTBANK PROFILE
C22	TRAFFIC SIGNS & PAVEMENT MARKING PLAN
C23	TRAFFIC CONTROL PLAN - QUORUM DRIVE
C24	TRAFFIC CONTROL PLAN - MORRIS AVENUE
C25	GENERAL NOTES
C26	EROSION CONTROL PLAN
C27	EROSION CONTROL DETAILS
C28, C29	PAVING DETAILS
C30, C31, C32	DRAINAGE DETAILS
C33	WATER DETAILS
C34	WASTEWATER DETAILS
C35 - C42	TU ELECTRIC DUCTBANK DETAILS

DEVELOPER:
CITYHOMES

3209 North Fitzhugh Avenue

Dallas, Texas 75204

(214)219-2900


ENGINEER:

BROCKETTE · DAVIS · DRAKE

4144 North Central Expressway, Suite 1100

Dallas, Texas 75204

Tel: (214) 824-3647

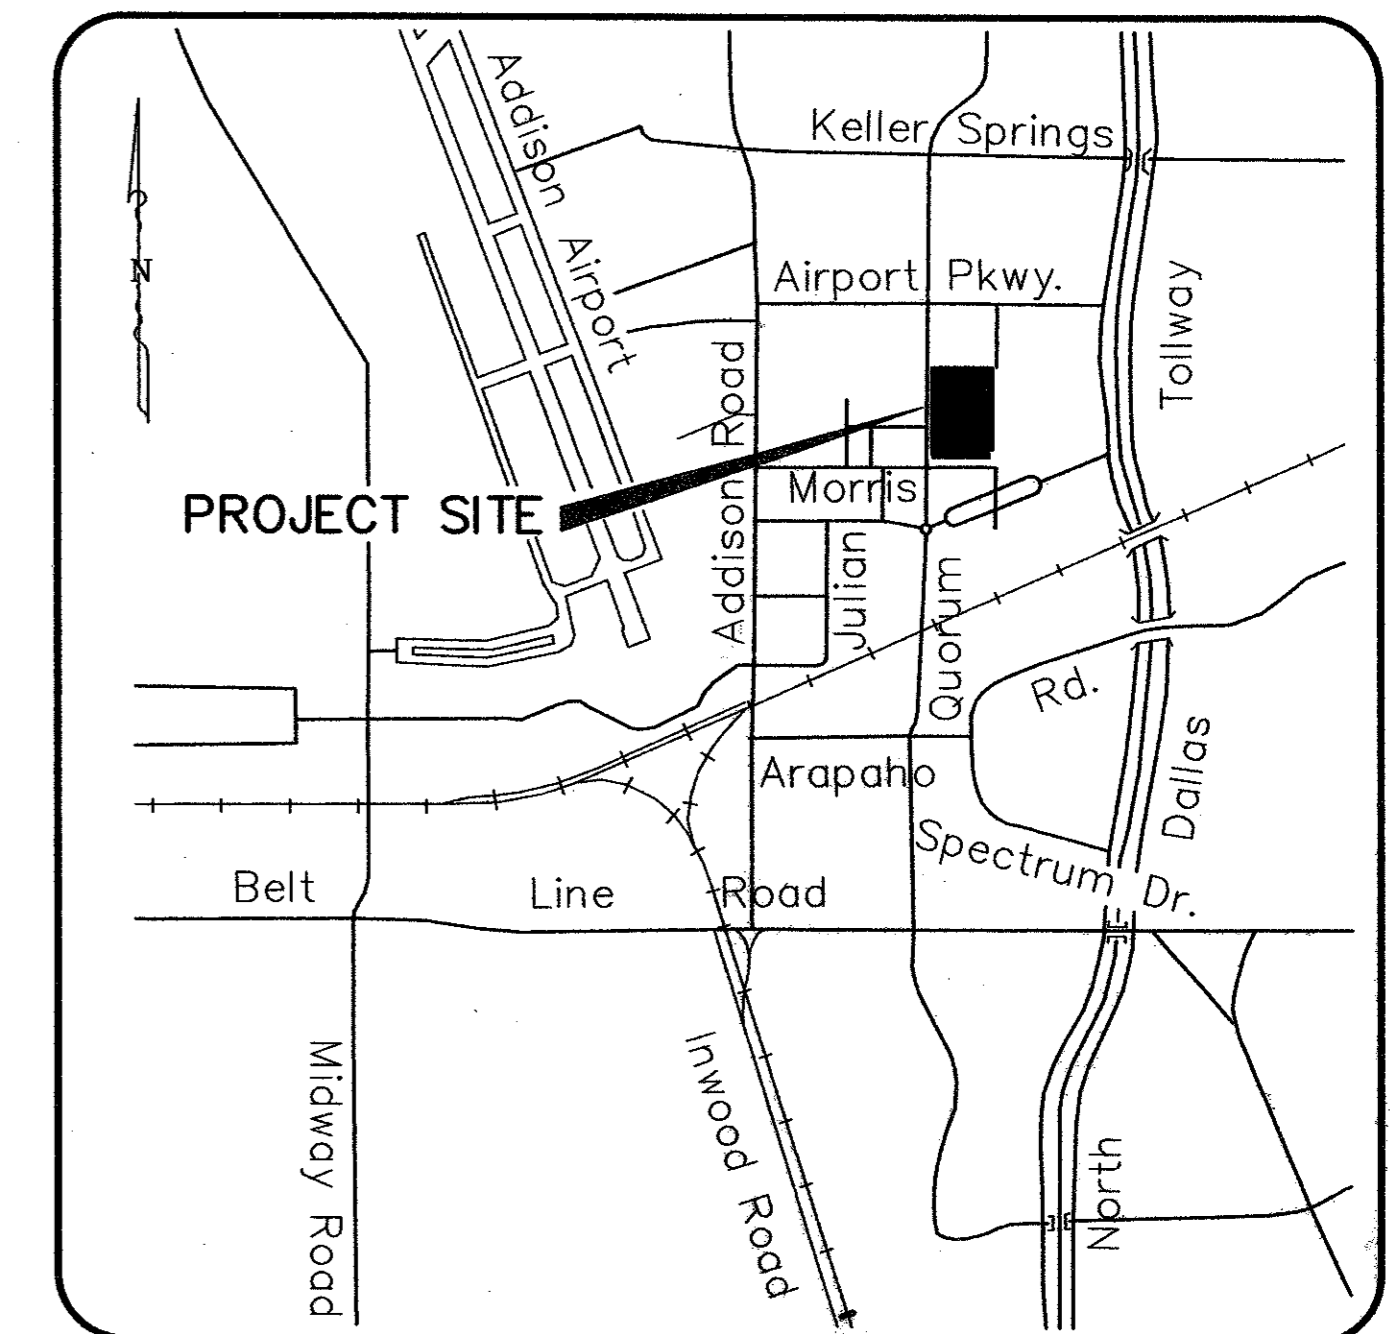

Location Map
NTS

AS-BUILT
NOVEMBER 4, 2004

NOTE:
THESE PLANS HAVE BEEN REVISED
TO CONFORM WITH CONSTRUCTION
RECORDS PROVIDED BY CONTRACTOR.

