

CAUTION!!!
 EXISTING PHONE, FIBER OPTICS, GAS, ELECTRICAL & CATV LINES IN PROJECT AREA. CONTRACTOR SHALL VERIFY LOCATION OF ALL UTILITIES PRIOR TO CONSTRUCTION. NOTIFY THE FOLLOWING UTILITY COMPANIES AT LEAST 48 HOURS PRIOR TO CONSTRUCTION.

TEXAS ONE CALL: 1-800-245-4545
 COMCAST CABLEVISION: 1-214-320-7396
 SOUTHWESTERN BELL TELE: 1-800-233-2133
 T.X.U. ELECTRIC CO: 1-800-242-9113
 T.X.U. GAS CO: 1-800-344-8337

- LEGEND**
- Existing Curb
 - Proposed Curb
 - Sawcut
 - EJ Expansion Joint
 - - - Proposed R.O.W.
 - 6"-3600 PSI, Compressive Strength, Reinforced Conc. Pavement @ 28 Days, W/ 6" Lime Stabilized Subgrade.
 - ▨ BRICK PAVERS - SIDEWALK PAVERS
 - ▩ BRICK PAVERS - VEHICULAR PAVERS

NOTE:
 ALL ADA ACCESSIBLE ROUTES SHALL HAVE MAXIMUM 2% CROSS SLOPES AND MAXIMUM 5% LONGITUDINAL SLOPE.

NOTE:
 INSTALL BRICK PAVERS PER DETAIL ON SHEET C29

BENCHMARK:
 "D" CUT ON EAST SIDE OF 6" INLET NORTH SIDE OF MORRIS AVENUE, 200' +/- EAST OF THE CENTERLINE OF QUORUM DRIVE.
 ELEVATION: 616.41

PAVING PLAN (PRIVATE ONSITE)
 PARKVIEW AT ADDISON CIRCLE
 TOWN OF ADDISON, TEXAS
 DALLAS COUNTY


BRACKETTE · DAVIS · DRAKE, inc.
 consulting engineers
 Civil & Structural Engineering · Surveying
 4144 North Expressway, Suite 1100 Dallas, Texas 75204
 (214)824-3647, fax (214) 824-7064

DESIGNED	DRAWN	DATE	SCALE	NOTES	FILE	NO.
RRJ	BDD	04/04	1"=40'	BDD	C03393	C11

NOTE:
 ALL DIMENSIONS ARE TO BACK OF CURB UNLESS OTHERWISE NOTED.

AS-BUILT
 NOVEMBER 4, 2004

NOTE:
 THESE PLANS HAVE BEEN REVISED TO CONFORM WITH CONSTRUCTION RECORDS PROVIDED BY CONTRACTOR.

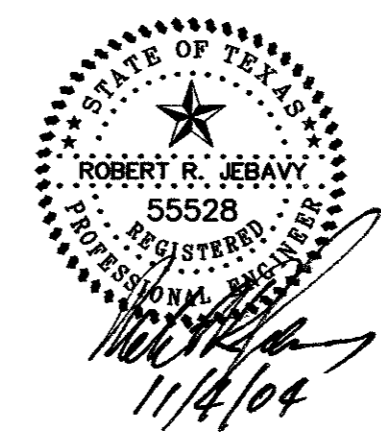

▲ ADD 2' CURB AND BFR'S TO PARK AREA. 6/04/04

Copyright 2003 Brackette/Davis/Drake, Inc. All Rights Reserved. No part of this drawing may be reproduced, stored in a retrieval system, or used in any form or by any means, without the written authorization of Brackette/Davis/Drake, Inc. is prohibited.

TXU ELECTRIC COMPANY ESMT.
 VOL. 2000036, Pg. 2913