



© Copyright 2003 Brockett/Davis/Drake, Inc. All Rights Reserved.
 This drawing is the property of Brockett/Davis/Drake, Inc.
 Any modification or use of this drawing without the express
 written authorization of Brockett/Davis/Drake, Inc. is prohibited.

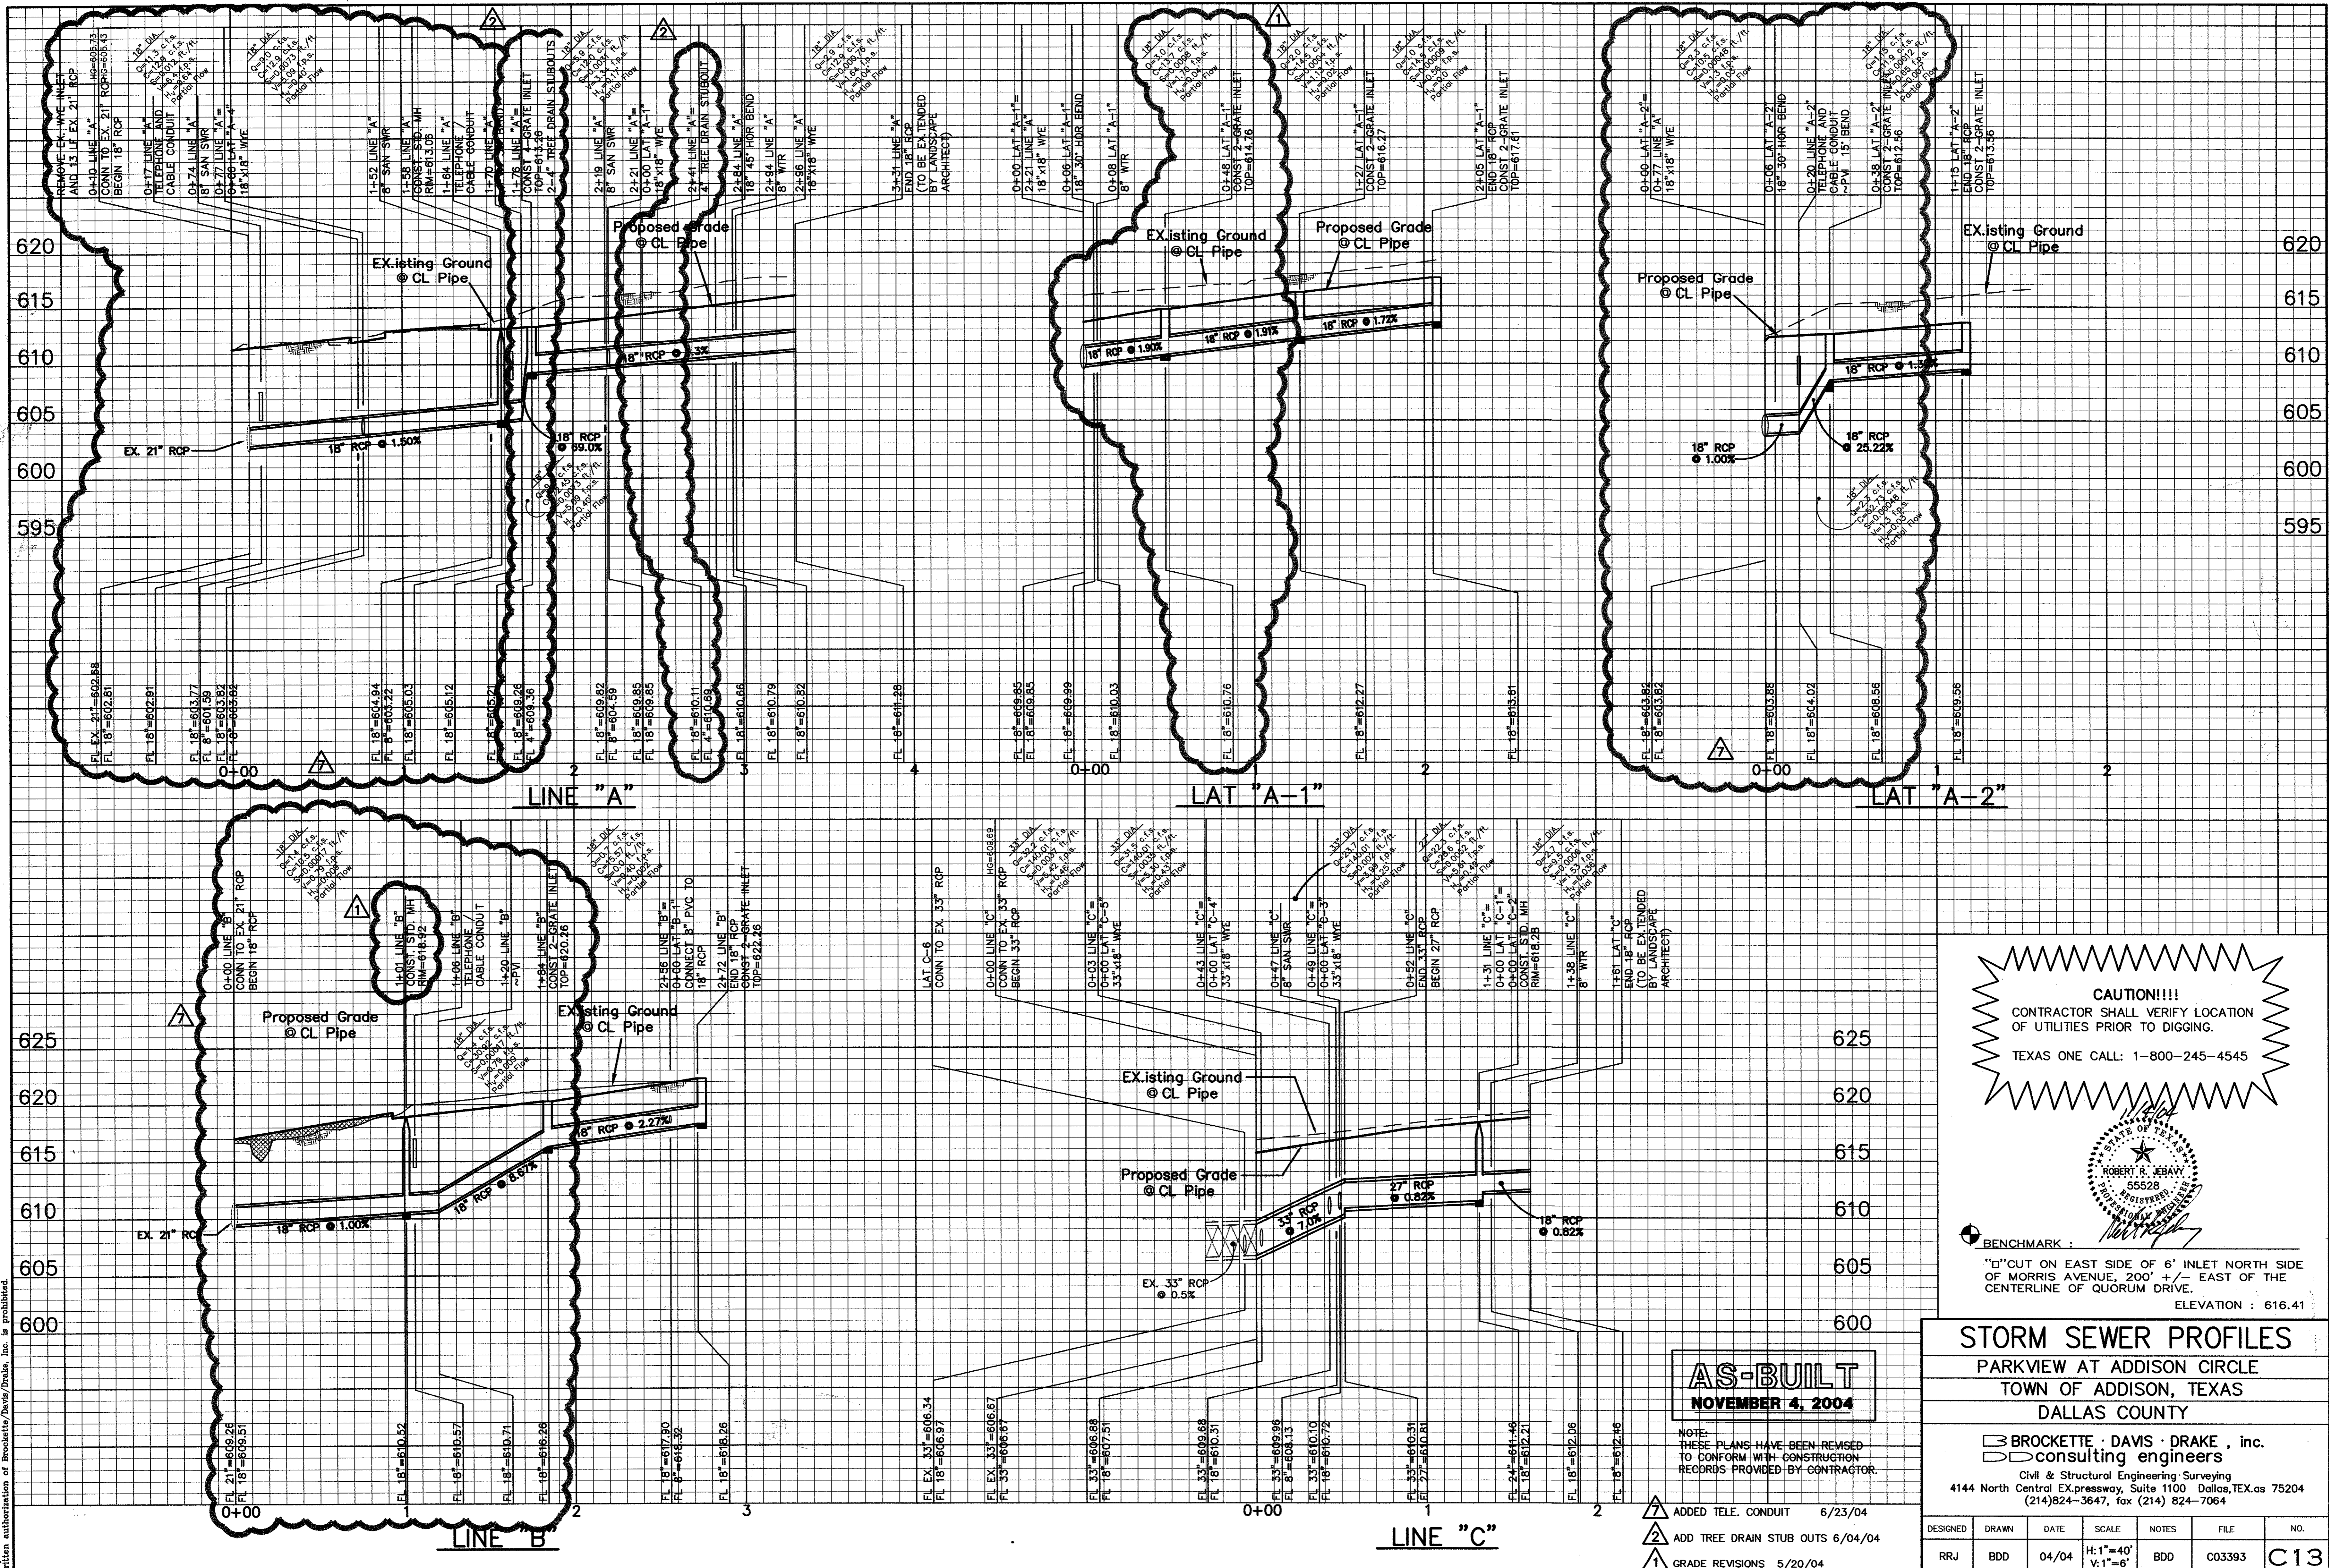

CAUTION!!!
 CONTRACTOR SHALL VERIFY LOCATION
 OF UTILITIES PRIOR TO DIGGING.
 TEXAS ONE CALL: 1-800-245-4545

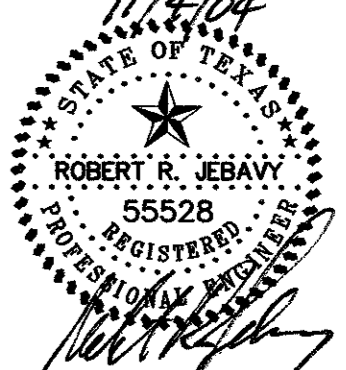

BENCHMARK:
 "1" CUT ON EAST SIDE OF 6" INLET NORTH SIDE
 OF MORRIS AVENUE, 200' +/- EAST OF THE
 CENTERLINE OF QUORUM DRIVE.
 ELEVATION: 616.41

AS-BUILT
 NOVEMBER 4, 2004

NOTE:
 THESE PLANS HAVE BEEN REVISED
 TO CONFORM WITH CONSTRUCTION
 RECORDS PROVIDED BY CONTRACTOR.

- ▲ ADDED TELE. CONDUIT 6/23/04
- ▲ ADD TREE DRAIN STUB OUTS 6/04/04
- ▲ GRADE REVISIONS 5/20/04

STORM SEWER PROFILES
 PARKVIEW AT ADDISON CIRCLE
 TOWN OF ADDISON, TEXAS
 DALLAS COUNTY

▣ BROCKETTE · DAVIS · DRAKE, inc.
 consulting engineers
 Civil & Structural Engineering · Surveying
 4144 North Central Expressway, Suite 1100 Dallas, TEX. 75204
 (214) 824-3647, fax (214) 824-7064

DESIGNED	DRAWN	DATE	SCALE	NOTES	FILE	NO.
RRJ	BDD	04/04	H:1"=40' V:1"=6'	BDD	C03393	C13

C03393 PLANS CON'G - STAMP/PROF - PVI