


- WATER NOTES:**
1. ALL FITTINGS SHALL BE ANCHORED BY FLANGE, RESTRAINING GLAND, OR ANCHOR COUPLING.
 2. USE MEGA-LUG OR APPROVED EQUAL FOR RESTRAINING GLANDS.
 3. ALL 4" FIRE SERVICE CONNECTIONS TO BE MADE WITH 8"x4" TEE AND A 4" VALVE (FLANGED X MJ FITTINGS)

LEGEND

---	Proposed R.O.W.
---	Existing Curb
---	Proposed Curb
XXXXXX	Existing Storm Sewer Line
=====	Proposed Storm Sewer Line
→	Flow Arrow
---	Existing Water Line
---	Proposed Water Line
- W - W -	Proposed Water Service
---	Existing Sanitary Sewer Line
---	Proposed Sanitary Sewer Line
- S - S -	Proposed Sanitary Sewer Service
-----	Existing Duct Bank
-----	Existing Single Phase Overhead Primary
-----	Existing Three Phase Underground Primary
=====	Proposed 6E6 Duct Bank
⊙	Existing 4-Way Manhole
⊙	Proposed 4-Way Manhole

AS-BUILT
NOVEMBER 4, 2004

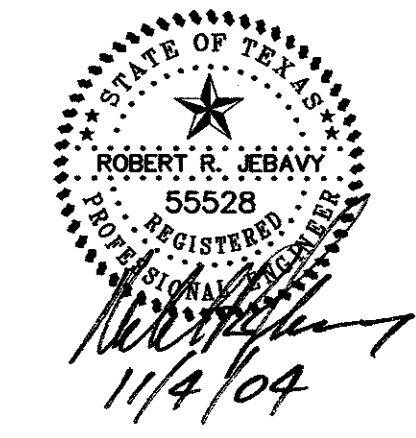

NOTE:
THESE PLANS HAVE BEEN REVISED TO CONFORM WITH CONSTRUCTION RECORDS PROVIDED BY CONTRACTOR.

BENCHMARK:
"D" CUT ON EAST SIDE OF 6" INLET NORTH SIDE OF MORRIS AVENUE, 200' +/- EAST OF THE CENTERLINE OF QUORUM DRIVE.
ELEVATION: 616.41

WATER PLAN						
PARKVIEW AT ADDISON CIRCLE						
TOWN OF ADDISON, TEXAS						
DALLAS COUNTY						
BROCKETTE · DAVIS · DRAKE, inc. consulting engineers						
Civil & Structural Engineering · Surveying 4144 North Central Expressway, Suite 1100 Dallas, Texas 75204 (214) 824-3647, fax (214) 824-7064						
DESIGNED	DRAWN	DATE	SCALE	NOTES	FILE	NO.
RRJ	BDD	04/04	1"=40'	BDD	C03393	C16

CAUTION!!!!
CONTRACTOR SHALL VERIFY LOCATION OF UTILITIES PRIOR TO DIGGING.
TEXAS ONE CALL: 1-800-245-4545

- 9 RELOCATED METER VAULTS 10/07/04
- 8 RELOCATED METER VAULTS 6/23/04

Copyright 2004 Brockette/Davis/Drake, Inc. All Rights Reserved.
No part of this drawing may be reproduced, stored in a retrieval system, or used in any form without the express written authorization of Brockette/Davis/Drake, Inc. is prohibited.