

CAUTION!!!
 CONTRACTOR SHALL VERIFY LOCATION
 OF UTILITIES PRIOR TO DIGGING.
 TEXAS ONE CALL: 1-800-245-4545

- LEGEND**
- Proposed R.O.W.
 - - - Existing Curb
 - - - Proposed Curb
 - XXXXXXXXXX Existing Storm Sewer Line
 - Proposed Storm Sewer Line
 - Flow Arrow
 - - - Existing Water Line
 - - - Proposed Water Line
 - W - W - Proposed Water Service
 - - - Existing Sanitary Sewer Line
 - - - Proposed Sanitary Sewer Line
 - ← S ← S ← Proposed 6" Sanitary Sewer Service
 - Existing Duct Bank
 - Existing Single Phase Overhead Primary
 - Existing Three Phase Underground Primary
 - Proposed 6E6 Duct Bank
 - Existing 4-Way Manhole
 - Proposed 4-Way Manhole


BENCHMARK:
 "D" CUT ON EAST SIDE OF 6" INLET NORTH SIDE
 OF MORRIS AVENUE, 200' +/- EAST OF THE
 CENTERLINE OF QUORUM DRIVE.
 ELEVATION: 616.41

SANITARY SEWER PLAN
PARKVIEW AT ADDISON CIRCLE
TOWN OF ADDISON, TEXAS
DALLAS COUNTY

BRACKETT & DAVIS · DRAKE, inc.
 consulting engineers
 Civil & Structural Engineering · Surveying
 4144 North Central Expressway, Suite 1100 Dallas, Texas 75204
 (214) 824-3647, fax (214) 824-7064

DESIGNED	DRAWN	DATE	SCALE	NOTES	FILE	NO.
RRJ	BDD	04/04	1"=40'	BDD	C03393	C17

AS-BUILT
NOVEMBER 4, 2004

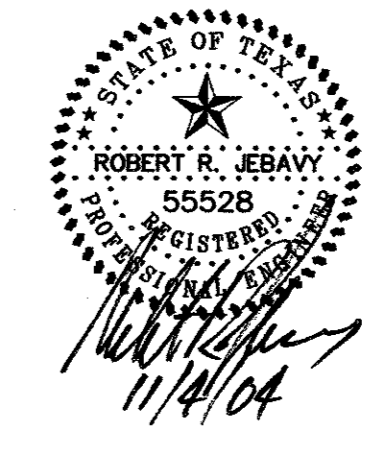

NOTE:
 THESE PLANS HAVE BEEN REVISED
 TO CONFORM WITH CONSTRUCTION
 RECORDS PROVIDED BY CONTRACTOR.

Copyright 2004 Brockett & Davis Drake, Inc. All Rights Reserved.
 This drawing is the property of Brockett & Davis Drake, Inc.
 Any modification or use of this drawing without the express
 written authorization of Brockett & Davis Drake, Inc. is prohibited.