


LEGEND

- Proposed R.O.W.
- Existing Curb
- Proposed Curb
- XXXXXXX Existing Storm Sewer Line
- ==== Proposed Storm Sewer Line
- Flow Arrow
- Existing Water Line
- Proposed Water Line
- W - W - Proposed Water Service
- Existing Sanitary Sewer Line
- Proposed Sanitary Sewer Line
- S - S - Proposed Sanitary Sewer Service
- Existing Duct Bank
- Existing Single Phase Overhead Primary
- Existing Three Phase Underground Primary
- Proposed 6E6 Duct Bank
- Existing 4-Way Manhole
- ◇ Proposed 4-Way Manhole

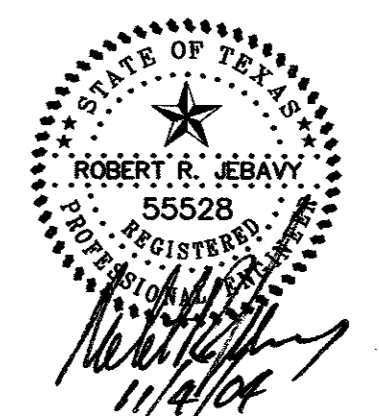

AS-BUILT
NOVEMBER 4, 2004

NOTE:
THESE PLANS HAVE BEEN REVISED
TO CONFORM WITH CONSTRUCTION
RECORDS PROVIDED BY CONTRACTOR.

BENCHMARK:
"D" CUT ON EAST SIDE OF 6" INLET NORTH SIDE
OF MORRIS AVENUE, 200' +/- EAST OF THE
CENTERLINE OF QUORUM DRIVE.
ELEVATION : 616.41

CAUTION!!!!
CONTRACTOR SHALL VERIFY LOCATION
OF UTILITIES PRIOR TO DIGGING.
TEXAS ONE CALL: 1-800-245-4545

DUCTBANK PLAN						
PARKVIEW AT ADDISON CIRCLE						
TOWN OF ADDISON, TEXAS						
DALLAS COUNTY						
BROCKETTE · DAVIS · DRAKE , inc. consulting engineers Civil & Structural Engineering · Surveying 4144 North Central Expressway, Suite 1100 Dallas, Texas 75204 (214)824-3647, fax (214) 824-7064						
DESIGNED	DRAWN	DATE	SCALE	NOTES	FILE	NO.
RRJ	BDD	04/04	1"=40'	BDD	C03393	C20

Copyright 2004 Brockette/Davis/Drake, Inc. All Rights Reserved.
 No part of this drawing may be reproduced, stored in a retrieval system,
 or transmitted in any form or by any means, electronic, mechanical,
 photocopying, recording, or by any information storage and retrieval system,
 without the express written authorization of Brockette/Davis/Drake, Inc. is prohibited.

C03393\PLANS CD\20-DBANK-PV