
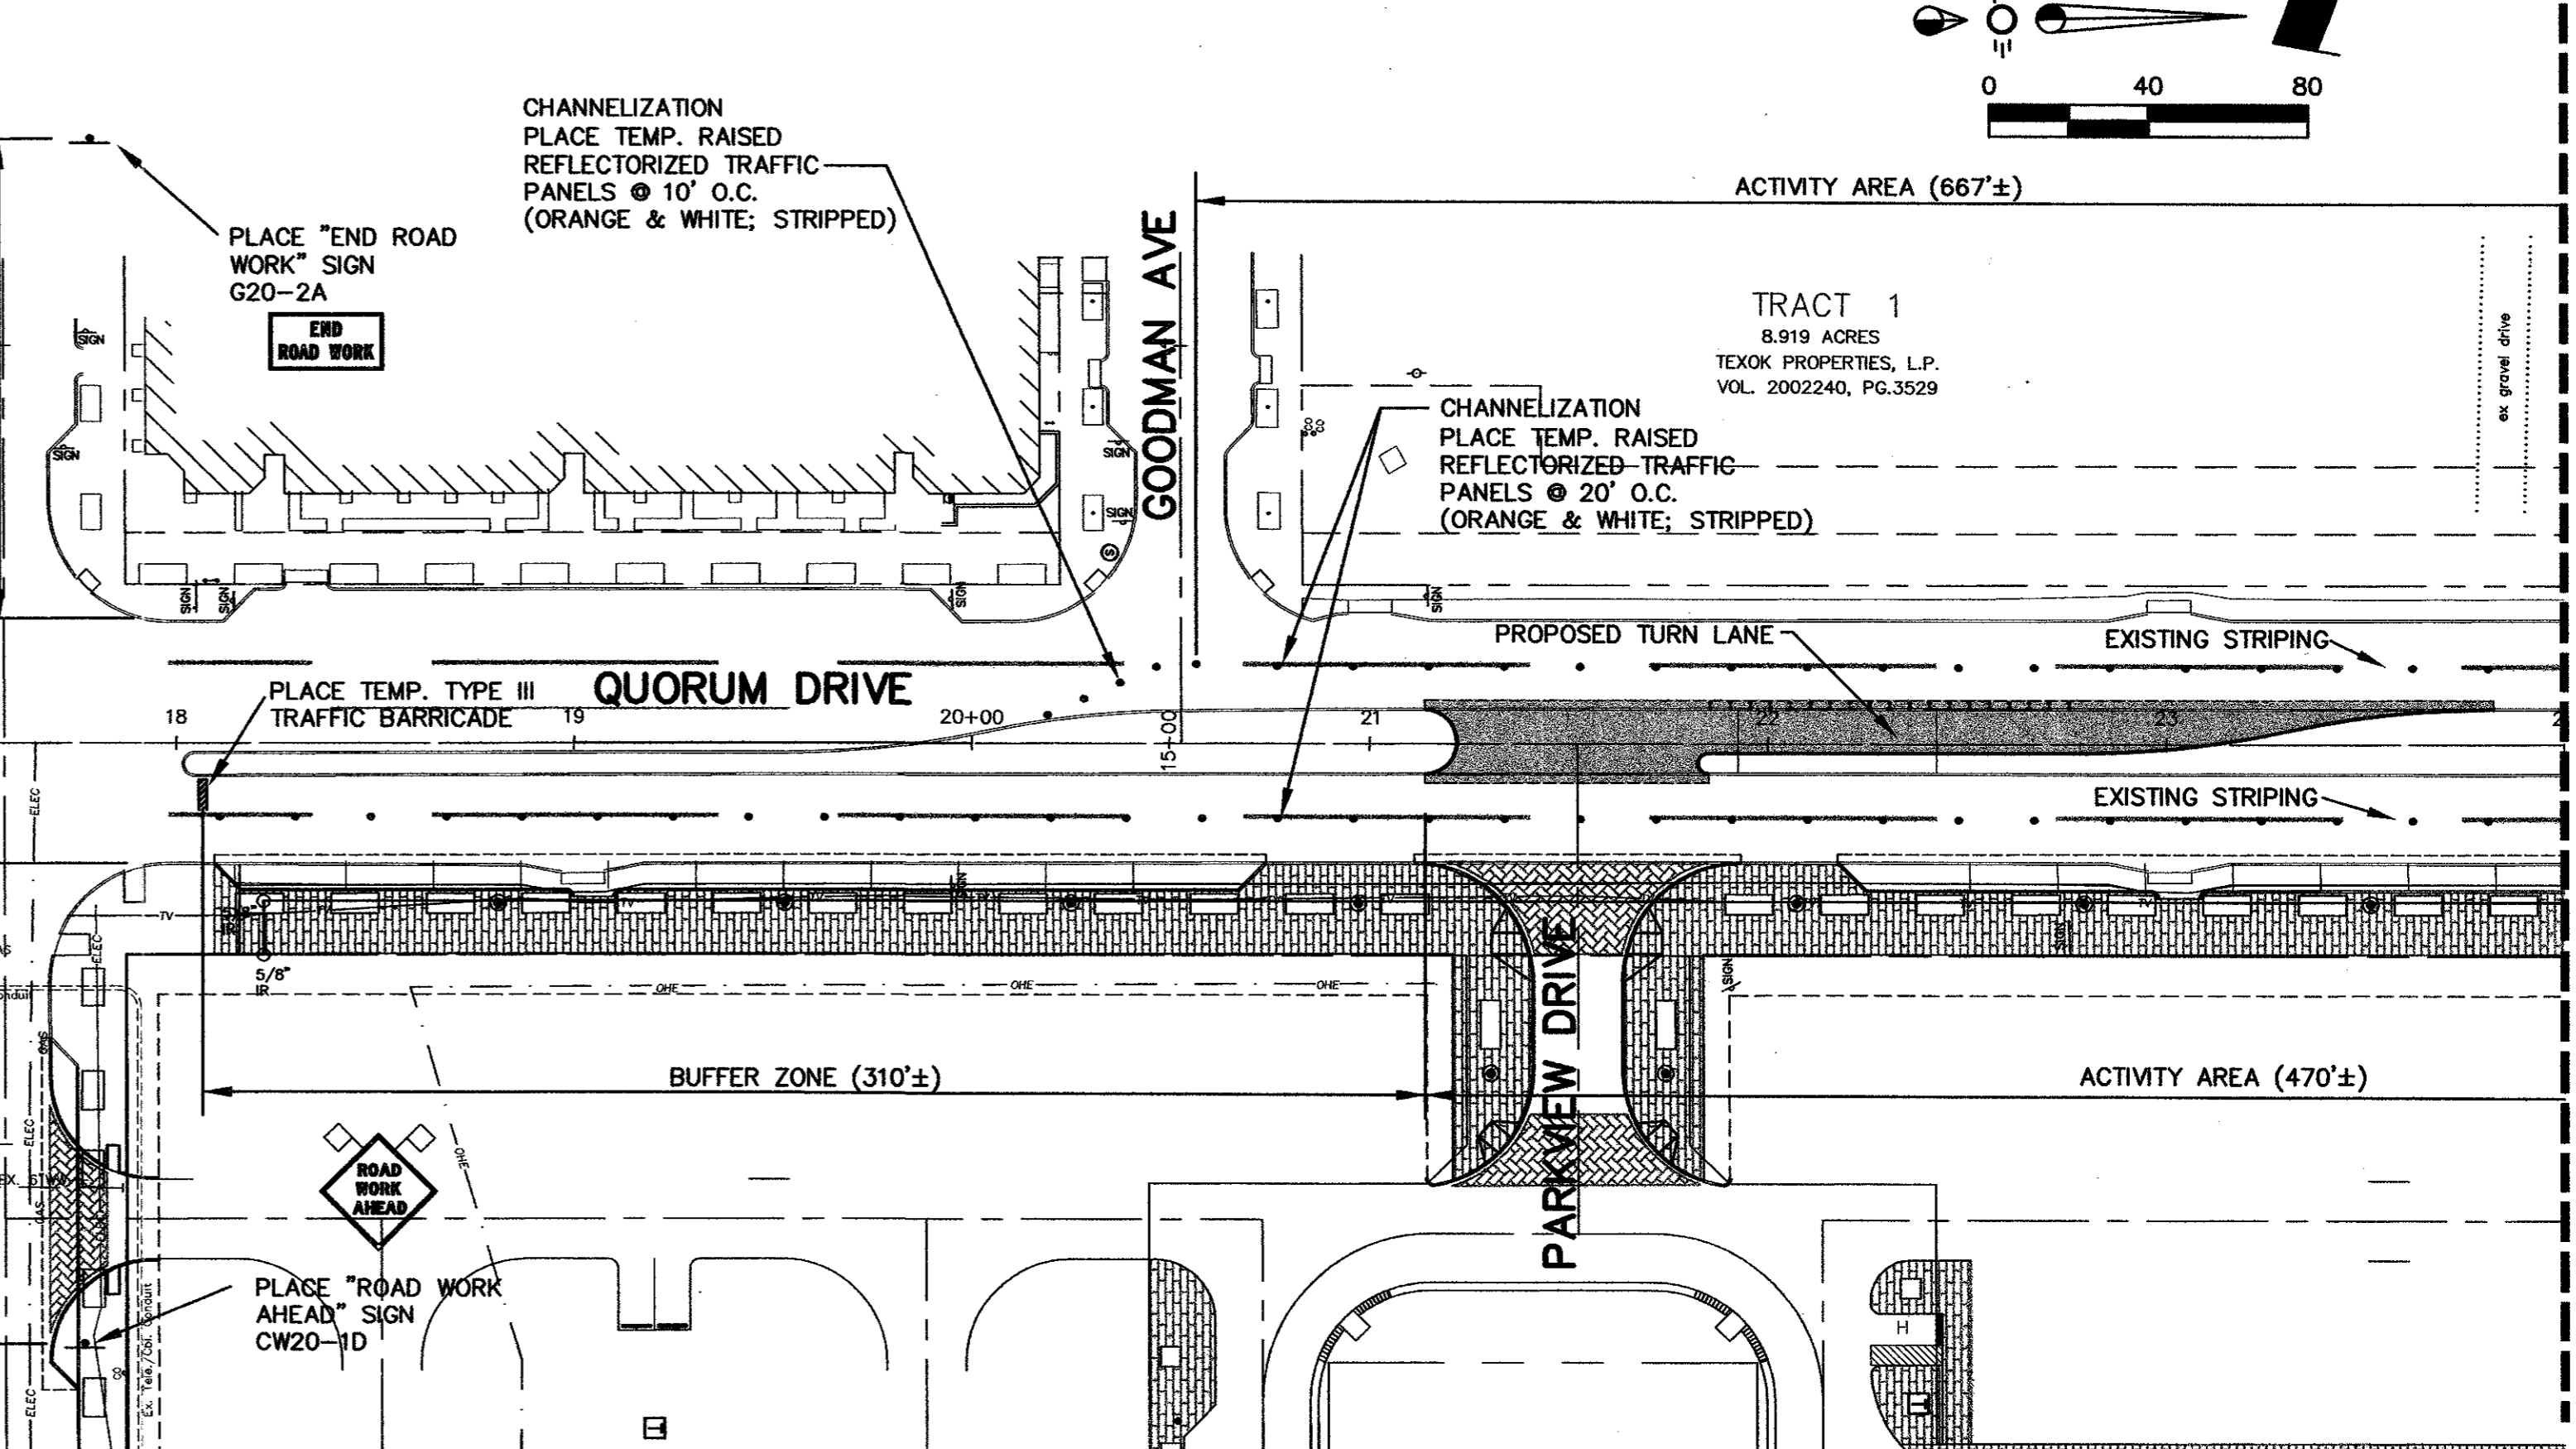
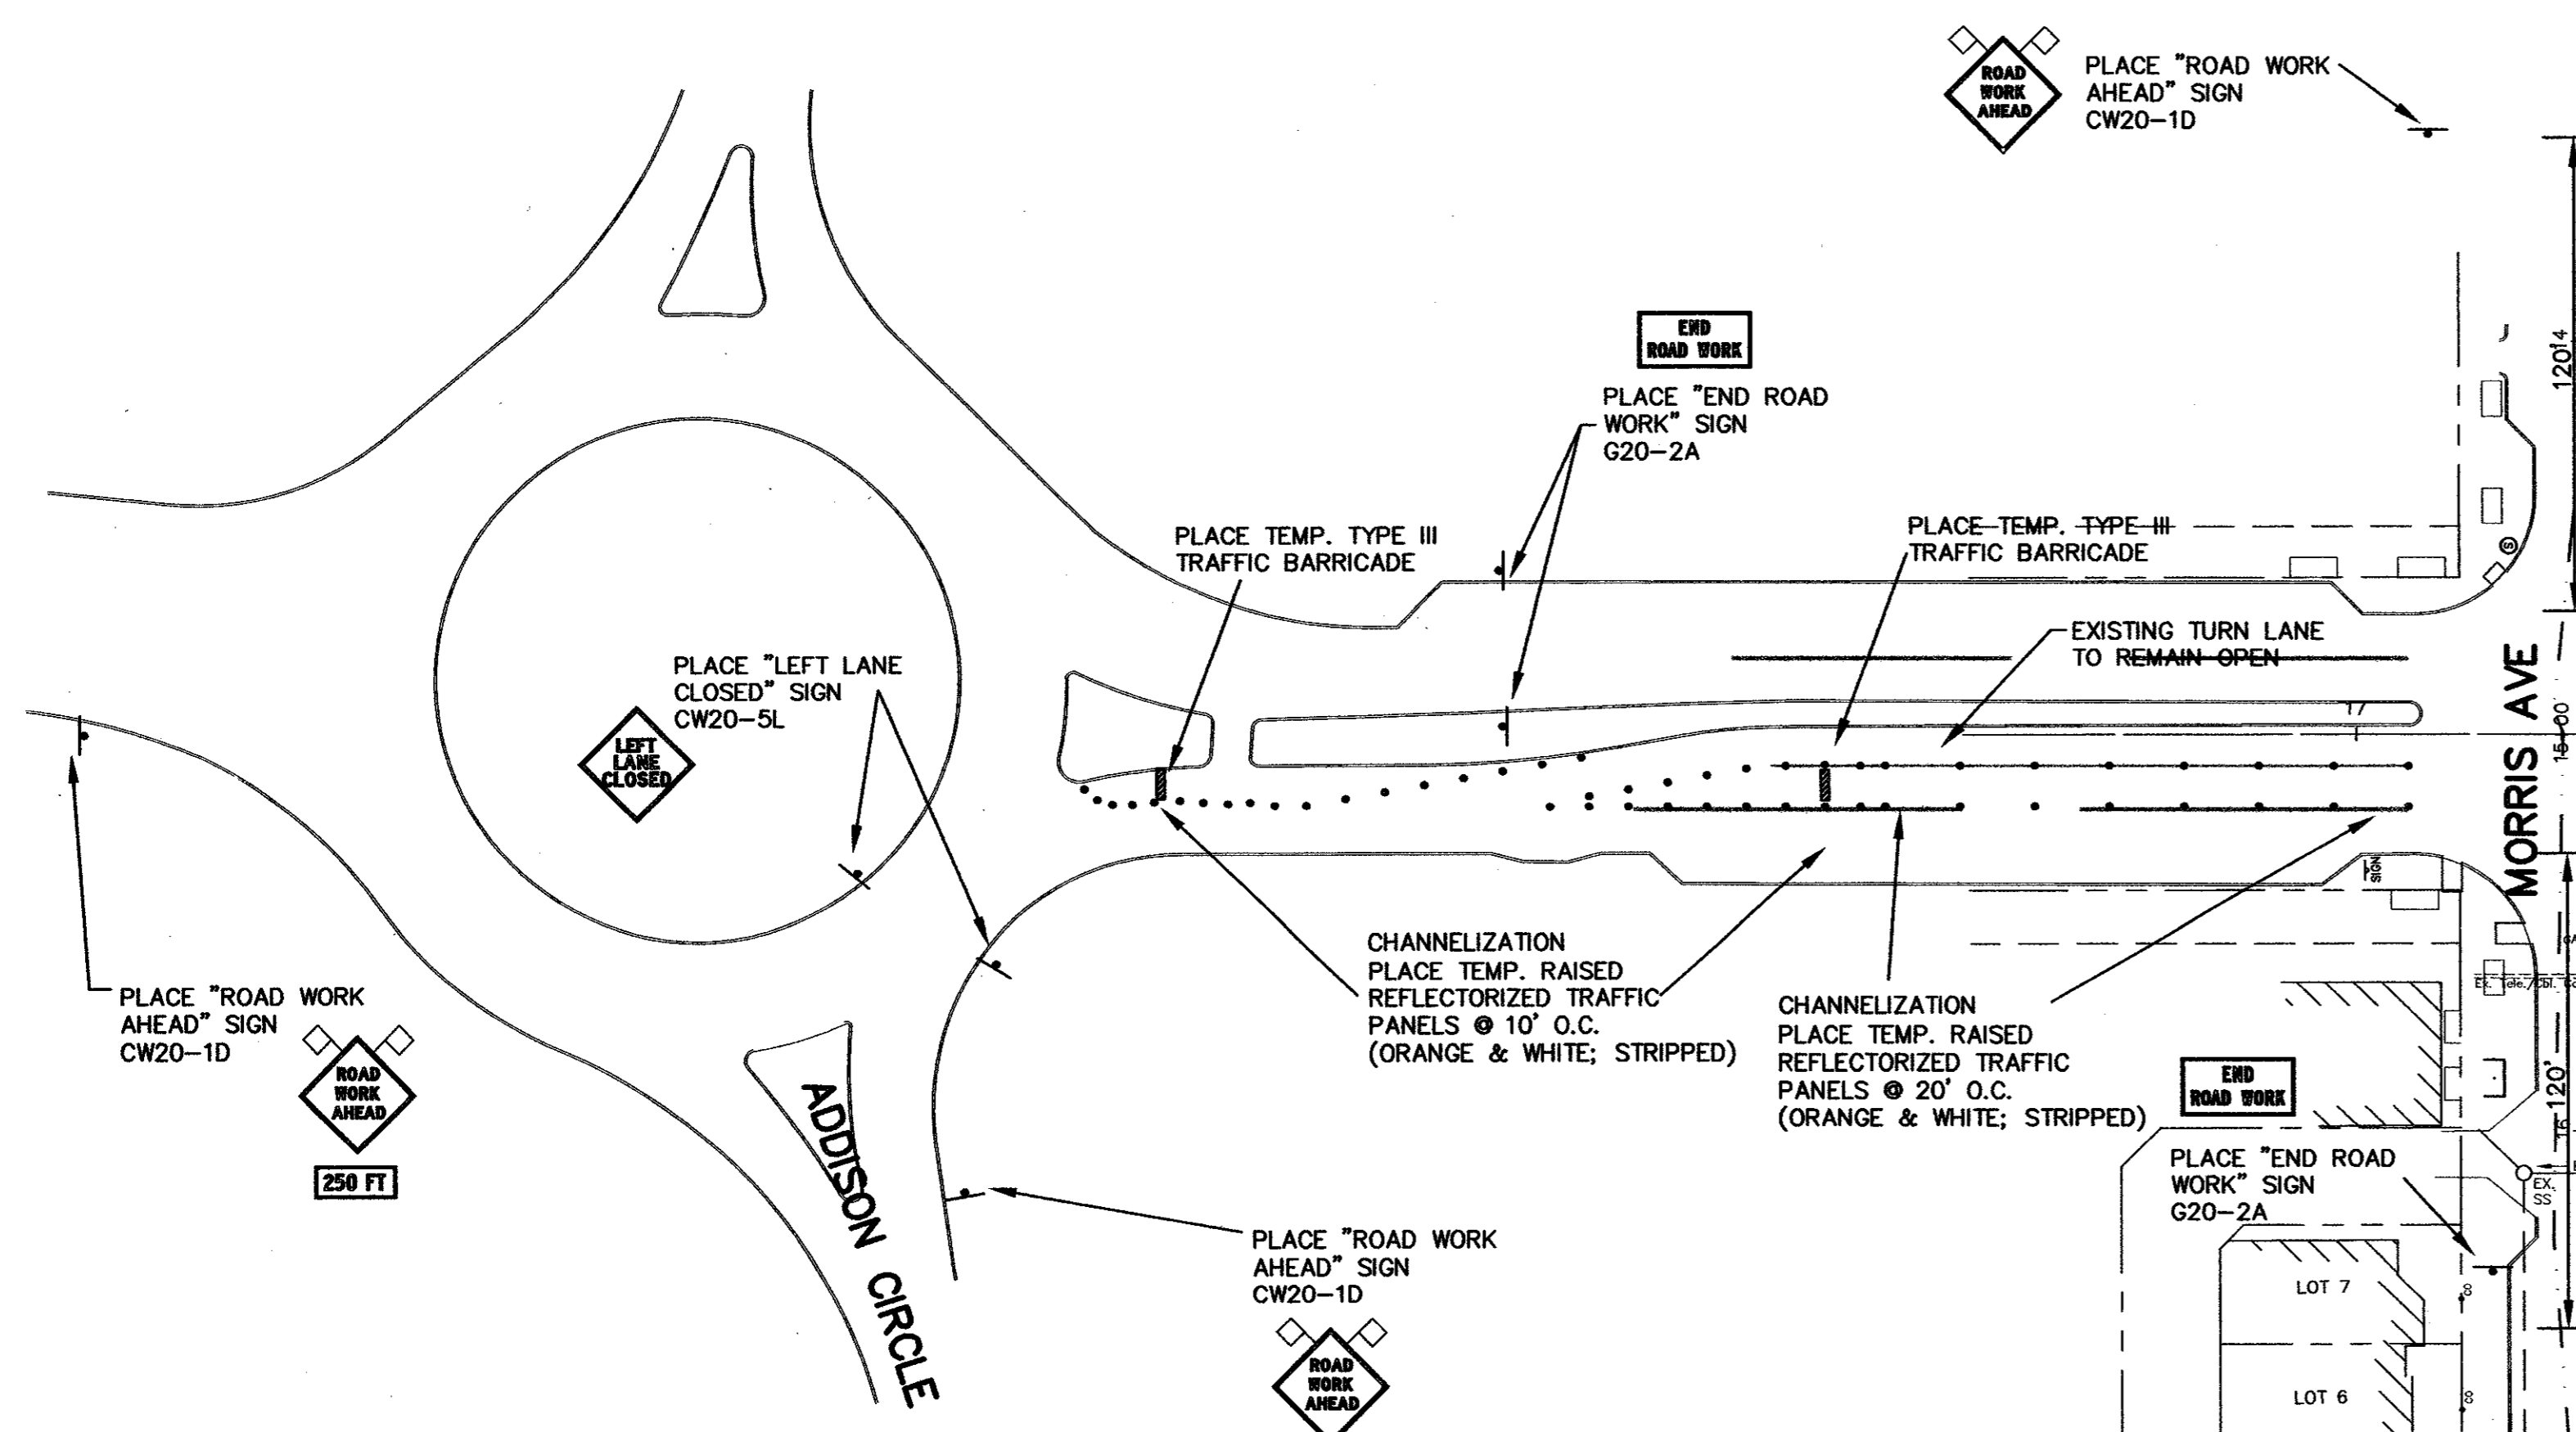
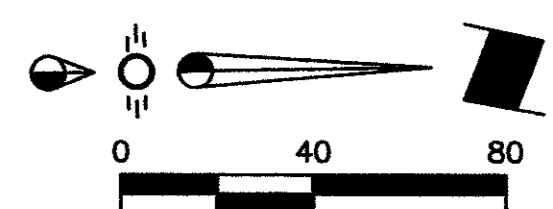
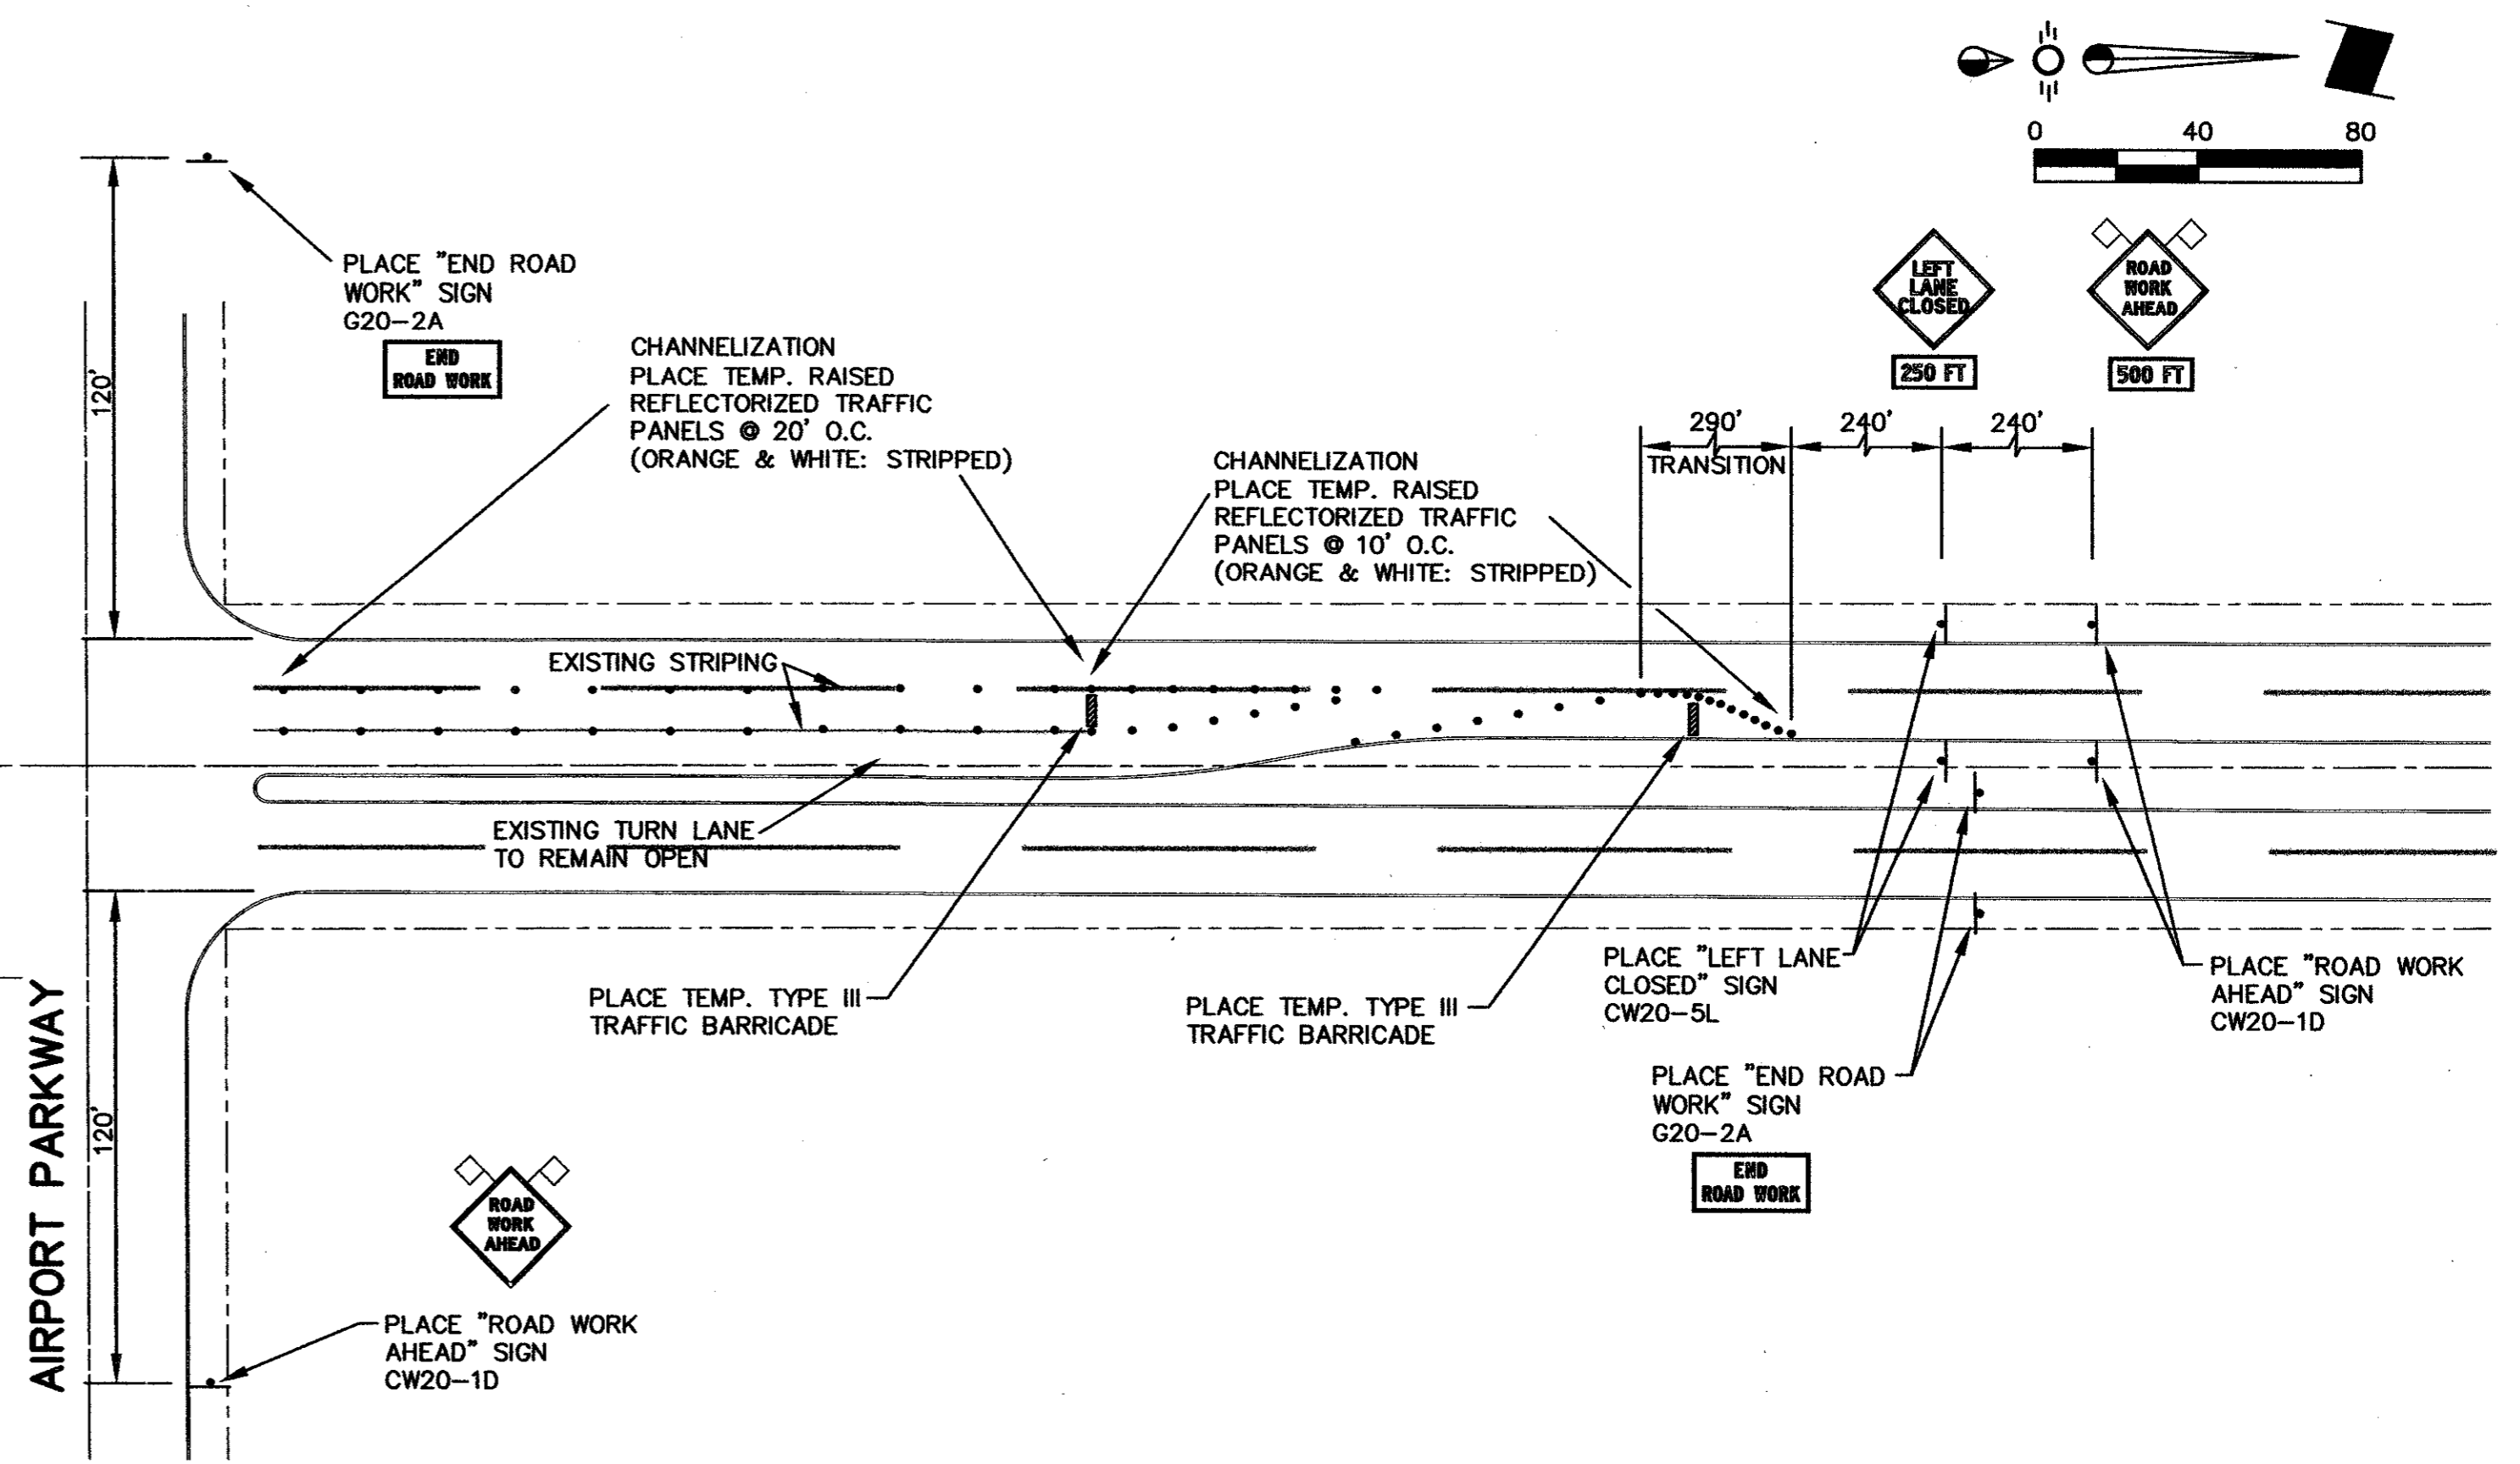
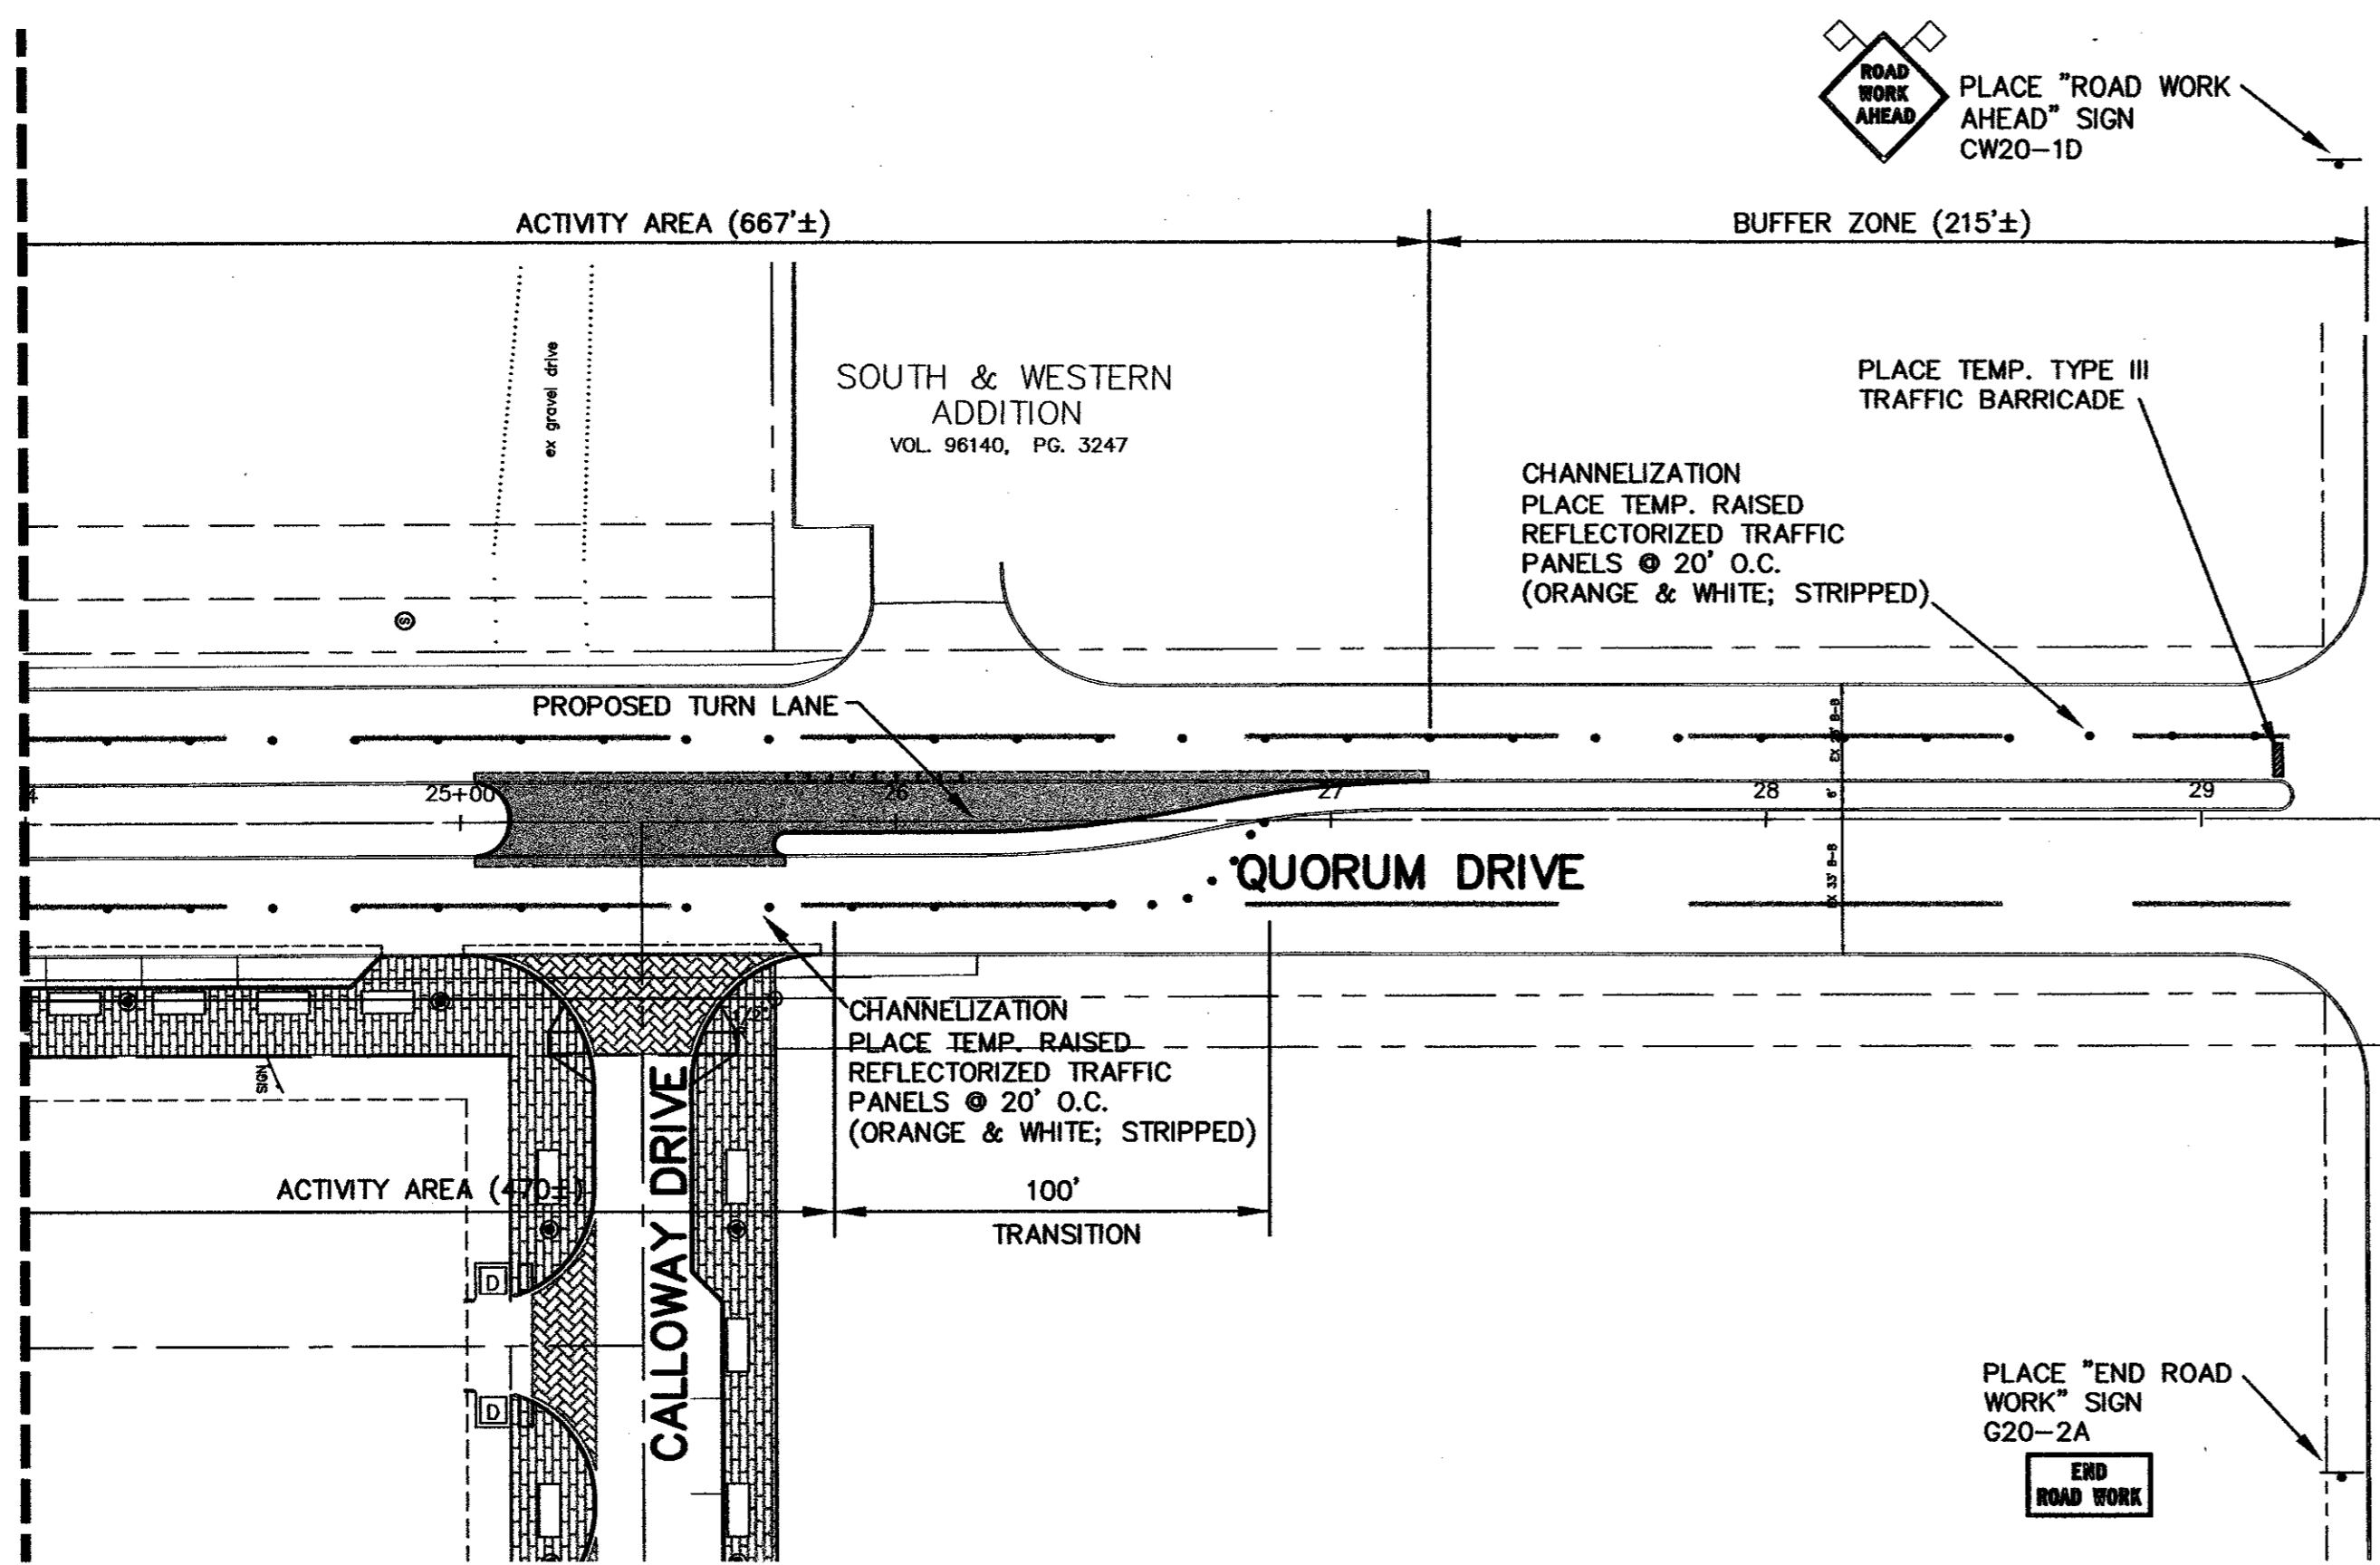



MATCH LINE

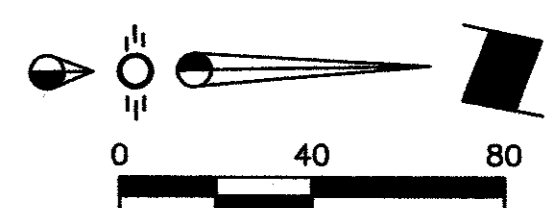

Copyright 2003 Brockett/Davis/Drake, Inc. All Rights Reserved. This drawing is the property of Brockett/Davis/Drake, Inc. and is not to be reproduced without written authorization of Brockett/Davis/Drake, Inc. is prohibited.

**AS-BUILT**  
NOVEMBER 4, 2004

NOTE:  
THESE PLANS HAVE BEEN REVISED TO CONFORM WITH CONSTRUCTION RECORDS PROVIDED BY CONTRACTOR.

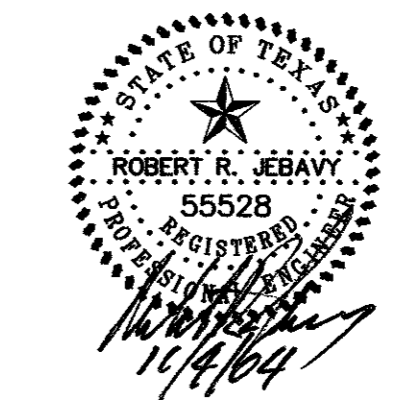

BENCHMARK:  
"D" CUT ON EAST SIDE OF 6" INLET NORTH SIDE OF MORRIS AVENUE, 200' +/- EAST OF THE CENTERLINE OF QUORUM DRIVE.  
ELEVATION : 616.41

NOTE:  
ALL ADA ACCESSIBLE ROUTES SHALL HAVE MAXIMUM 2% CROSS SLOPES AND MAXIMUM 5% LONGITUDINAL SLOPE.

**TRAFFIC CONTROL PLAN**  
PARKVIEW AT ADDISON CIRCLE  
TOWN OF ADDISON, TEXAS  
DALLAS COUNTY

**BROCKETTE · DAVIS · DRAKE, inc.**  
consulting engineers  
Civil & Structural Engineering, Surveying  
4144 North Central Expressway, Suite 1100 Dallas, Texas 75204  
(214)824-3647, fax (214) 824-7064

DESIGNED	DRAWN	DATE	SCALE	NOTES	FILE	NO.
RRJ	BDD	04/04	1"=40'	BDD	C03393	C23

C03393\PLANS CD\23-TRAFFIC\CONT QUOR DR-PV