


NOTE:  
THIS PLAN REFLECTS MINIMUM REQUIREMENTS ONLY, AND DOES NOT CONSTITUTE A STORM WATER POLLUTION PREVENTION PLAN. THE CONTRACTOR SHALL PROVIDE ADDITIONAL CONTROLS AS REQUIRED BY FIELD CONDITIONS AND CONSTRUCTION SCHEDULING. THE CONTRACTOR SHALL COMPLY FULLY WITH ANY APPLICABLE REQUIREMENTS AS ESTABLISHED IN THE CURRENT NPDES GENERAL PERMITS FOR STORM WATER DISCHARGES FROM CONSTRUCTION ACTIVITIES IN REGION 6.

NCTCOG PUBLISHES ACCEPTABLE CONTROLS IN A REFERENCE MANUAL ENTITLED "STORM WATER QUALITY BEST MANAGEMENT PRACTICES FOR CONSTRUCTION ACTIVITIES," AS REVISED JUNE, 1999. THIS MANUAL CAN BE OBTAINED THROUGH THE INTERNET AT [WWW.DFWSTORMWATER.COM/RUNOFF.HTML](http://WWW.DFWSTORMWATER.COM/RUNOFF.HTML).

**LEGEND**

- 620--- Existing Contour
- [20]--- Proposed Contour
- >--- Flow Arrow
- |--- Existing Curb
- |--- Proposed Curb
- XXXXXX Existing Storm Sewer Line
- ==== Proposed Storm Sewer Line
- |--- Silt Fence/Inlet Protection
- [ ]--- Construction Entrance

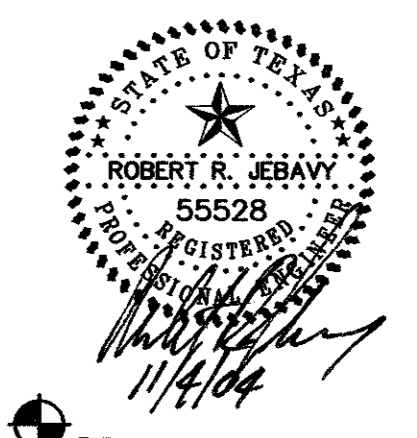

**AS-BUILT**  
**NOVEMBER 4, 2004**

NOTE:  
THESE PLANS HAVE BEEN REVISED TO CONFORM WITH CONSTRUCTION RECORDS PROVIDED BY CONTRACTOR.

BENCHMARK:  
"D" CUT ON EAST SIDE OF 6" INLET NORTH SIDE OF MORRIS AVENUE, 200' +/- EAST OF THE CENTERLINE OF QUORUM DRIVE.  
ELEVATION : 616.41

<b>EROSION CONTROL PLAN</b>						
PARKVIEW AT ADDISON CIRCLE						
TOWN OF ADDISON, TEXAS						
DALLAS COUNTY						
BROCKETTE · DAVIS · DRAKE , inc. consulting engineers Civil & Structural Engineering · Surveying 4144 North Central Expressway, Suite 1100, Dallas, Texas 75204 (214) 824-3647, fax (214) 824-7064						
DESIGNED	DRAWN	DATE	SCALE	NOTES	FILE	NO.
RRJ	BDD	04/04	1"=40'	BDD	C03393	C26

Copyright 2003 Broquette/Davis/Drake, Inc. All Rights Reserved.  
 This drawing is the property of Broquette/Davis/Drake, Inc.  
 Any modification or use of this drawing without the express  
 written authorization of Broquette/Davis/Drake, Inc. is prohibited.

TXU ELECTRIC COMPANY ESMT.  
VOL. 2000036, PG. 2913

C03393 PLANS C026-ERC-04