




**VEHICULAR BRICK INSTALLATION
IN VEHICULAR AREAS**

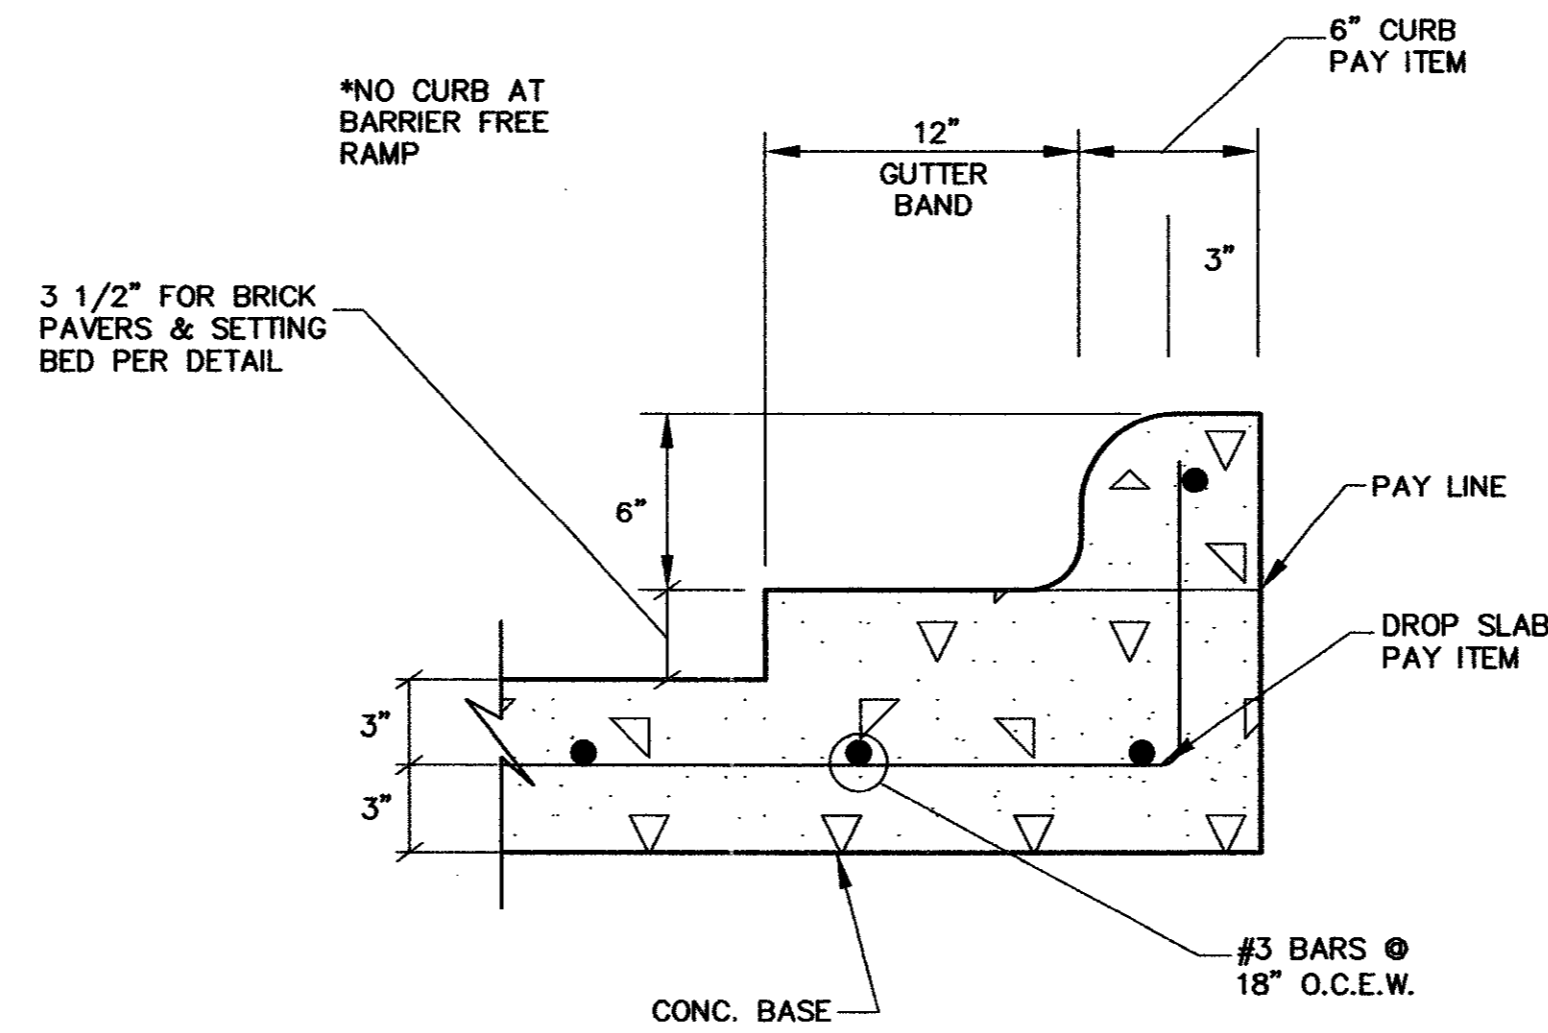


SECTION THRU CURB AT DROP SLAB
N.T.S.

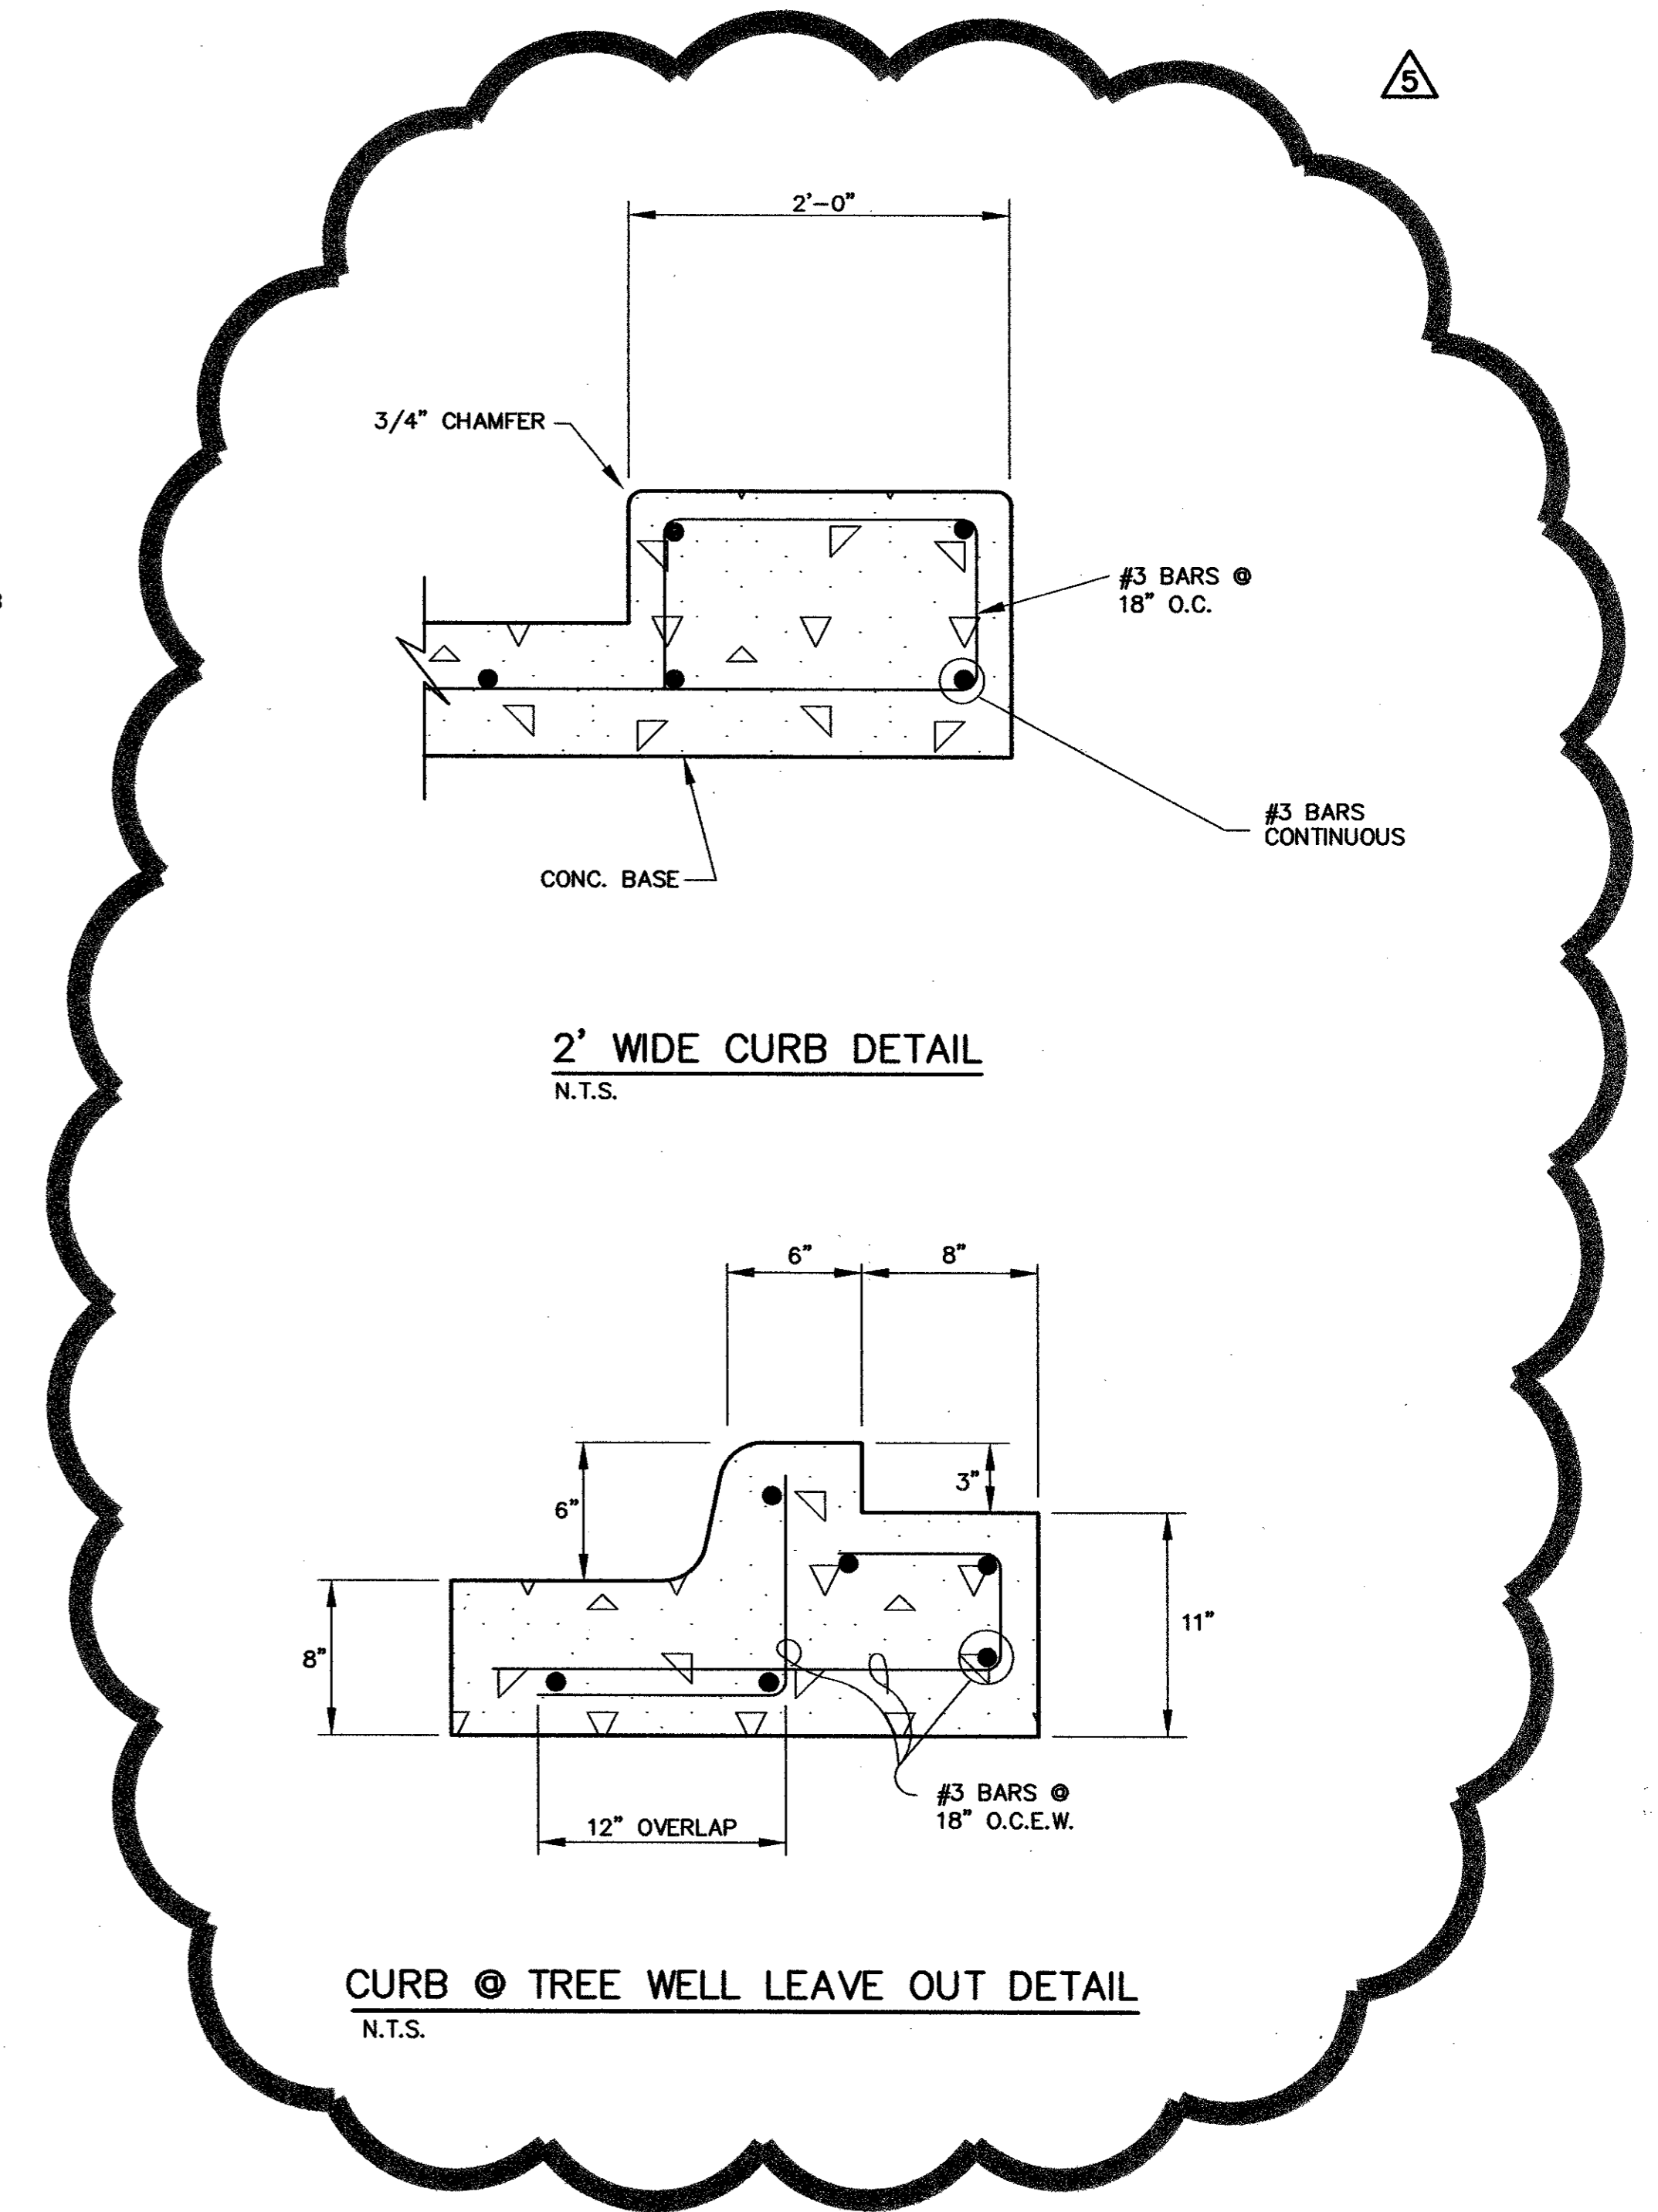

2' WIDE CURB DETAIL
N.T.S.

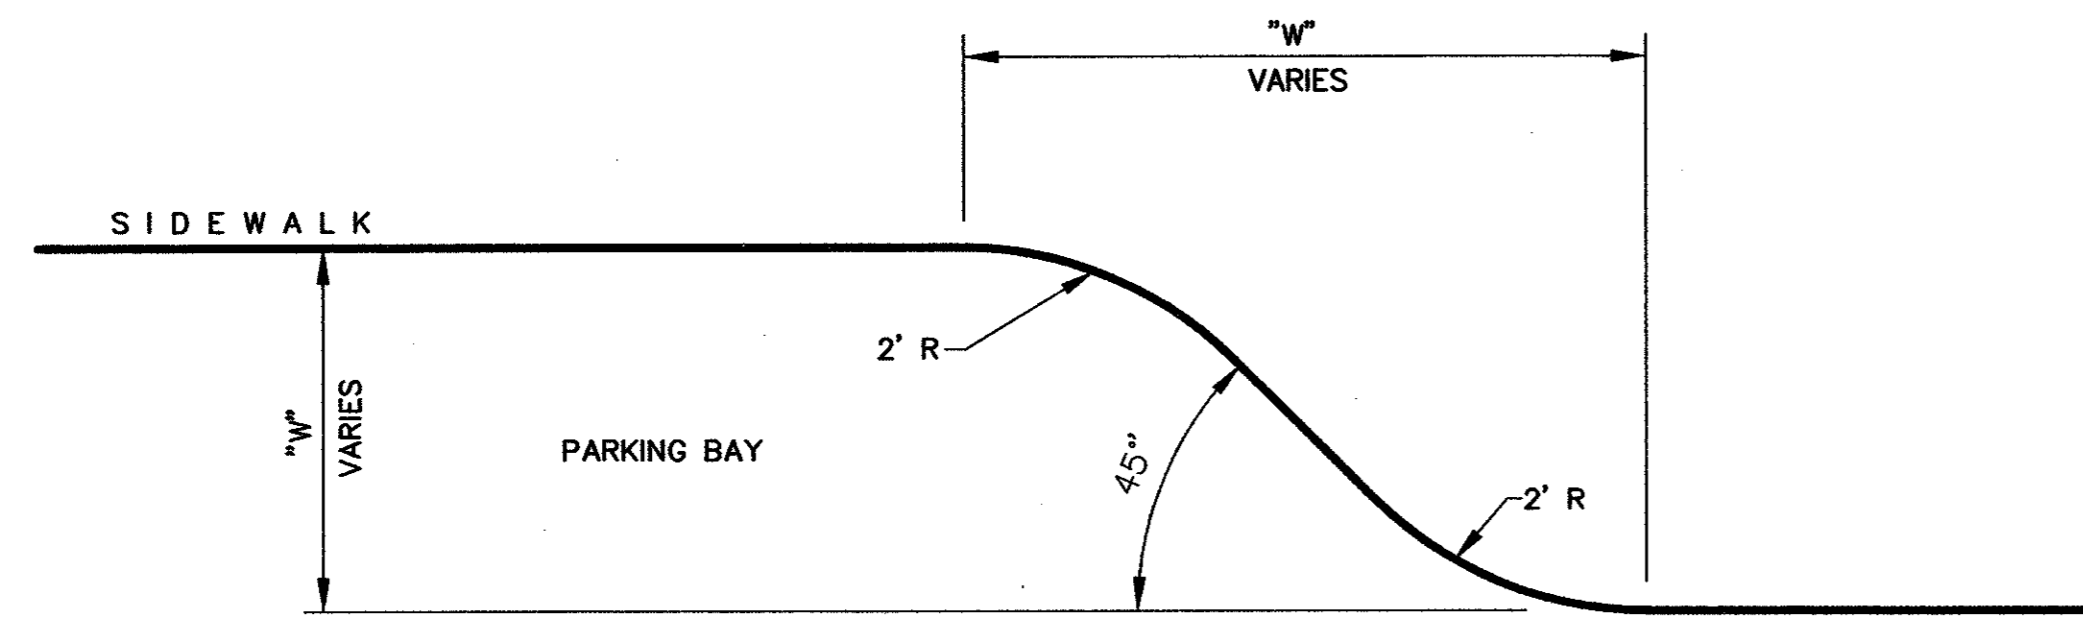

PARKING TRANSITION DETAIL
N.T.S.

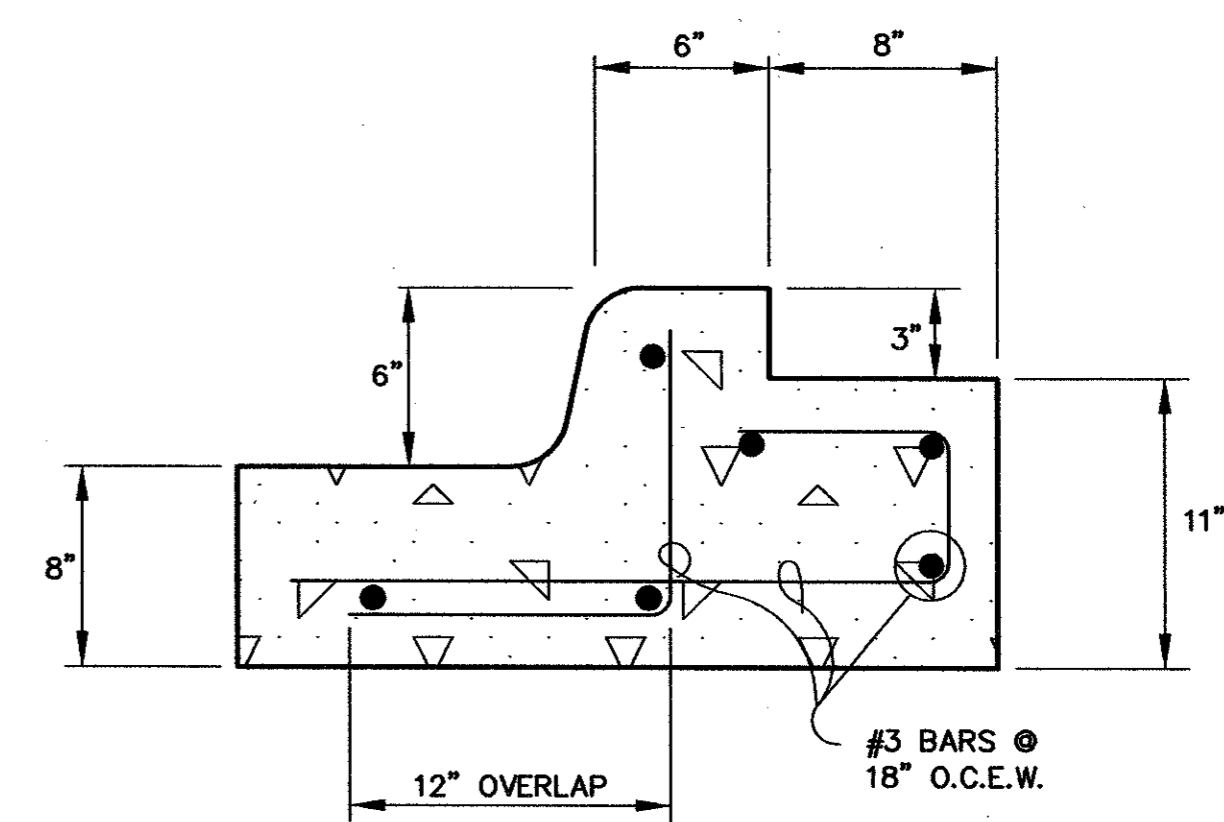


CURB @ TREE WELL LEAVE OUT DETAIL
N.T.S.

© Copyright 2003 Brockett/Davis/Drake, Inc. All Rights Reserved.
 Any modification or use of this drawing without the express
 written authorization of Brockett/Davis/Drake, Inc. is prohibited.

AS-BUILT
NOVEMBER 4, 2004

NOTE:
THESE PLANS HAVE BEEN REVISED
TO CONFORM WITH CONSTRUCTION
RECORDS PROVIDED BY CONTRACTOR.

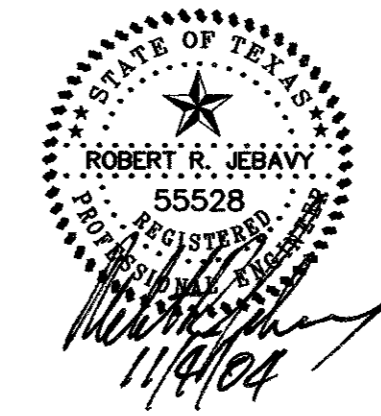

NOTE:
ALL ADA ACCESSIBLE ROUTES SHALL HAVE
MAXIMUM 2% CROSS SLOPES AND MAXIMUM
5% LONGITUDINAL SLOPE.

| PAVING DETAILS | | | | | | |
|---|-------|-------|----------|-------|--------|-----|
| PARKVIEW AT ADDISON CIRCLE | | | | | | |
| TOWN OF ADDISON, TEXAS | | | | | | |
| DALLAS COUNTY | | | | | | |
| BROCKETTE · DAVIS · DRAKE , inc. consulting engineers Civil & Structural Engineering · Surveying 4144 North Central Expressway, Suite 1100 Dallas, Texas 75204 (214)824-3647, fax (214) 824-7064 | | | | | | |
| DESIGNED | DRAWN | DATE | SCALE | NOTES | FILE | NO. |
| RRJ | BDD | 04/04 | AS SHOWN | BDD | C03393 | C29 |

C03393\PLANS CD\29-PAV-DET5-PVDWG