


SANITARY SEWER SERVICE CONNECTION
N.T.S.

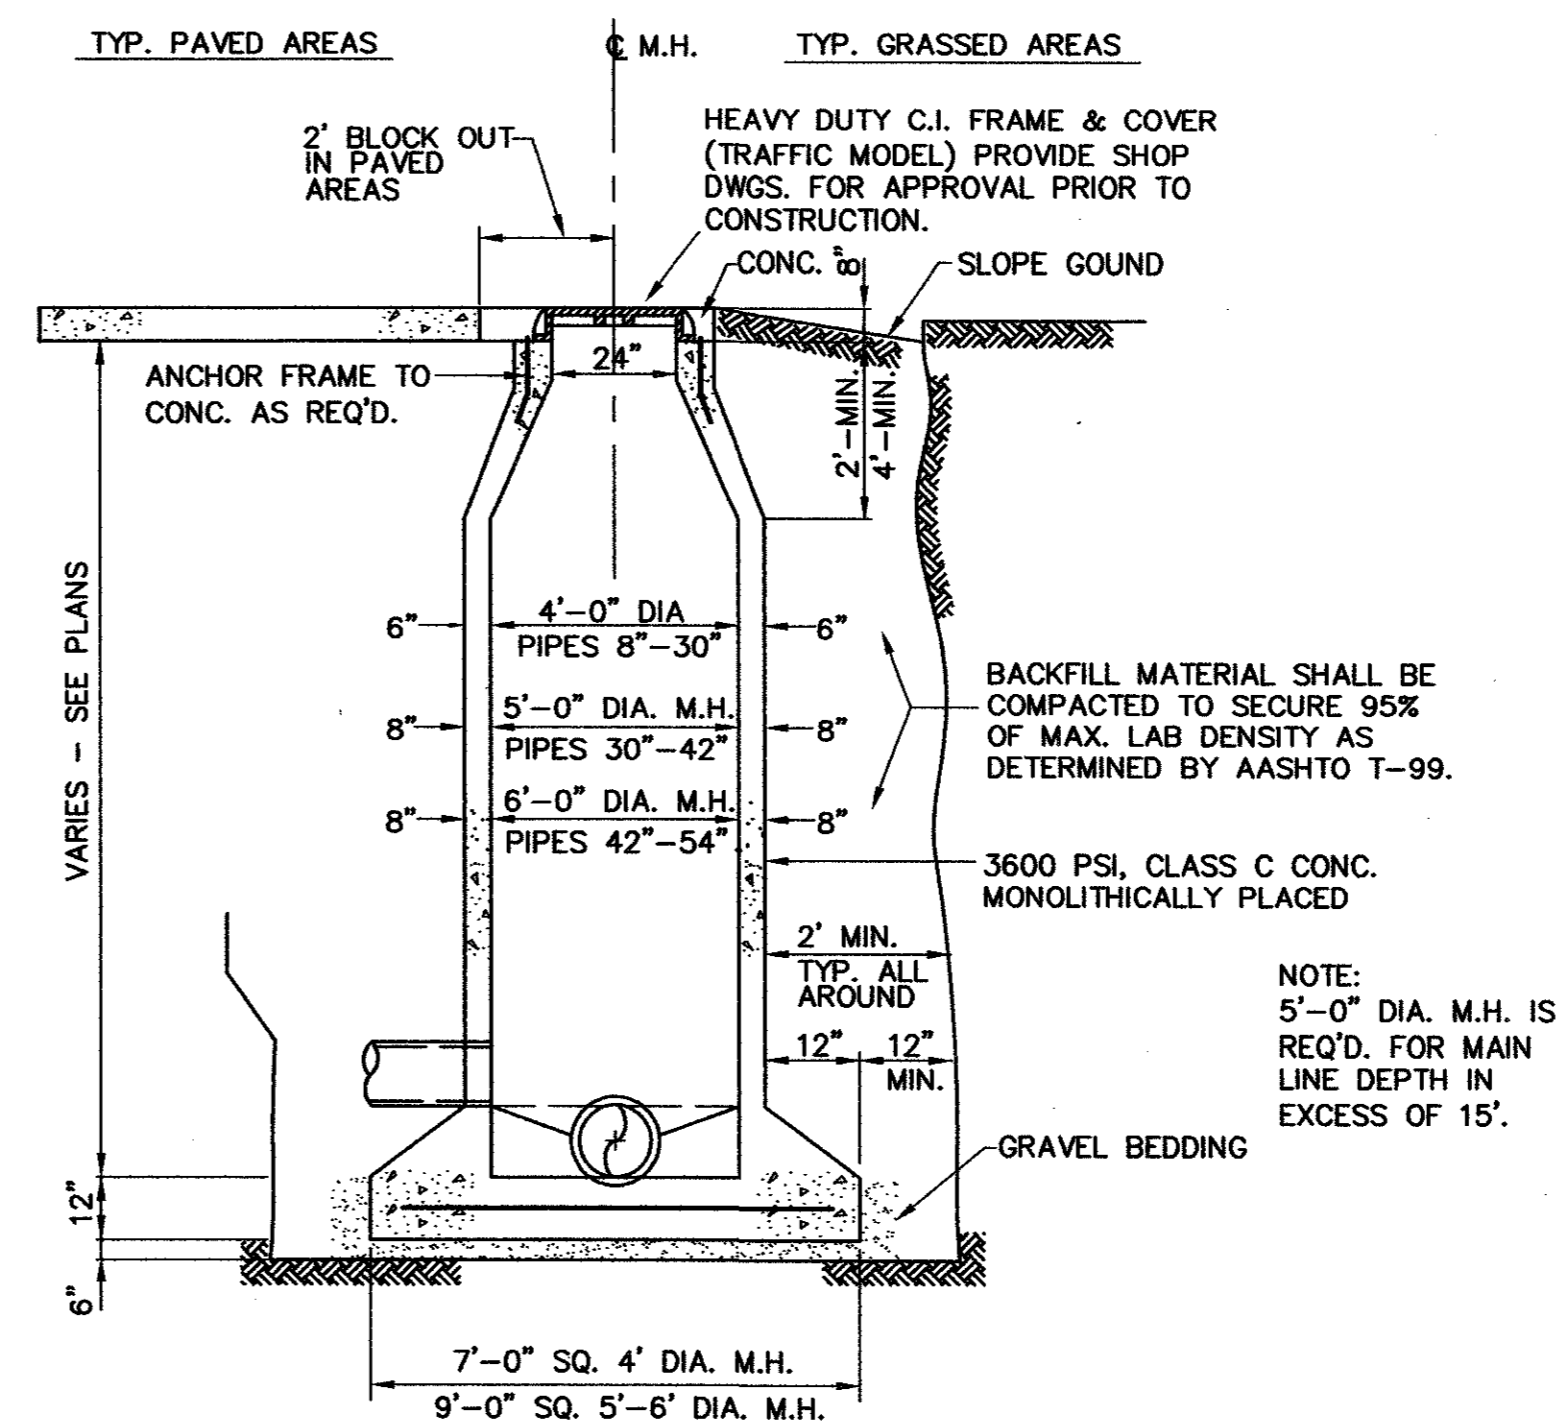


CAST-IN-PLACE MANHOLE
N.T.S.

WHERE DROP M.H. IS REQ'D. USE INSIDE DROP CONNECTION AS PER TOWN OF ADDISON STANDARDS.

AS-BUILT
NOVEMBER 4, 2004

NOTE: THESE PLANS HAVE BEEN REVISED TO CONFORM WITH CONSTRUCTION RECORDS PROVIDED BY CONTRACTOR.

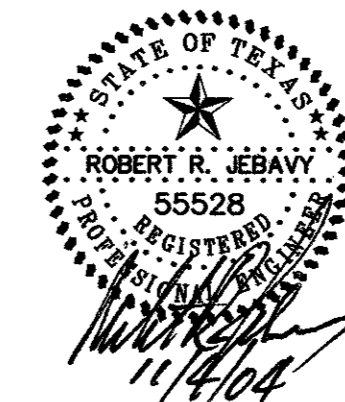

WASTEWATER DETAILS

PARKVIEW AT ADDISON PLACE

TOWN OF ADDISON, TEXAS

DALLAS COUNTY

BROCKETTE · DAVIS · DRAKE, inc.
consulting engineers

Civil & Structural Engineering · Surveying
4144 North Central Expressway, Suite 1100 Dallas, Texas 75204
(214)824-3647, fax (214) 824-7064

DESIGNED	DRAWN	DATE	SCALE	NOTES	FILE	NO.
RRJ	BDD	04/04	AS SHOWN	BDD	C03393	C34