




15 - 5" OR 6"
TERMINATOR INSTALLATION
IN MANHOLES
SEE JOB SKETCH FOR
NUMBER OF TERMINATORS
TO BE INSTALLED
DETAIL # 8

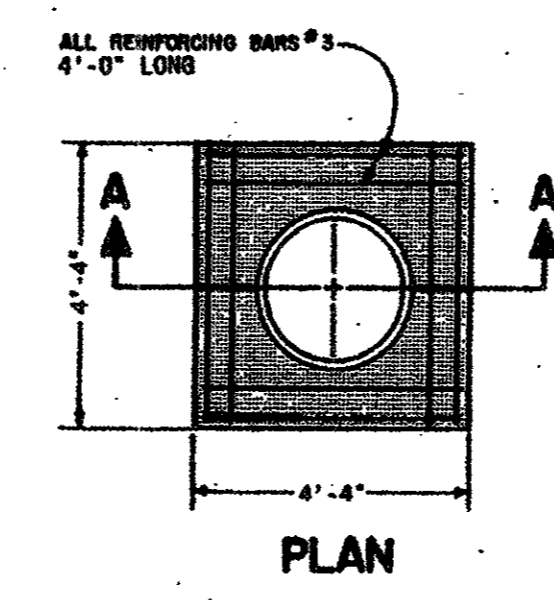

PLAN
SECTION A-A
NOTE: SEE DETAIL # 10 FOR CONCRETE SPECIFICATION
1" CHAMFER
MANHOLE FRAME & COVER
— CONCRETE SLAB FOR MANHOLE—
CASTING
DETAIL # 11

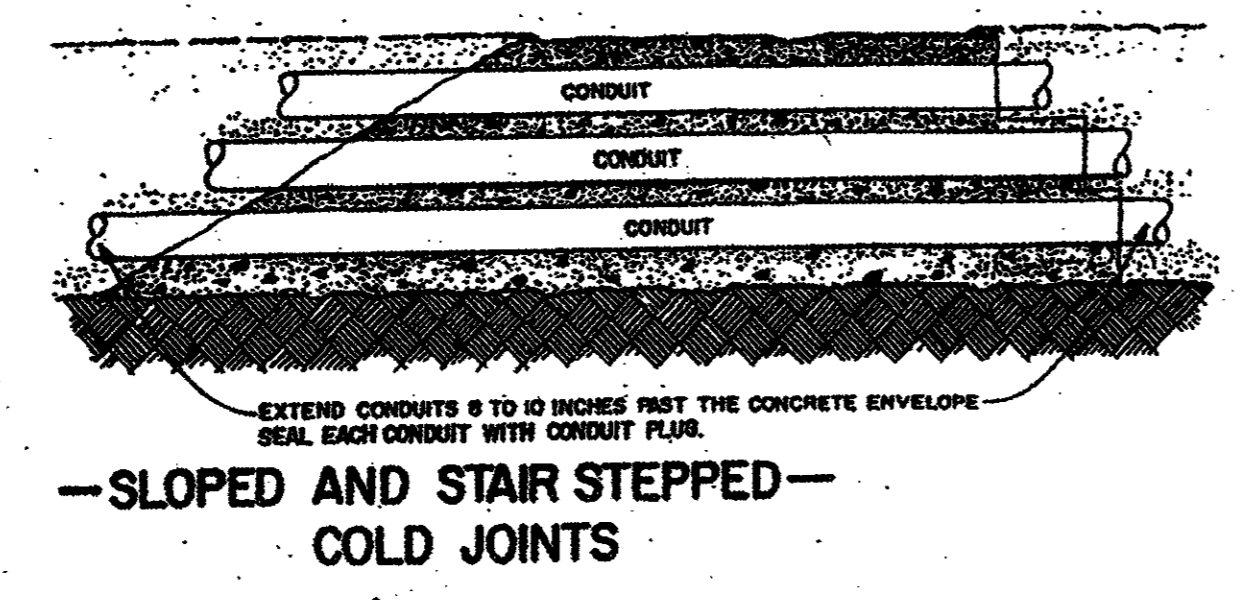

DETAIL # 24

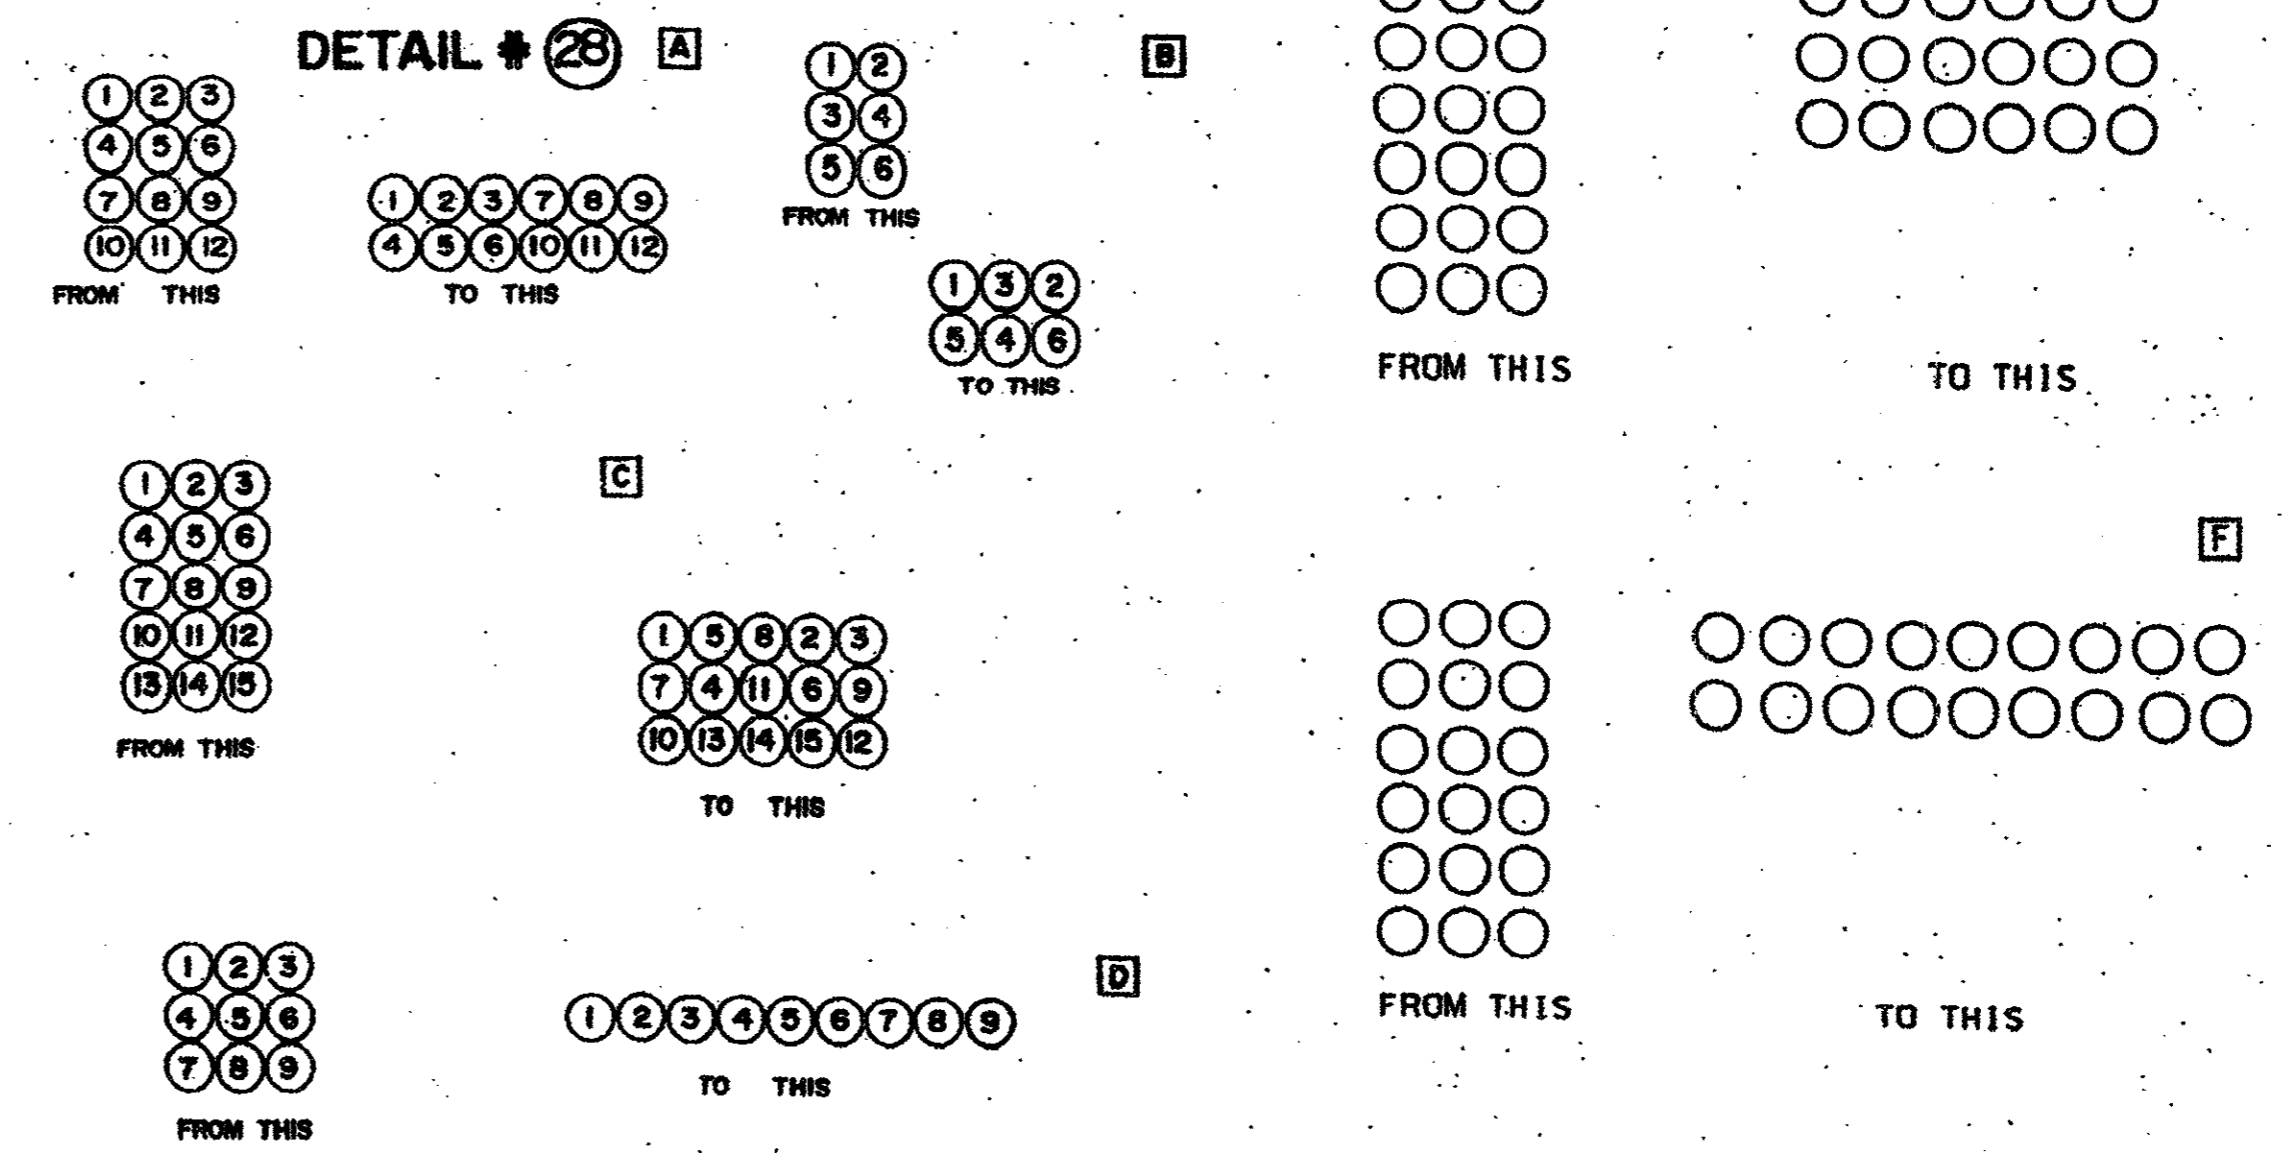

CONDUIT TRANSITION DETAILS

AS-BUILT
NOVEMBER 4, 2004

NOTE:
THESE PLANS HAVE BEEN REVISED
TO CONFORM WITH CONSTRUCTION
RECORDS PROVIDED BY CONTRACTOR.

| | | | |
|---|----------------------|----------------|----------|
| TU ELECTRIC | | CD | |
| SCALE: (1"=10' SCALE) | LIST OF DRAWINGS | DATE: 05-12-92 | DATE |
| SCALE: (1"=40' SCALE) | W.A. | APP. JES | APP. PRN |
| ESTIMATE | REVISION DESCRIPTION | NO. | DATE |
| ENG TYPE | UNIT ID | CH. JRC | APP. CH. |
| | | | APP. |
| | | | APP. |
| NETWORK UNDERGROUND APPURTENANCE SHEETS MISCELLANEOUS DETAILS | | | |
| E-NUA-1 | | SHEET NO. | |

© Copyright 2003 Brockett/Davis/Traka, Inc. All Rights Reserved. This drawing is the property of Brockett/Davis/Traka, Inc. and its use without the written authorization of Brockett/Davis/Traka, Inc. is prohibited.