


NOTE:
ALL ADA ACCESSIBLE ROUTES SHALL HAVE MAXIMUM 2% CROSS SLOPES AND MAXIMUM 5% LONGITUDINAL SLOPE.

LEGEND

- 620 --- Existing Contour
- 620.0 Existing Spot Elevation
- 20 - Proposed Contour
- 20.0 Proposed Spot Elevation
- Flow Arrow
- Existing Curb
- - - Proposed Curb
- XXXXXXXXXX Existing Storm Sewer Line
- ===== Proposed Storm Sewer Line
- Existing Water Line
- - - Proposed Water Line
- Existing Sanitary Sewer Line
- - - Proposed Sanitary Sewer Line
- Valley Gutter

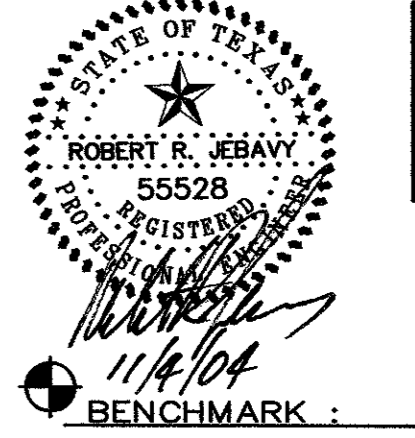

AS-BUILT
NOVEMBER 4, 2004

NOTE: THESE PLANS HAVE BEEN REVISED TO CONFORM WITH CONSTRUCTION RECORDS PROVIDED BY CONTRACTOR.

BENCHMARK:
"I" CUT ON EAST SIDE OF 6" INLET NORTH SIDE OF MORRIS AVENUE, 200' +/- EAST OF THE CENTERLINE OF QUORUM DRIVE.
ELEVATION: 616.41

GRADING PLAN
PARKVIEW AT ADDISON CIRCLE
TOWN OF ADDISON, TEXAS
DALLAS COUNTY

BRCKETTE · DAVIS · DRAKE, inc.
consulting engineers
Civil & Structural Engineering Surveying
4144 North Central Expressway, Suite 1100 Dallas, Texas 75204
(214) 824-3647, fax (214) 824-7064

DESIGNED	DRAWN	DATE	SCALE	NOTES	FILE	NO.
RRJ	BDD	4/04	1"=20'	BDD	C03393	C6

Copyright 2003 Brockette/Davis/Drake, Inc. All Rights Reserved. No part of this drawing may be reproduced, stored in a retrieval system, or used in any form without the express written authorization of Brockette/Davis/Drake, Inc. is prohibited.

C03393 PLANS CD 08-GR02-FV