


AS BUILT PLANS
FOR

TOWN HOMES OF ADDISON

ADDISON, TEXAS

PREPARED FOR:
ABSTRACT CONSTRUCTION, COMPANY
11157 ABLE LANE
DALLAS, TEXAS 72559

PRECISE LAND SURVEYING INC.,
4915 GUS THOMASSON ROAD
MESQUITE, TEXAS 75150
(972) 681-7072 FAX (972) 279-1508

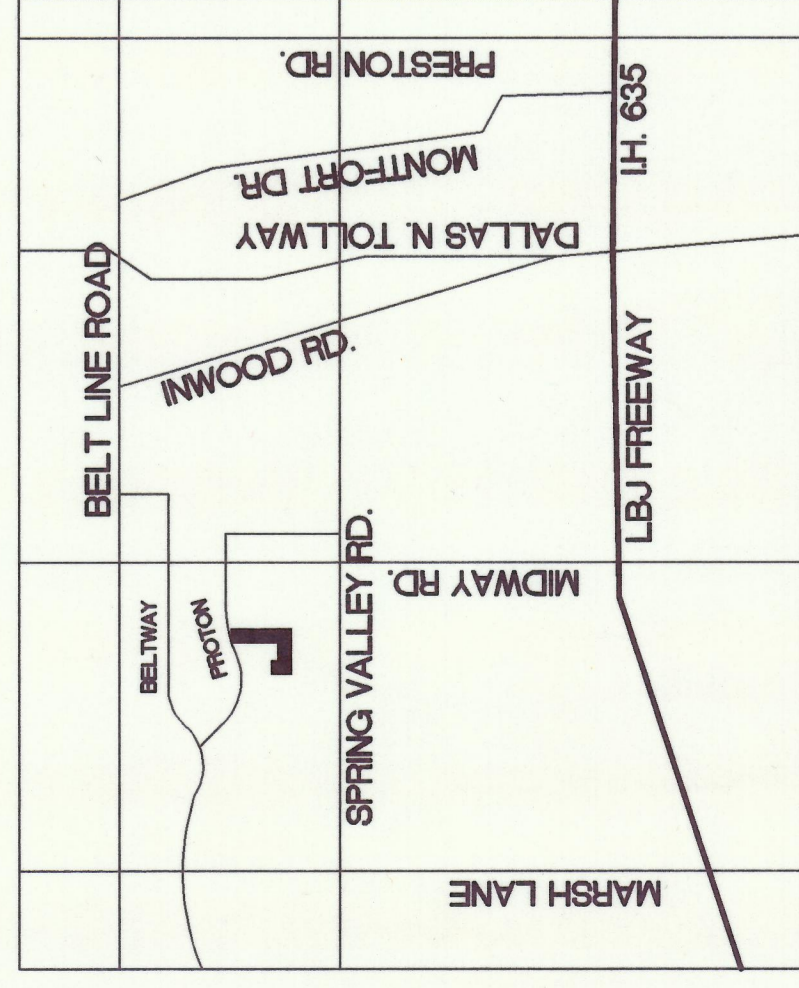

VICINITY MAP
NOT TO SCALE

| INDEX | SHEET NO. | DESCRIPTION |
|-------|-----------|----------------------------------|
| 1 | | COVER SHEET |
| AB | | AS-BUILT STREETS AND UTILITIES |
| 3 | | GRADING PLAN |
| 4 | | DRAINAGE AREA MAP |
| 5 | | OFF-SITE STORM SEWER |
| 6 | | WATER AND WASTEWATER |
| 7 | | STORM SEWER PROFILES |
| 8 | | STORM SEWER PROFILES |
| 9 | | SANITARY SEWER PROFILES |
| 10 | | SANITARY SEWER PROFILES |
| 11 | | PROTON DR. MODIFICATIONS |
| 12 | | EROSION CONTROL - <i>mutting</i> |
| 13 | | DETAILS |

NOTE:
CONSTRUCTION SHOWN ON PLAN SHEETS 3 THRU 13
IS AS-BUILT PER CONTRACTOR.

FEBRUARY, 1996