




LAT. A1

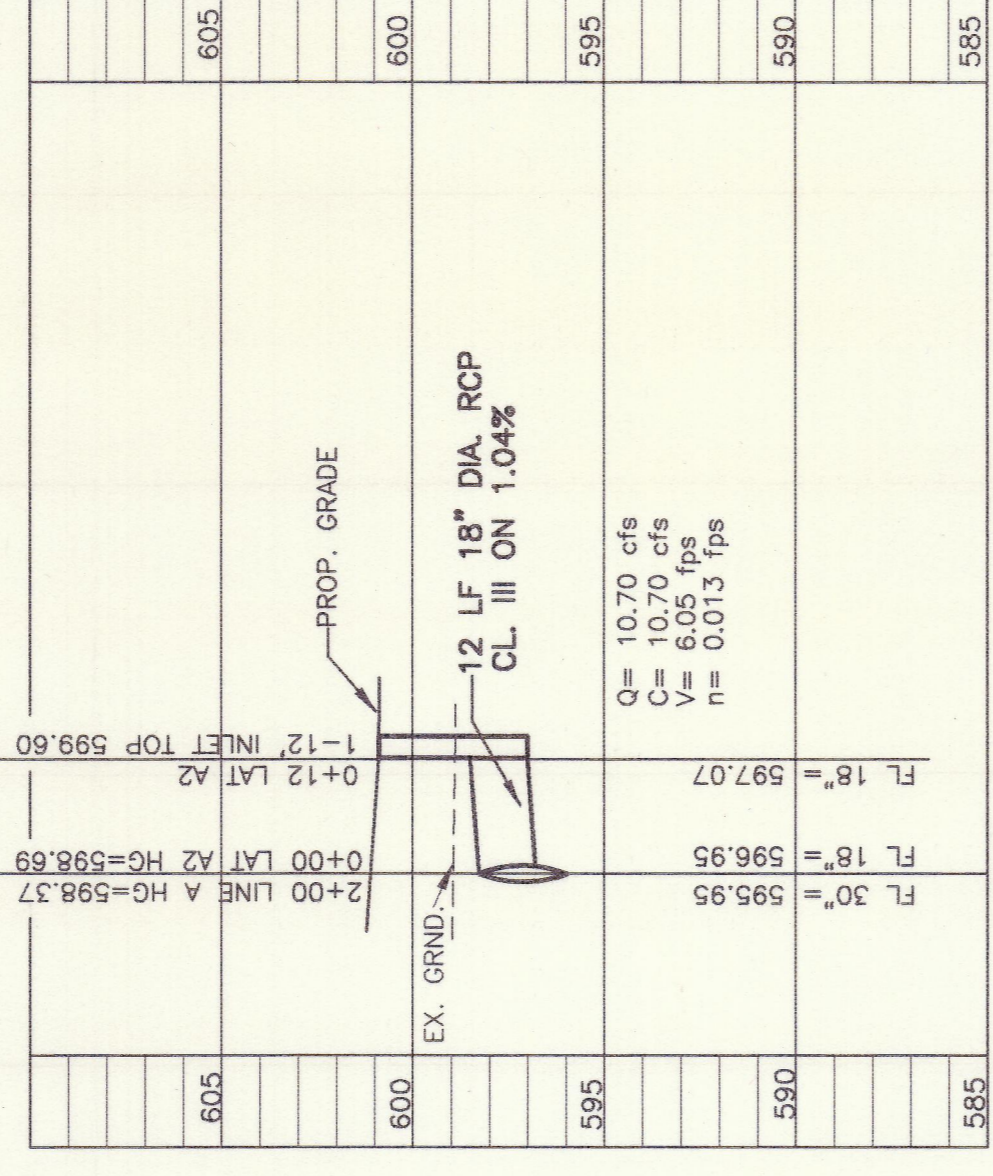


LAT. A2

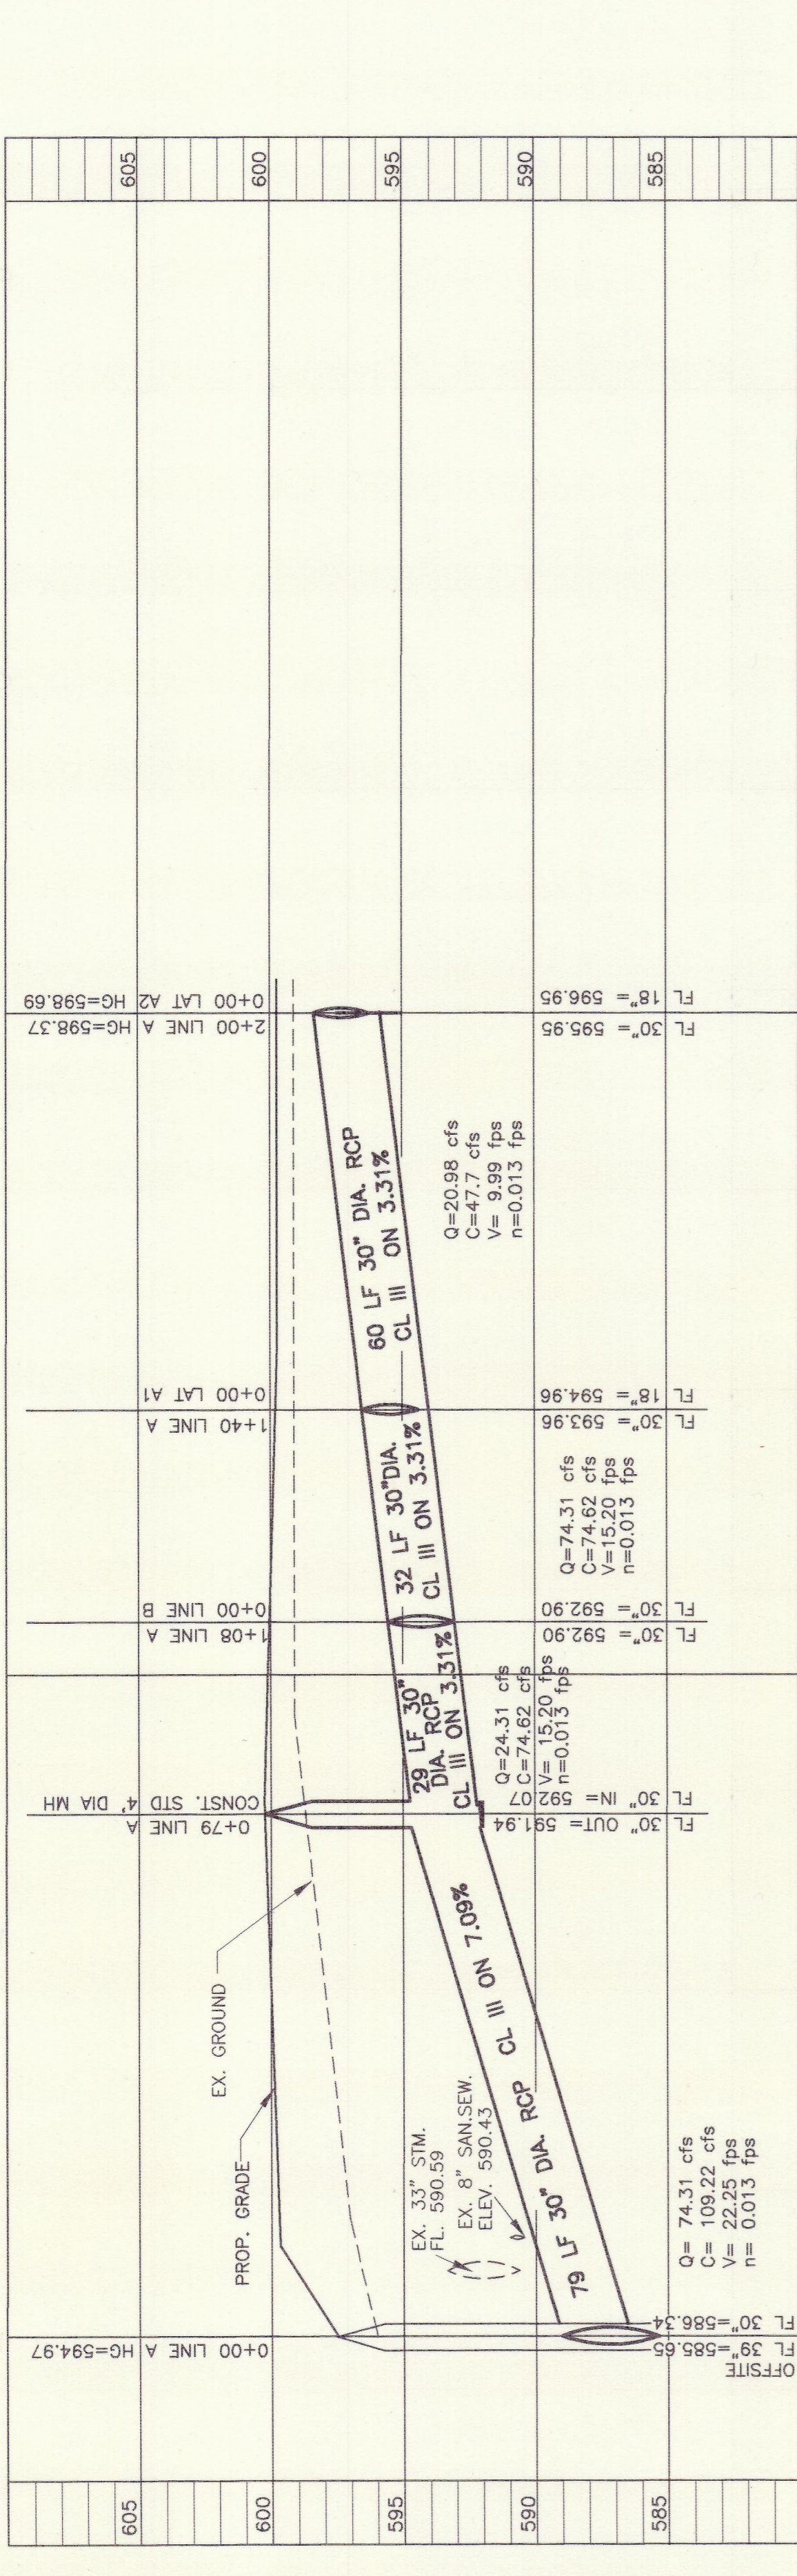


LINE A

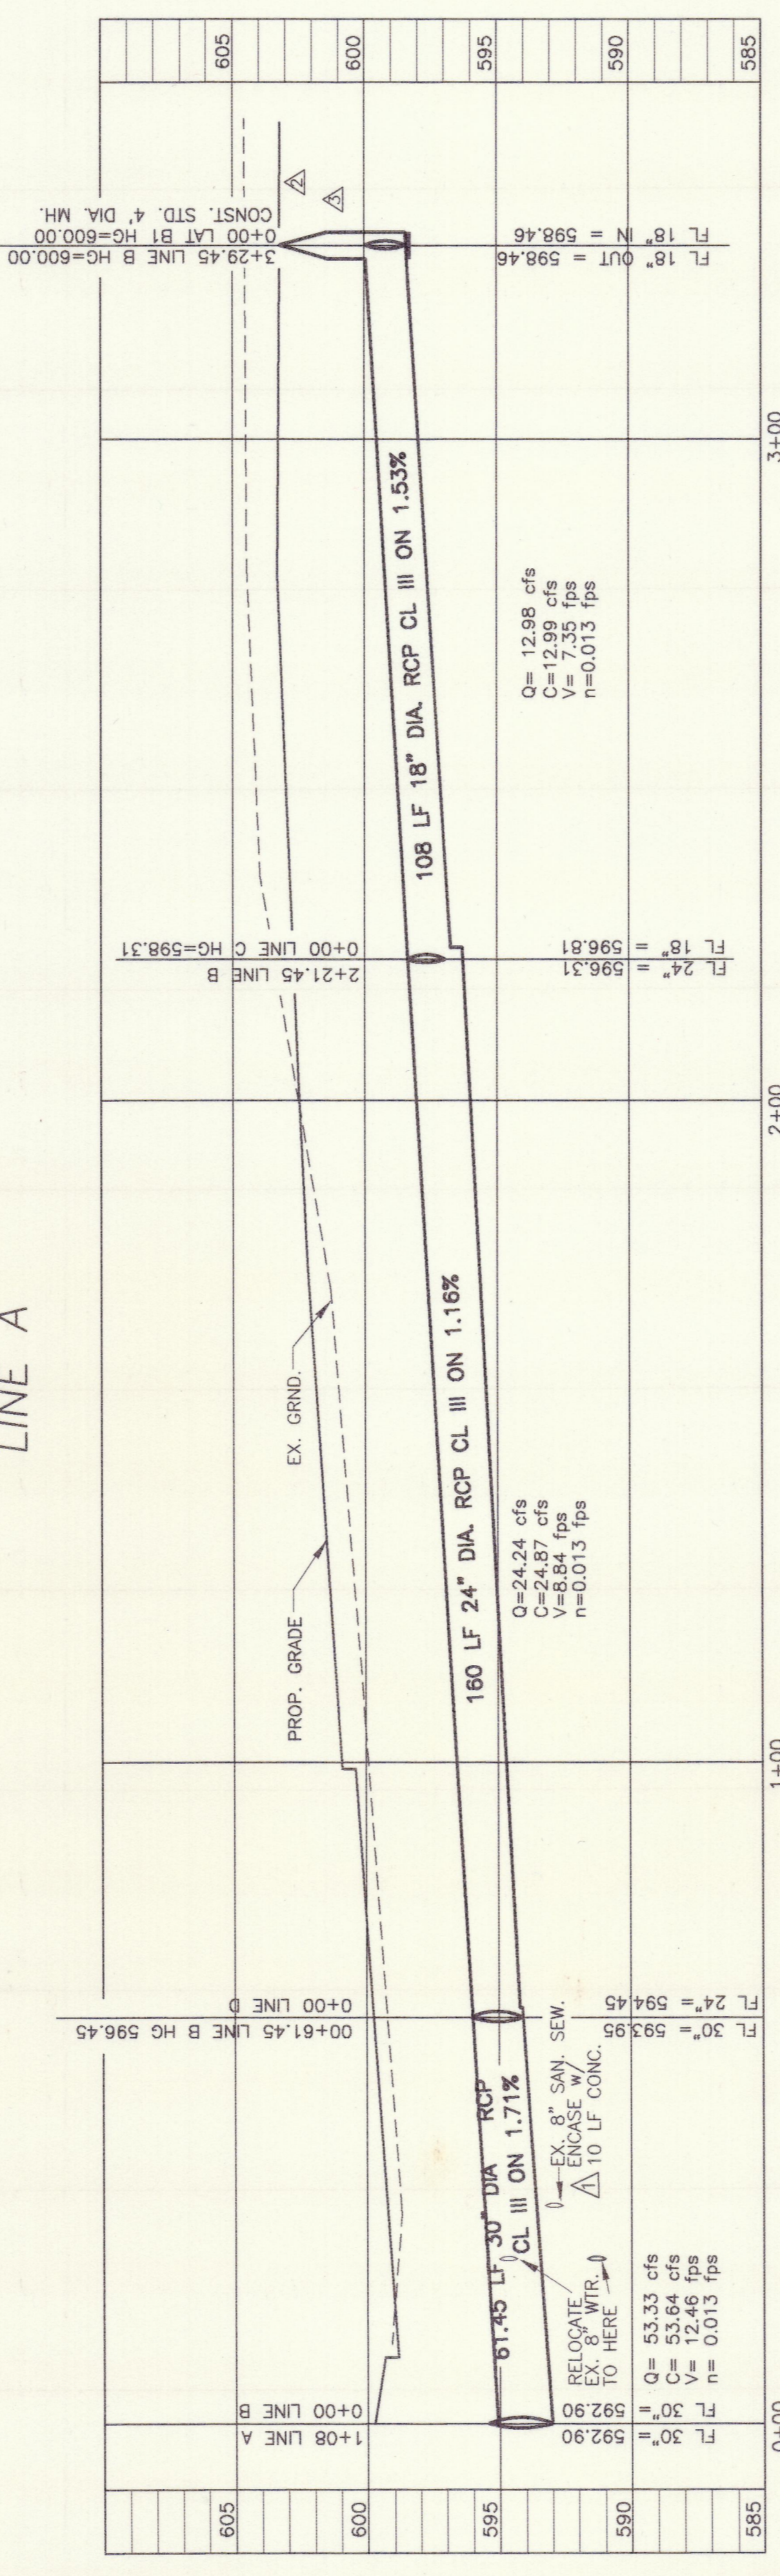


LINE B

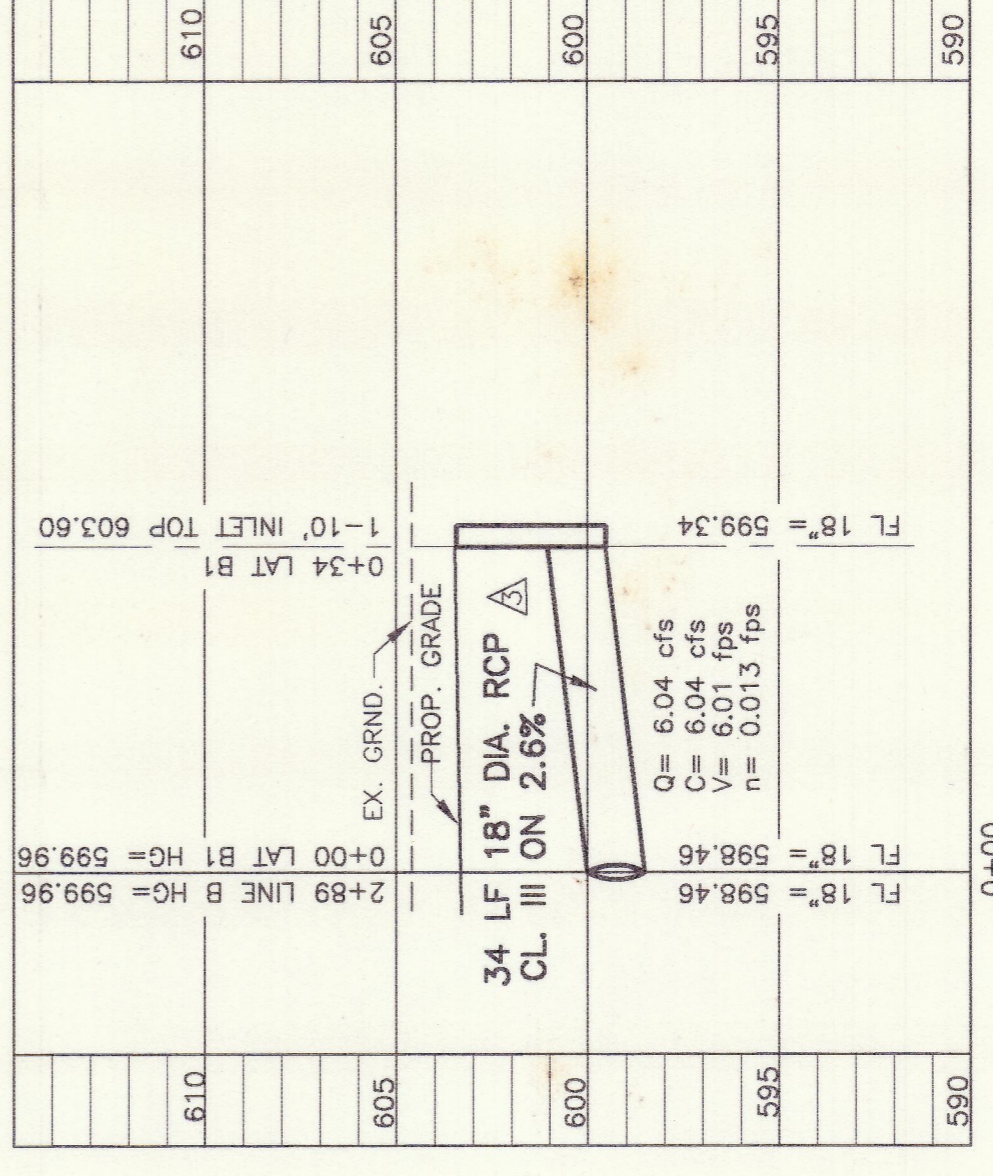

LAT. B1

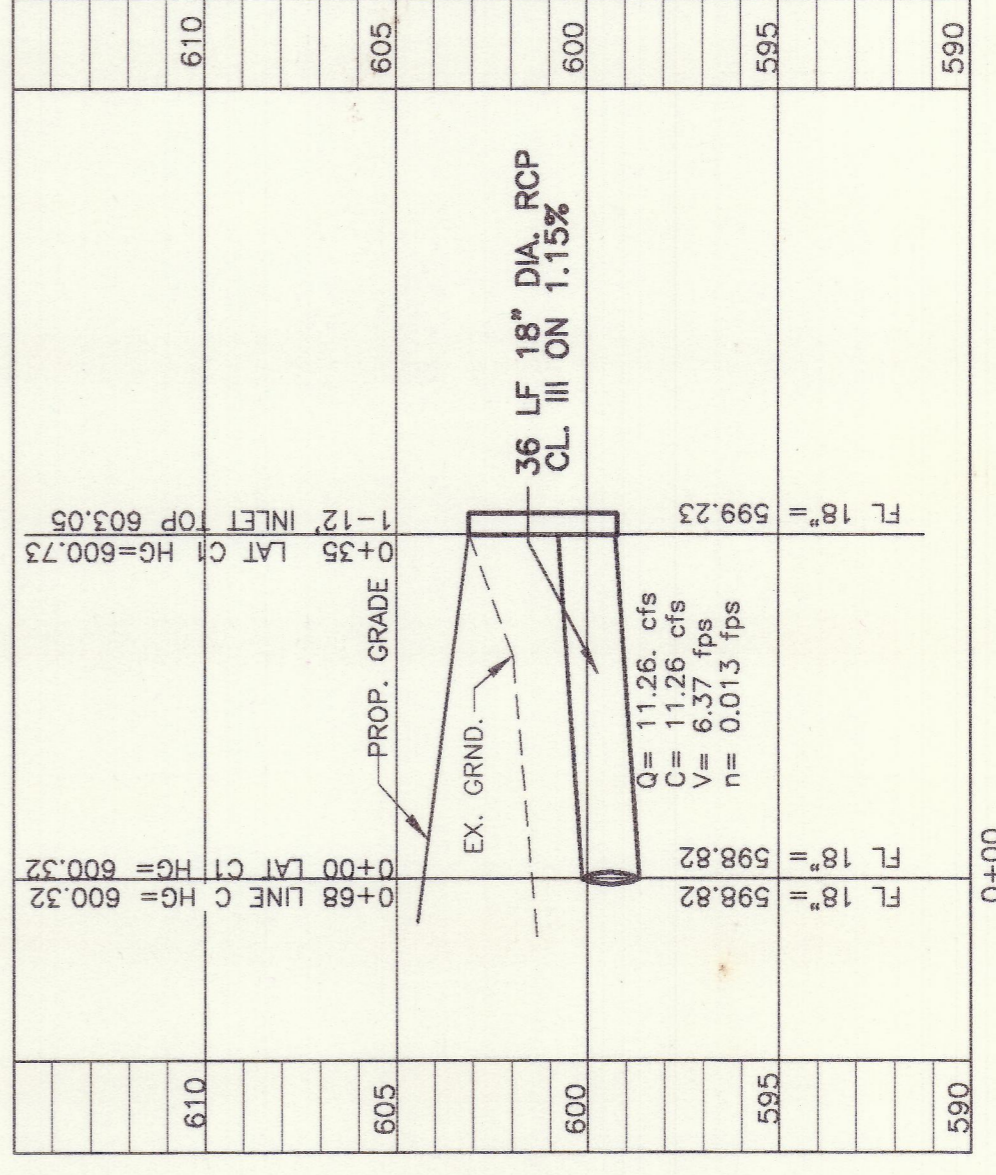

LAT. C1

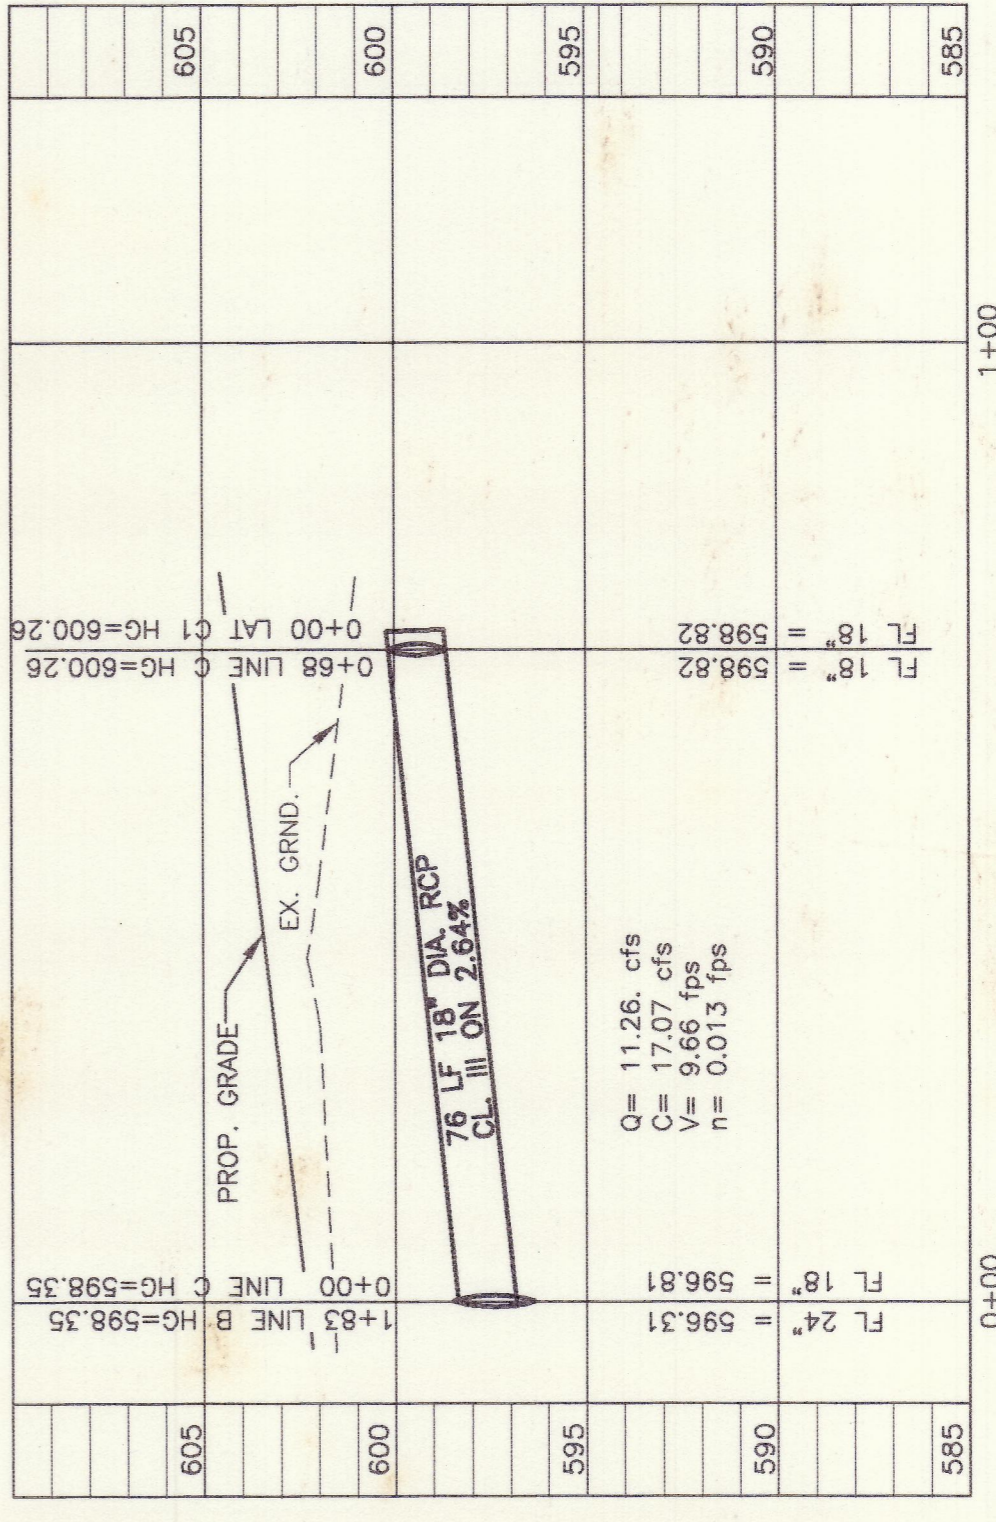

LINE C

THESE DRAWINGS ARE PROVIDED FOR "AS-BUILT" DRAWINGS BY OTHERS FOR THE CITY OF ADDISON

NOTE:
STORM SEWER EMBEDMENT SHALL CONFORM TO THE TOWN OF ADDISON SPECIFICATIONS

STORM SEWER PROFILES		TOWN HOMES OF ADDISON	
DEPARTMENT OF PUBLIC WORKS			
TOWN OF ADDISON, TEXAS			
DESIGN	DATE	SCALE	NOTES
LD	9/15/95	1"=20'H 1"=5'V	CCI
PROJECT NO.	DATE	REVISED PER CITY COMMENTS	DESCRIPTION
81215-35	7/21/96	5/21/96	
PROJ. NO.	DATE	REVISED PER CITY COMMENTS	DESCRIPTION
		5/03/96	
REV. NO.	DATE	REVISED PER CITY COMMENTS	DESCRIPTION