


PLAN	SURVEYED	DATE
NO. _____	BY _____	DATE _____
NOTE BOOK _____	PLOTTED _____	
ALIGNMENT CHECKED _____	GRADES CHECKED _____	
NO. _____	STRUCTURE NOTAS CH. NO. _____	

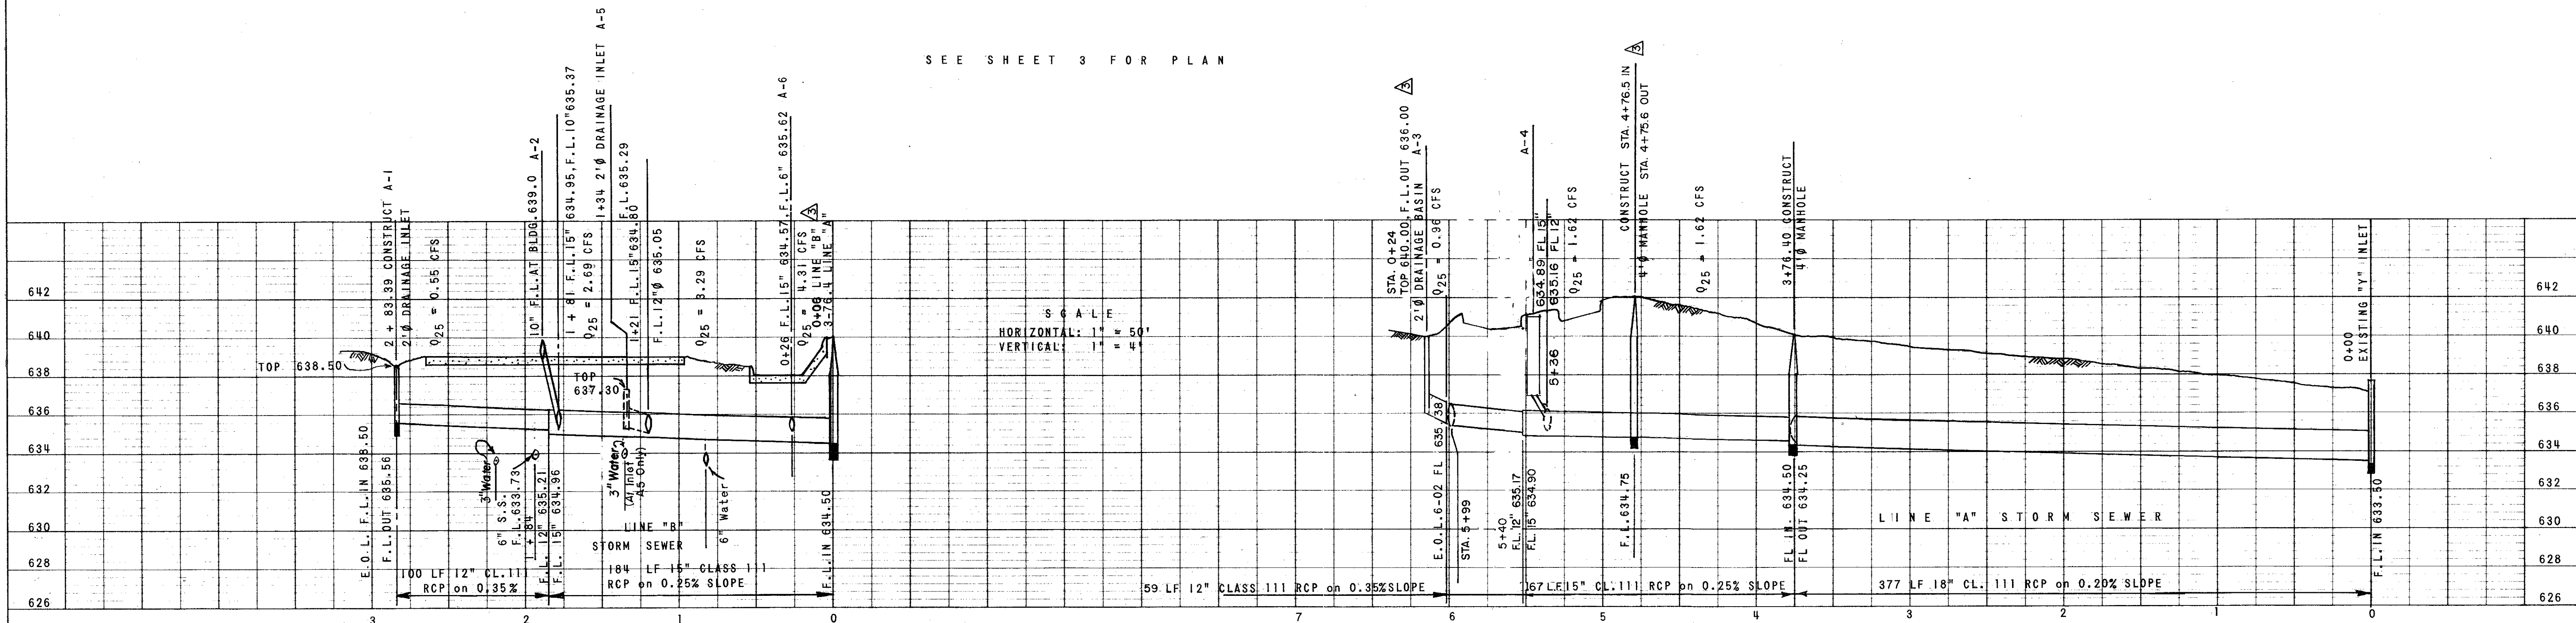


SEE SHEET 3 FOR PLAN

SCALE
HORIZONTAL: 1" = 50'
VERTICAL: 1" = 4'

SEE SHEET 3 FOR PLAN

PROFILE	SURVEYED	DATE
NO. _____	BY _____	DATE _____
NOTE BOOK _____	PLOTTED _____	
GRADES CHECKED _____	STRUCTURE NOTAS CH. NO. _____	

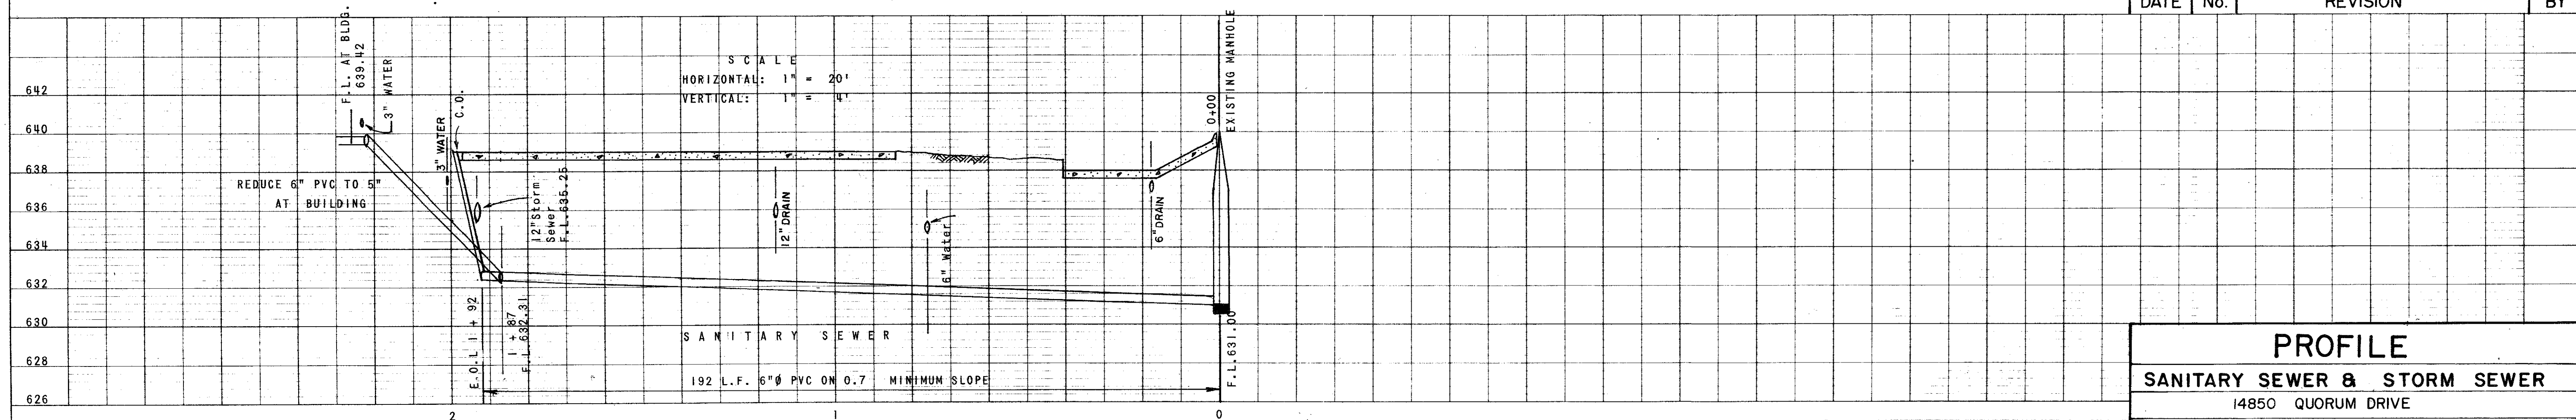

SCALE
HORIZONTAL: 1" = 20'
VERTICAL: 1" = 4'

DATE	No.	REVISION	BY
3-19-84	1	Moved Line "A"	GTS.
2-29-84	2	Revised Location Of 3" Water And A-4 Recessed Inlet.	GTS.
2-2-84	3	Add Piping Crossed by Lines	RFS.

PROFILE
SANITARY SEWER & STORM SEWER
14850 QUORUM DRIVE
THE MURPHREE COMPANY - CITY OF ADDISON, TEXAS
INTERTECH ENGINEERS, INC.

DESIGN	DRAWN	DATE	SCALE	NOTES	FILE	SHEET NO.
RLBA	DPM	1-13-84	AS SHOWN			4 of 7