

# MARRIOTT COURTYARD

QUORUM DRIVE  
ADDISON, TEXAS



B18-4  
15160 QUORUM  
AS-BUILT  
3/15/99

AS BUILT DWGS.


<p>ARCHITECT CONTACT: NICK NASH, PHIL BLASE</p> <p><b>MA/A MERRIMAN ASSOCIATES / ARCHITECTS, INC.</b> ARCHITECTURE AND PLANNING</p> <p>8111 PRESTON ROAD SUITE 350 DALLAS, TEXAS 75225 214 / 987-1299 [ FAX 214 / 987-2138 ] E-MAIL merriman@aolmail.net</p> <p>DALLAS CHARLOTTE</p> <p>CIVIL ENGINEER CONTACT: BOB WRIGHT</p> <p>NEEDHAM WRIGHT 10290 MONROE DRIVE SUITE 101 DALLAS, TEXAS 75229 214 . 357 . 2981 214 . 357 . 2985 FAX</p> <p>STRUCTURAL ENGINEER CONTACT: JOHN PHILLIPS</p> <p>L. A. FUESS PARTNERS 3400 CARLISLE STREET SUITE 200 DALLAS, TEXAS 75204 214 . 871 . 7010 214 . 969 . 0065 FAX</p> <p>MECHANICAL / PLUMBING ENGINEER CONTACT: ED NENON, JEFF CRABTREE</p> <p>J &amp; A MECHANICAL, INC. 60 GERMANTOWN COURT SUITE 100 CORDOVA, TENNESSEE 38018 901 . 752 . 5099 901 . 752 . 8380 FAX</p>	<p>OWNER CONTACT: JACK SHAFFER</p> <p>Western International ONE SPURLING PLAZA 12850 SPURLING DRIVE LB. AND SUITE 114 DALLAS, TEXAS 75230 972 . 934 . 8699 972 . 934 . 8698 FAX</p> <p>ELECTRICAL ENGINEER CONTACT: ED SMITH GLENN GILBREY</p> <p>WALKER ENGINEERING, INC. 10999 PETAL STREET DALLAS, TEXAS 75238 214 . 860 . 4600 1 . 888 . 884 . 4666 FAX</p> <p>LANDSCAPE ARCHITECT CONTACT: RONNIE STAFFORD</p> <p>DAVID C. BALDWIN, INC. 5744 RICHMOND AVENUE DALLAS, TEXAS 75206 972 . 690 . 7474 972 . 690 . 7878 FAX</p> <p>KITCHEN CONSULTANT CONTACT: MIKE RABALAIS</p> <p>CONCEPT SERVICES ONE TECH PLAZA 2113 WELLS BRANCH, SUITE 4000 AUSTIN, TEXAS 78728 512 . 343 . 3100 512 . 900 . 3666 512 . 900 . 0052 FAX 343 3115</p>	<p>CONTRACTOR CONTACT: PAUL PRUITT KIM WILLIAMS</p> <p>LYDA Constructors, Inc. 6228 BANDERA RD. 78238 P.O. BOX 680907 SAN ANTONIO, TEXAS 78268-0907 210 . 684 . 1770 210 . 684 . 1859 FAX</p>
--	--	---

DRAWING REVISION / INDEX

REVISIONS

02/26/99 TEXT, MARRIOTT  
AND ONLY REVISION COMMENTS

SEAL

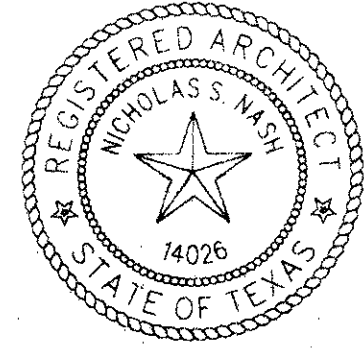

ISSUE FOR CONSTRUCTION  
02/26/99


- A9.00 COVER SHEET
- A0.01 GENERAL NOTES, LEGEND, CODE ANALYSIS
- A0.02 T.A.S. AND A.D.A. STANDARDS
- CIVIL AND LANDSCAPE**
- C-1 EXISTING SITE SURVEY
- C-2 DIMENSIONAL CONTROL AND PAVING PLAN
- C-3 GRADING PLAN
- C-4 DRAINAGE PLAN
- C-5 UTILITY PLAN
- C-6 EROSION CONTROL PLAN
- C-7 EROSION DETAILS
- C-7 DETAILS
- L-1 LANDSCAPE PLAN
- L-2 IRRIGATION PLAN
- L-2 IRRIGATION DETAILS
- ARCHITECTURAL**
- A1.01 SITE PLAN INFORMATION NEW AND DEMO
- A1.11 ENLARGED COURTYARD PLAN
- A1.21 SITE DETAILS
- A1.22 POOL AND SPA INFORMATION
- A2.01 FIRST FLOOR PLAN
- A2.02 SECOND / THIRD FLOOR PLAN
- A2.03 FOURTH / FIFTH FLOOR PLAN
- A2.04 SIXTH / SEVENTH FLOOR PLAN
- A2.11 ENLARGED FLOOR PLANS
- A2.12 TYPICAL GUESTROOM ENLARGED PLANS
- A3.01 TOWER EXTERIOR ELEVATIONS
- A3.02 GATEHOUSE EXTERIOR ELEVATIONS
- A3.03 EXTERIOR ELEVATIONS
- A4.01 GATEHOUSE WALL SECTIONS
- A4.02 GUEST TOWER WALL SECTIONS
- A4.03 EXTERIOR DETAILS
- A4.04 DETAILS
- A5.01 ROOF PLAN INFORMATION
- A5.02 ROOF DETAILS
- A5.03 ROOF DETAILS
- A6.01 STAIR PLANS, SECTIONS, & DETAILS
- A6.02 ELEVATOR SECTIONS & DETAILS
- A7.01 TYPICAL FLOOR R.C.P. INFORMATION
- A7.02 TYP. FLOOR R.C.P., POOL HOUSE R.C.P., & CEILING DETAILS
- A8.01 BAR/BUFFET ENLARGED PLAN, MILLWORK, ELEVATIONS, SECTION, & DETAILS
- A8.02 INTERIOR DETAILS AND MILLWORK INFORMATION
- A8.21 INT. RESTROOM ELEVATIONS / ACCESSORY SCHEDULE
- A8.22 INTERIOR PUBLIC SPACE ELEVATIONS
- A9.01 DOOR SCHEDULE, DOOR & WINDOW TYPES, PARTITION TYPES
- A9.02 ROOM FINISH SCHEDULES
- A9.03 HEAD, JAMB AND SILL DETAILS

- INTERIOR DESIGN**
- ID.01 COVER SHEET
- ID.02 SITE PLAN INFORMATION NEW AND DEMO
- ID.03 ENLARGED COURTYARD PLAN
- KITCHEN**
- K1.01 KITCHEN EQUIPMENT & SPECIAL CONDITIONS
- K1.02 KITCHEN SPECIAL CONDITIONS & MECHANICAL ROUGH-INS
- K1.03 KITCHEN & BAR PLUMBING ROUGH-INS
- K1.04 KITCHEN & BAR ELECTRICAL ROUGH-INS
- STRUCTURAL**
- S1.01 GENERAL NOTES
- S2.01 DIMENSIONAL CONTROL PLAN
- S2.02 FOUNDATION & GROUND FLOOR, ROOF STRUCTURAL PLAN - GATEHOUSE
- S2.03 GROUND FLOOR & FOUNDATION PLAN - GUEST TOWER
- S2.04 LEVELS 2 - 8 REINFORCEMENT/STRUCTURAL PLAN
- S2.05 LEVEL 7 REINFORCEMENT/STRUCTURAL PLAN
- S2.06 ROOF LEVEL REINFORCEMENT/STRUCTURAL PLAN
- S3.01 FOUNDATION DETAILS
- S3.02 CONCRETE BEAM DETAILS
- S3.03 REINFORCING DETAILS / CONC BEAM & JOIST SCHEDULES
- S4.01 FOUNDATION DETAILS
- S4.02 DETAILS
- S5.01 ROOF DETAILS
- S6.01 MASONRY / STEEL DETAILS
- S6.02 DETAILS

- ELECTRICAL**
- E-01 LEGEND AND GENERAL INFORMATION
- E-02 FEEDER SCHEDULE
- E-1.1 ELECTRICAL - RISER DIAGRAM
- E-1.2 ELECTRICAL - DISTRIBUTION AND PANEL SCHEDULES
- E-2.1 ELECTRICAL - SITE PLAN
- E-3.1.1 ELECTRICAL - POWER - 1st FLOOR TOWER
- E-3.1.2 ELECTRICAL - POWER - 1st FLOOR GATEHOUSE
- E-3.1.3 ELECTRICAL - KITCHEN/BAR - ROUGH-IN PLANS
- E-3.2 ELECTRICAL - POWER - 2nd THRU 7th FLOOR TOWER
- E-3.3 ELECTRICAL - POWER - ROOF PLAN TOWER
- E-4.1.1 ELECTRICAL - LIGHTING - 1st FLOOR TOWER
- E-4.1.2 ELECTRICAL - LIGHTING - 1st FLOOR GATEHOUSE
- E-4.2 ELECTRICAL - LIGHTING - 2nd THRU 7th FLOOR TOWER
- E-5.1.1 ELECTRICAL - SYSTEMS - 1st FLOOR TOWER
- E-5.1.2 ELECTRICAL - SYSTEMS - 1st FLOOR GATEHOUSE
- E-5.2 ELECTRICAL - SYSTEMS - 2nd THRU 7th FLOOR TOWER
- E-6.1 ELECTRICAL - DETAILS - PWR./LTC./SYS. OF TYP. GUEST ROOMS
- MECHANICAL**
- M-1 FIRST FLOOR - COMMERCIAL AREA
- M-2 FIRST FLOOR - TOWER PLAN
- M-3 2nd AND 3rd FLOOR - TOWER PLAN
- M-4 4th AND 5th FLOOR - TOWER PLAN
- M-5 6th AND 7th FLOOR - TOWER PLAN
- M-6 P/OF PLAN
- M-7 RISER DIAGRAMS
- M-8 DETAILS
- M-9 DETAILS
- M-10 SCHEDULES
- PLUMBING**
- P-1 FIRST FLOOR - COMMERCIAL AREA - UNDERGROUND
- P-1A FIRST FLOOR - COMMERCIAL AREA - WATER
- P-2 FIRST FLOOR - TOWER - UNDERGROUND
- P-2A FIRST FLOOR - TOWER - WATER
- P-3 2nd AND 3rd FLOOR - TOWER PLAN - PLUMBING
- P-4 4th AND 5th FLOOR - TOWER PLAN - PLUMBING
- P-5 6th AND 7th FLOOR - TOWER PLAN - PLUMBING
- P-6 ROOF PLAN
- P-7 GUESTROOM PLANS, AND RISER DIAGRAMS
- P-8 PLUMBING DETAILS

- FR-1 1st FLR Fire Protection
- FP-2 Standpipe System
- FP-3 Site Fireline
- FP-4 Typical Floors
- FP-5 Penthouse Fire Protection System
- FI-FID Fire Alarm Plan

LOCATION MAP

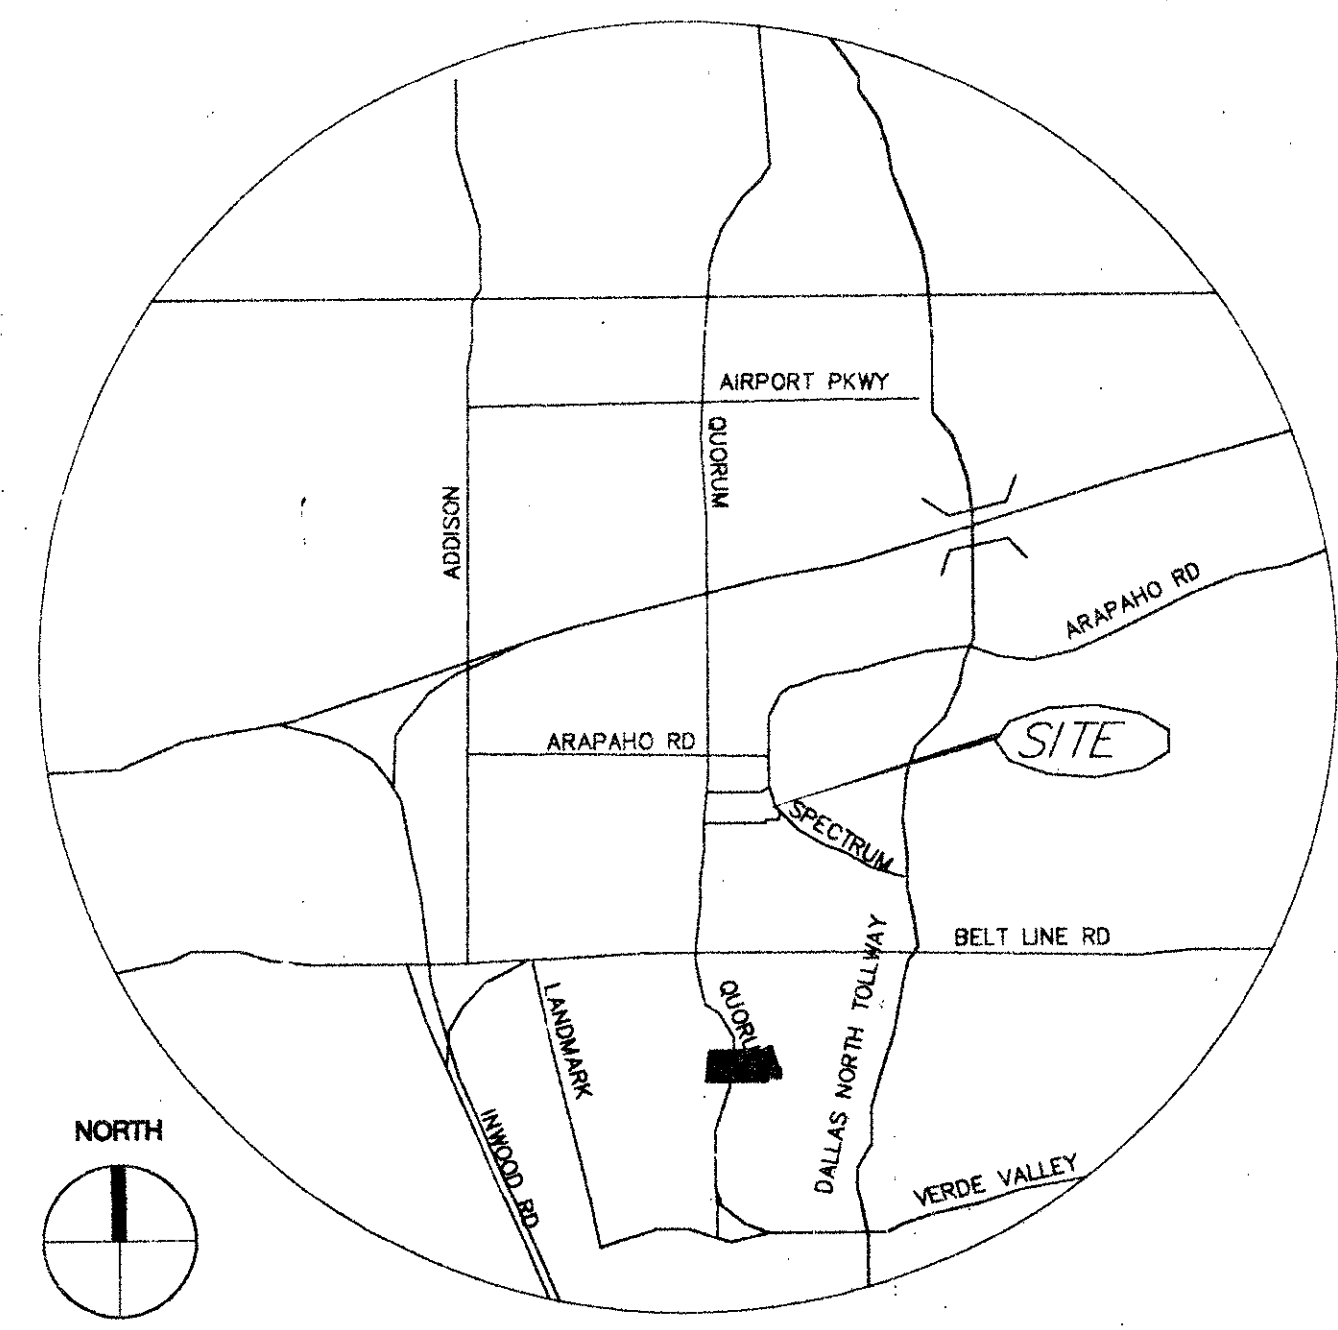

AS-BUILT