


BASIN	A	C	T <sub>c</sub>	I <sub>100</sub>	Q <sub>100</sub>	I <sub>25</sub>	Q <sub>25</sub>
1	0.66	.9	10	8.74	5.2	7.29	4.34
2	0.15	.9	10	8.74	1.2	7.29	1.00
3	0.17	.9	10	8.74	1.3	7.29	1.08
4	0.57	.9	10	8.74	4.5	7.29	3.75
5	0.51	.9	10	8.74	4.0	7.29	3.34
6	0.63	.9	10	8.74	5.0	7.29	4.17
7	0.76	.9	10	8.74	6.0	7.29	5.00
8	0.26	.9	10	8.74	2.2	7.29	1.83

NOTE:  
 GRATE : 2'X2' - NEENAH R4759 , OR EQUAL  
 GRATE : 3'X3' - NEENAH R4893-B , OR EQUAL

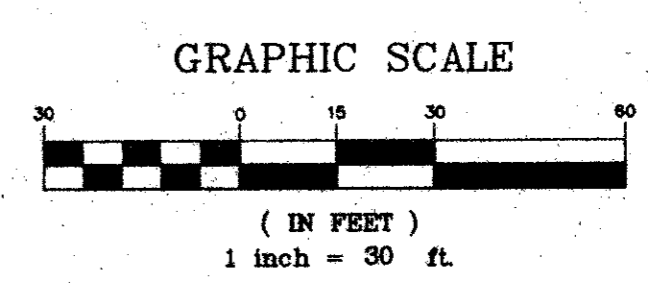

MAVA  
 MERRIMAN ASSOCIATES / ARCHITECTS, INC.  
 ARCHITECTURE AND PLANNING  
 8111 PRESTON ROAD  
 DALLAS, TEXAS 75225  
 214 / 897-1298 [ FAX 214 / 897-2128 ]  
 E-MAIL: merriman@comcast.net  
 DALLAS CHARLOTTE

COURTYARD  
 Marriott Addison, Texas

© 1998 MERRIMAN ASSOCIATES / ARCHITECTS, INC.

ROBERT WRIGHT  
 3-15-99

REVISIONS:  
 REVISION 03/15/99 BY: TK  
 REVISION 02/24/99 BY: TK  
 REVISION 10/16/98 BY: EBH  
 REVISION 10/6/98 BY: EBH

COMPUTER FILE:  
 ATTACHED & REFERENCED

PLOTTING SCALE:

PROJECT:  
 97405  
 DATE:  
 03/15/99  
 SHEET TITLE:  
 DRAINAGE  
 PLAN  
 SHEET:  
 C-3

NEEDHAM WRIGHT ENGINEERS  
 A Fife Engineering, Inc. Company  
 10290 MONROE DRIVE  
 SUITE 101  
 DALLAS, TEXAS 75220  
 PH. (214) 357-2981  
 FAX (214) 357-2985  
 JOB NO. 97405