


VERIFY LOCATION OF ALL UTILITIES BEFORE CONSTRUCTION BEGINS. NOTIFY ENGINEER OF ANY CONFLICTS WITH PROPOSED CONSTRUCTION. NOTIFY ALL UTILITY COMPANIES OF INTENT TO BEGIN CONSTRUCTION 48 HOURS AHEAD.

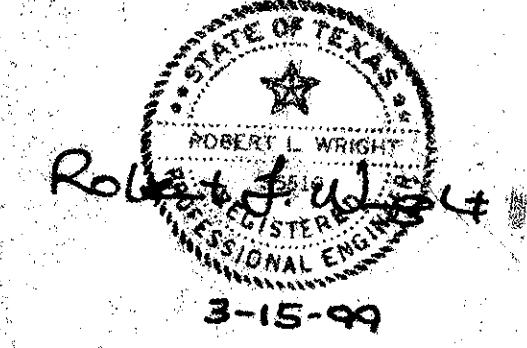

NEEDHAM WRIGHT ENGINEERS
 A Peto Engineers, Inc. Company
 10290 MONROE DRIVE
 SUITE 101
 DALLAS, TEXAS 75228
 PH (214) 357-2981
 FAX (214) 357-2985
 JOB NO. 97405

M/A MERRIMAN ASSOCIATES / ARCHITECTS, INC.
 ARCHITECTURE AND PLANNING
 8111 PRESTON ROAD
 SUITE 500
 DALLAS, TEXAS 75225
 214 / 897-1281 FAX 214 / 897-9187
 E-MAIL: merriman@aol.com
 DALLAS TEXAS

COURTYARD

Marriott Addison, Texas

© 1995 MERRIMAN ASSOCIATES / ARCHITECTS, INC.

REVISIONS:

COMPUTER FILE:
 ATTACHED X-REFERENCES:

PLOTTING SCALE:

PROJECT: 97405
 DATE: 03/15/99

SHEET TITLE: UTILITY PLAN
 SHEET: C-4