



5. TYPICAL DOWEL DETAIL
N.T.S.

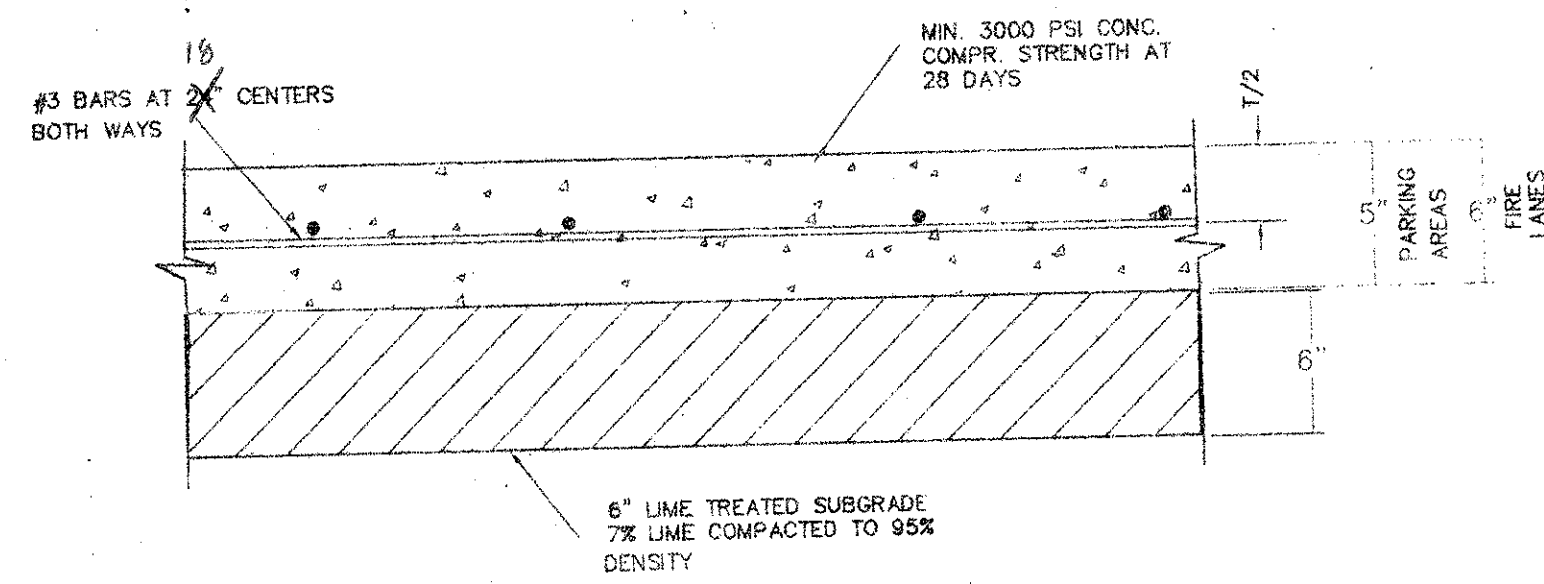


6. TYPICAL CONC. PAVEMENT SECTION
N.T.S.

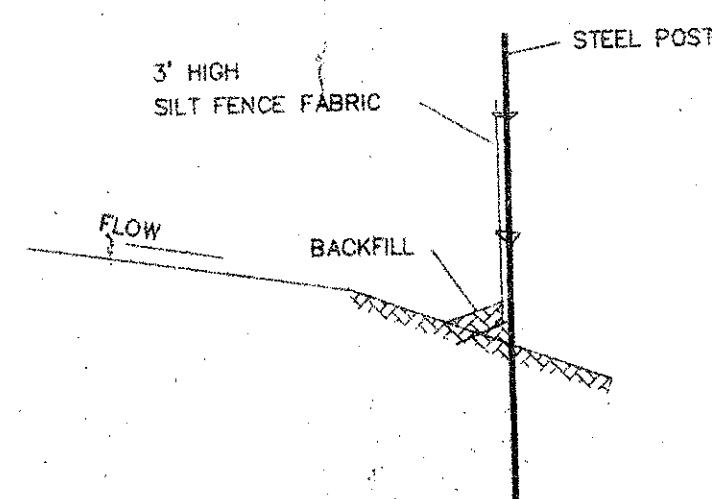


7. FILTER FABRIC FENCE EROSION CONTROL
NO SCALE


INSTALL TEMPORARY EROSION CONTROL FENCE AROUND EACH CONSTRUCTION SITE. PROTECT ALL ADJACENT PROPERTY FROM SEDIMENTATION FROM THIS CONSTRUCTION. TRUCKS LEAVING THE SITE SHALL HAVE ALL EXCESS MUD AND MATERIAL REMOVED FROM TIRES. ALL DEBRIS TRACKED OFF-SITE SHALL BE CLEANED IMMEDIATELY AT THE CONTRACTOR'S EXPENSE. THE CONTRACTOR SHALL KEEP FENCE IN GOOD REPAIR.

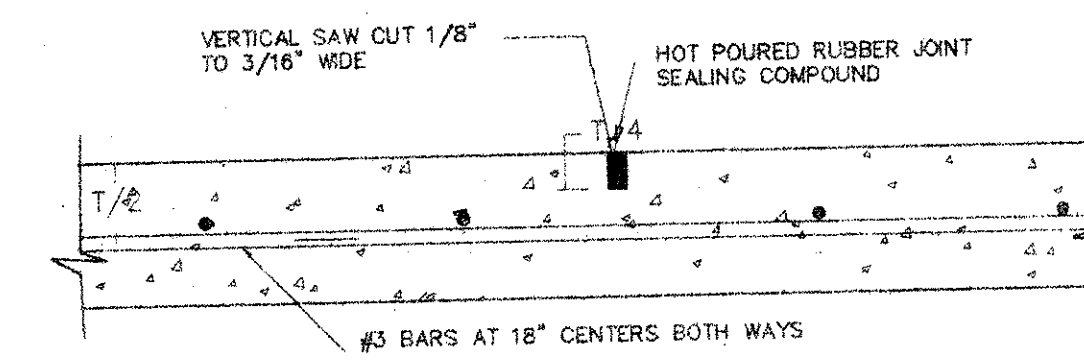


4. SAWED DUMMY JOINT
N.T.S.

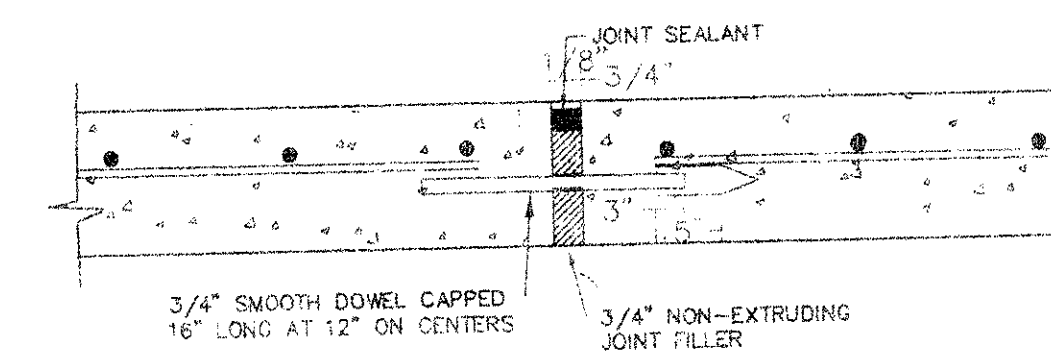

3. EXPANSION JOINT
N.T.S.

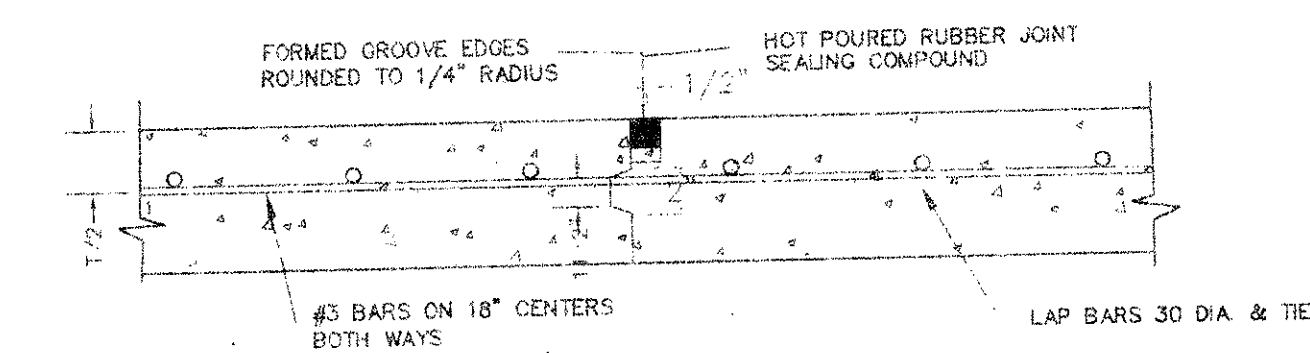


2. CONSTRUCTION JOINT FOR PAVEMENT
N.T.S.

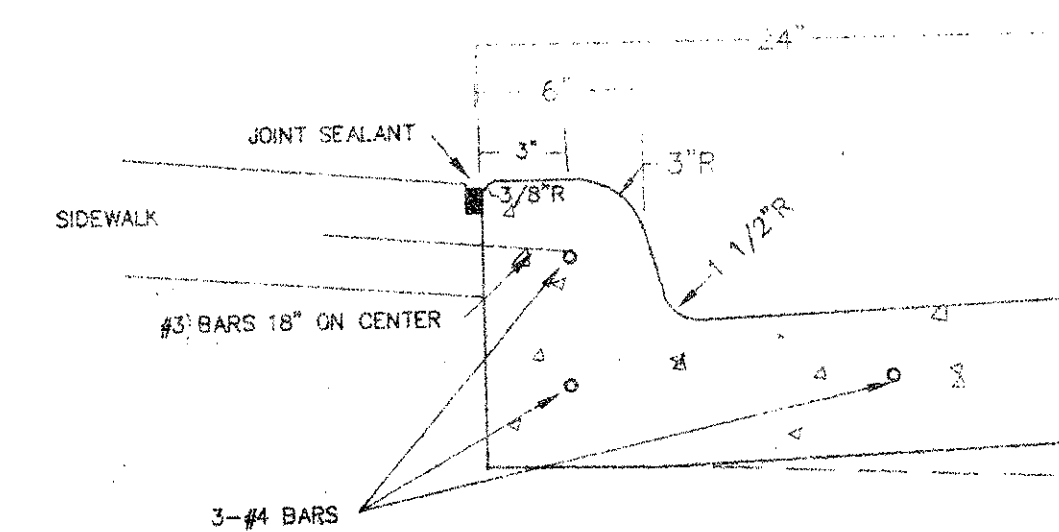

1. CURB AND GUTTER
N.T.S.

NOTE: CURB DIMENSIONS AND REINFORCEMENT TO BE THE SAME FOR INTEGRAL CONCRETE CURB.

NOTE:
ALL CONSTRUCTION DETAILS SHALL FOLLOW TOWN OF ADDISON STD. STANDARD SPECIFICATIONS AND STANDARD CONSTRUCTION DETAILS

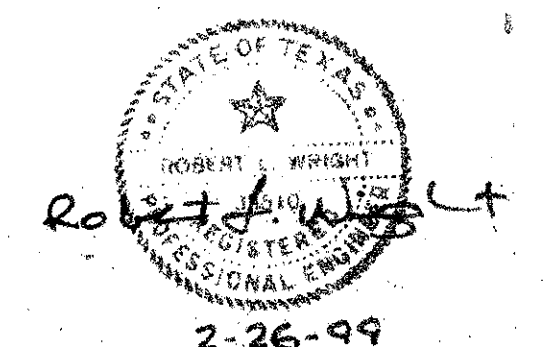

NEEDHAM WRIGHT ENGINEERS
A Fine Engineers, Inc. Company
10230 MONROE DRIVE
SUITE 101
DALLAS, TEXAS, 75229
PH. (214) 357-2981
FAX (214) 357-2985
JOB NO. 97405

MVA MERRIMAN ASSOCIATES / ARCHITECTS, INC.
ARCHITECTURE AND PLANNING
8111 BREXTON ROAD
DALLAS, TEXAS 75225
214 / 987-1998 [FAX 214 / 987-2188]
E-MAIL: merriman@mva.com
DALLAS

COURTYARD
Marriott ADDISON, TEXAS

CP 902
MERRIMAN ASSOCIATES
ARCHITECTS, INC.
ADDISON, TX, 75001

COMPUTER FILE
ATTACHED & REFINISHED
PLOTING SCALE
PROJECT
97405
DATE
02/24/99
SHEET TITLE
DETAILS
SHEET
C-7