




B TREE STAKING DETAIL
SCALE: N.T.S.

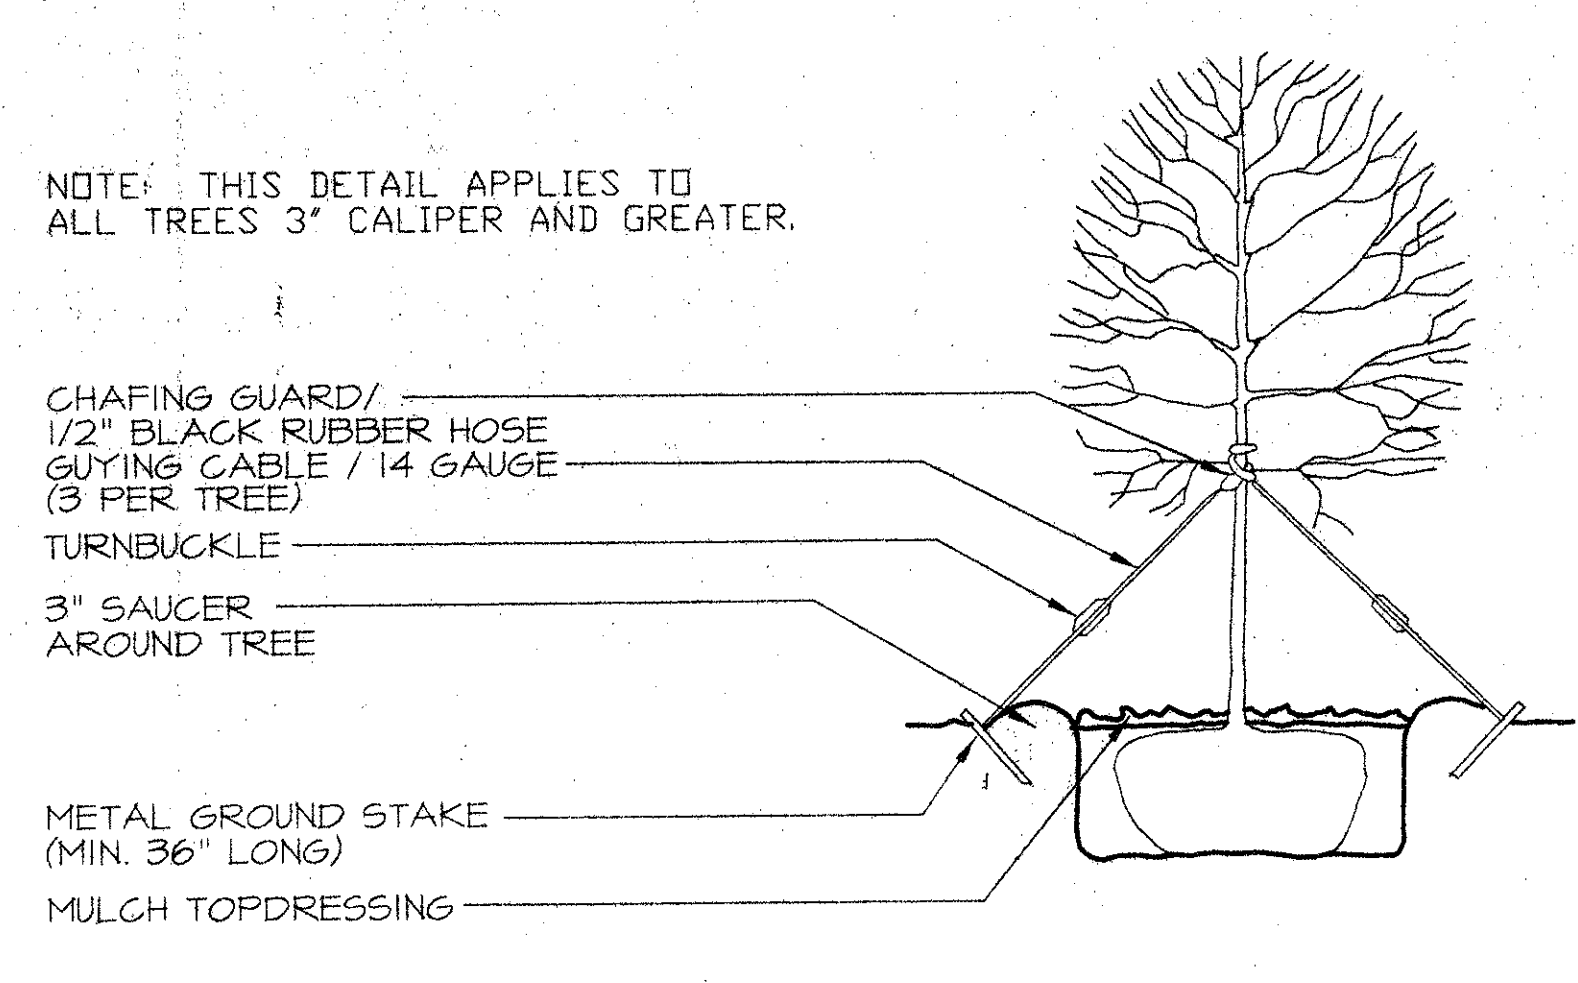



C TREE GUYING DETAIL
SCALE: N.T.S.

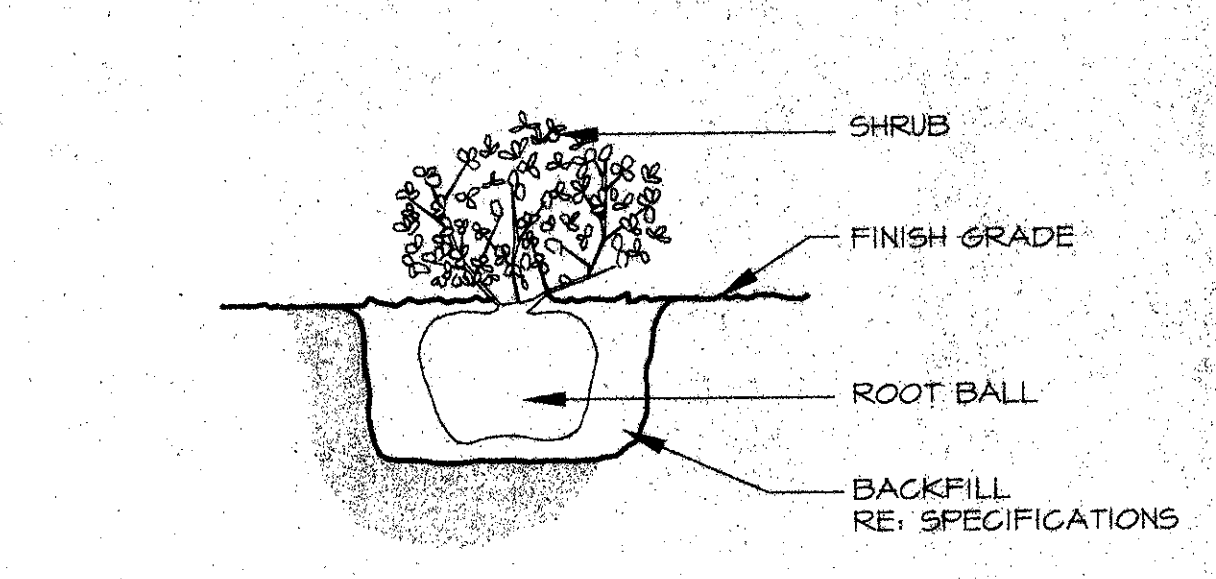

D SHRUB PLANTING DETAIL
SCALE: N.T.S.

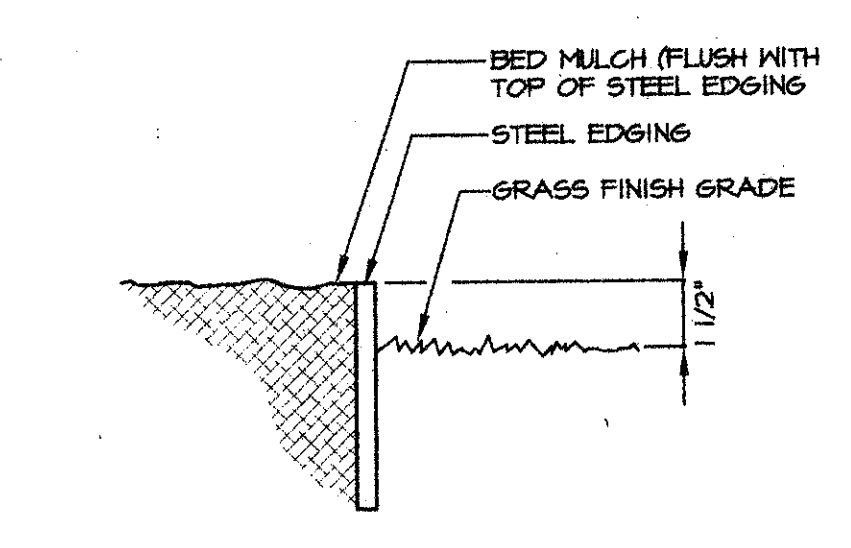

E STEEL EDGING
SCALE: N.T.S.

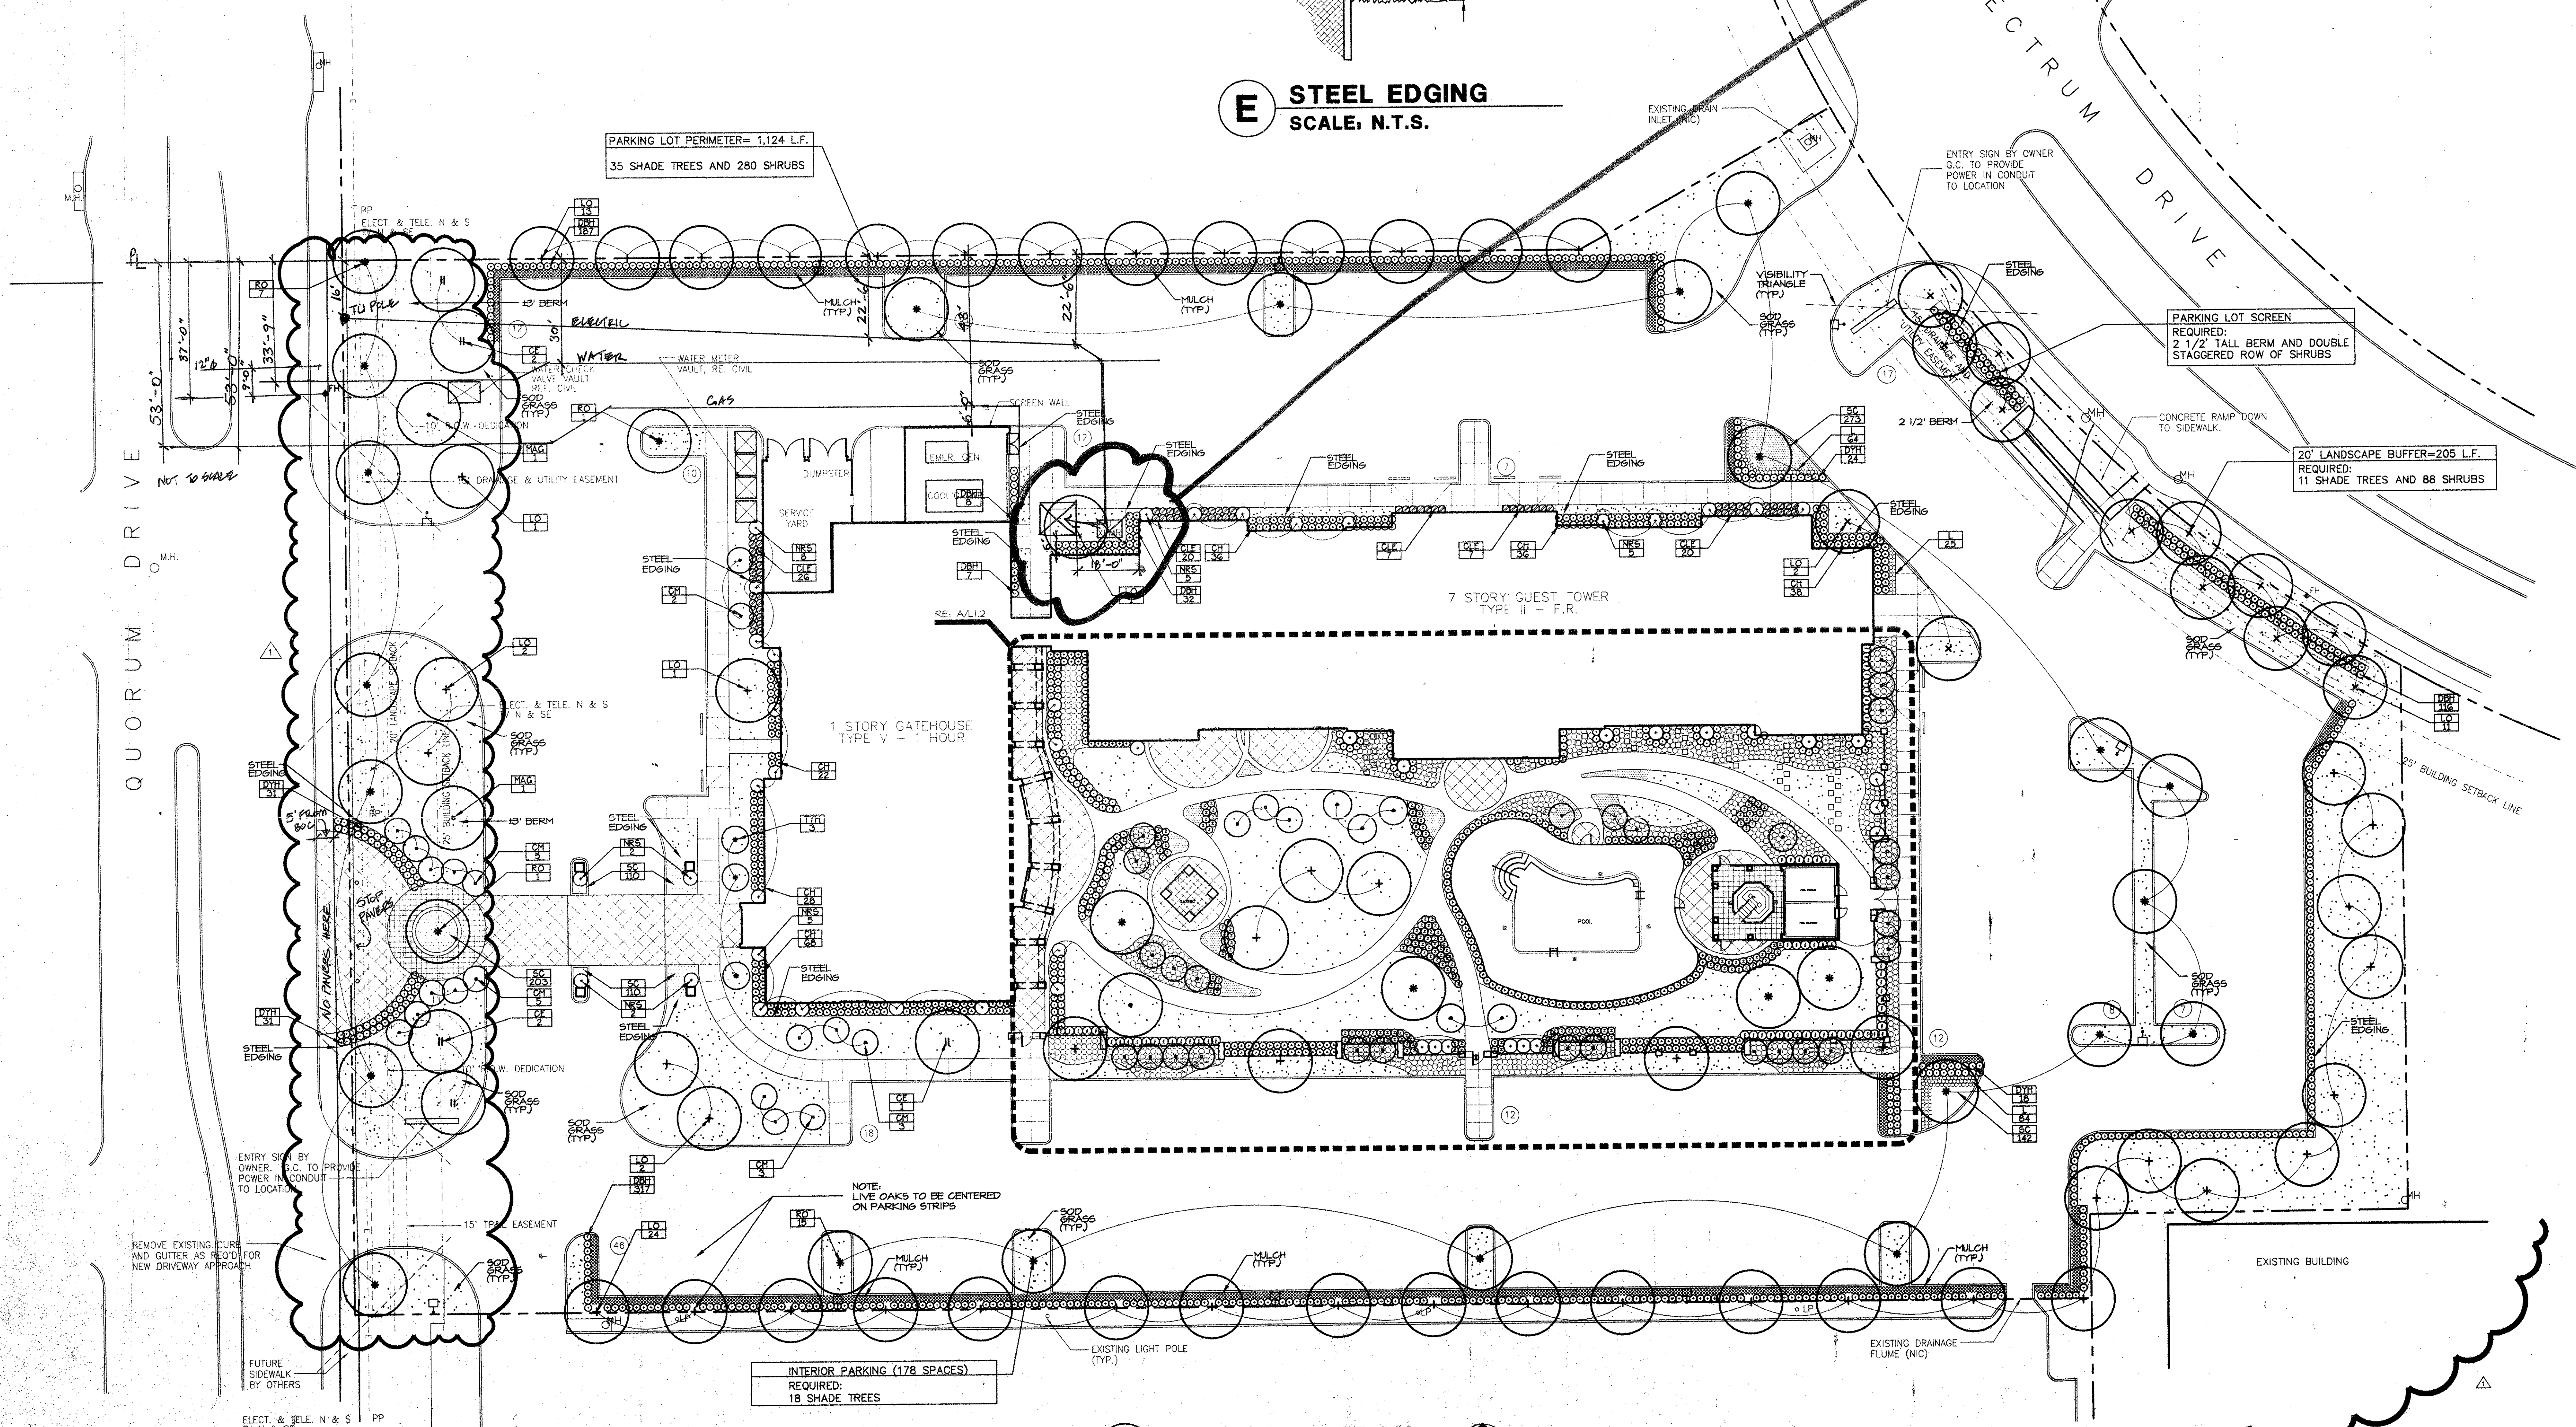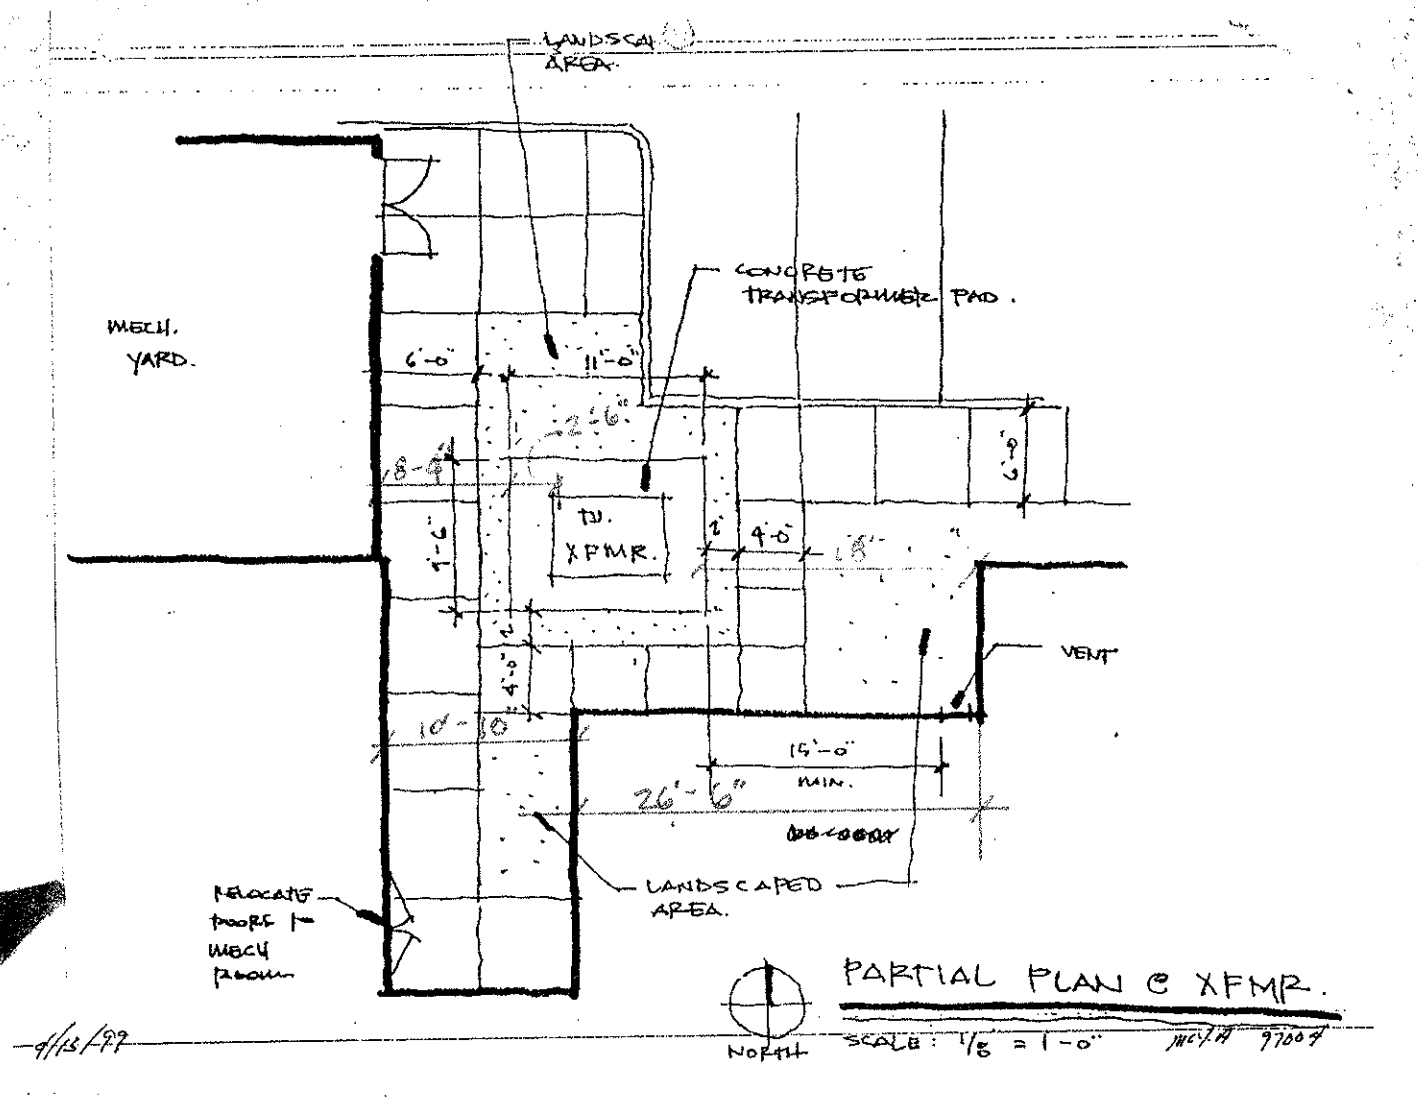


A LANDSCAPE PLAN
SCALE: 1"=20'

MARRIOTT ASSOCIATES, INC. ARCHITECTS, INC.
 5714 BILBAUM AVENUE
 DALLAS, TEXAS 75205
 TEL: 214-251-5500
 FAX: 214-251-5502

MARRIOTT ASSOCIATES, INC. ARCHITECTS, INC.
 5714 BILBAUM AVENUE
 DALLAS, TEXAS 75205
 TEL: 214-251-5500
 FAX: 214-251-5502

STATE OF TEXAS
 PROFESSIONAL ARCHITECTS
 DAVID C. BILBAUM, INC.
 5714 BILBAUM AVENUE
 DALLAS, TEXAS 75205
 TEL: 214-251-5500
 FAX: 214-251-5502

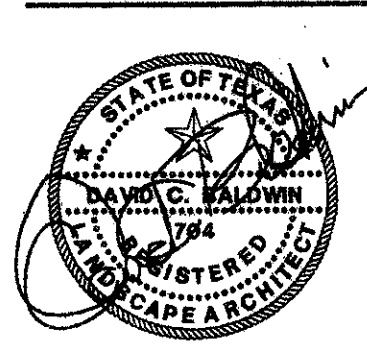

MARRIOTT COURTYARD
 QUORUM DRIVE, ADDISON, TEXAS
 WESTERN INTERNATIONAL



© 1998 MARRIOTT ASSOCIATES/ARCHITECTS, INC.
 REVISIONS
 CITY COMMENTS
 DESIGNED PLANT
 QUANTITIES & MOVE
 DRIVES (NEST ENR)
 PROJECT NUMBER: 97004.03
 ISSUE: 12/7/98
 SHEET NAME: LANDSCAPE PLAN
 SHEET: L1.1