


QUORUM DRIVE

NOTE: POWER POLE TO BE REMOVED AFTER CONSTRUCTION.

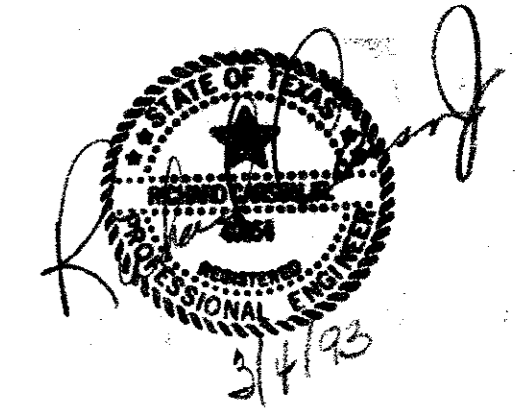

NOTE: ALL DIMENSIONS ARE FROM FACE OF CURB TO FACE OF CURB, UNLESS OTHERWISE SPECIFIED.

BENCHMARK
 SQUARE CUT ON \odot OF INLET; WEST SIDE OF
 QUORUM DRIVE; 340'± NORTH OF BELT LINE ROAD.
 ELEV. 341.53

HORIZONTAL CONTROL
 QUORUM CENTRE-EAST NO. 1 ADDITION
 ADDISON, TEXAS
 CMT

BROCKETTE · DAVIS · DRAKE , inc.
 consulting engineers
 Civil & Structural Engineering · Surveying
 3535 Travis, Suite 100 · Dallas, Texas 75204 · (214) 522-9540

DESIGN	DRAWN	DATE	SCALE	NOTES	FILE	NO.
JAR	BDD	1-93	1"=20'		C92400	2

REVISED 3/4/93 OFFICE DEPOT ENTRANCE