



EDWIN LEWIS DRIVE

(FORMERLY ARAPHO ROAD) (VARIABLE WIDTH RIGHT-OF-WAY)

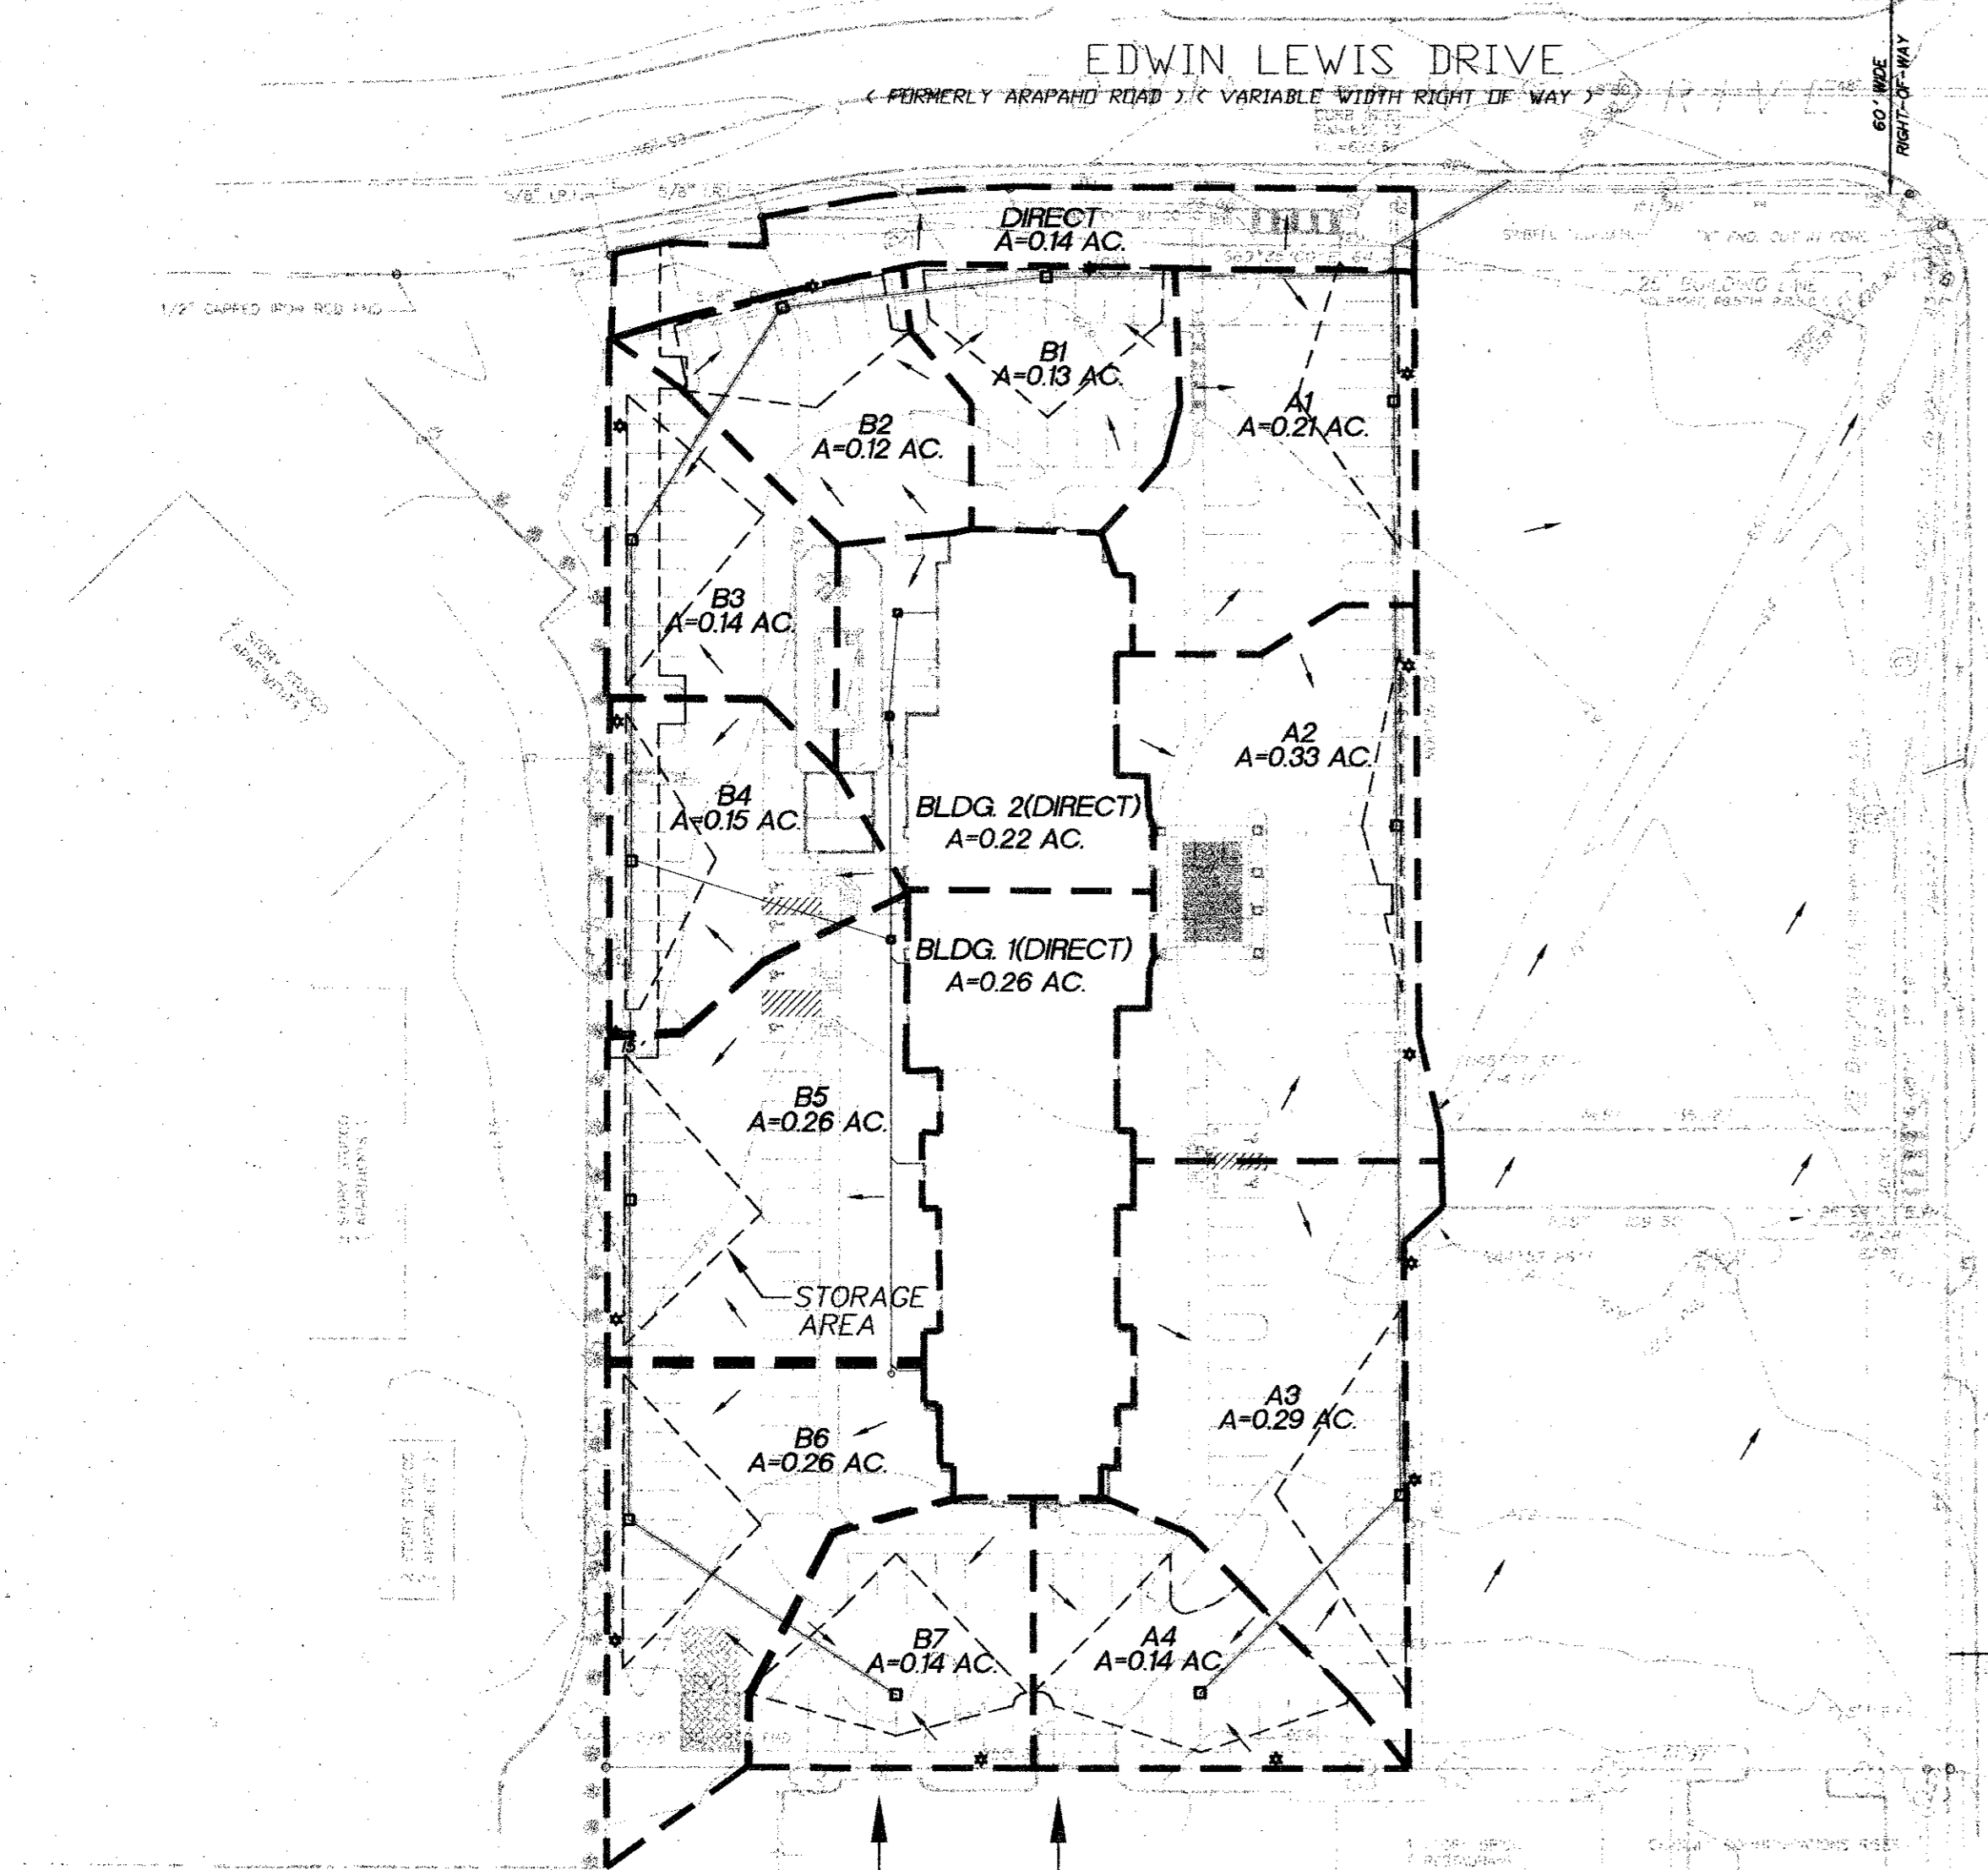

**PROVIDED STORAGE VOLUME ON-SITE**

AREA DESIGNATION	PROVIDED VOLUME (C.F.)
A1	427
A2	146
A3	592
A4	742
B1	550
B2	471
B3	473
B4	336
B5	473
B6	475
B7	600
SUM =	5,285

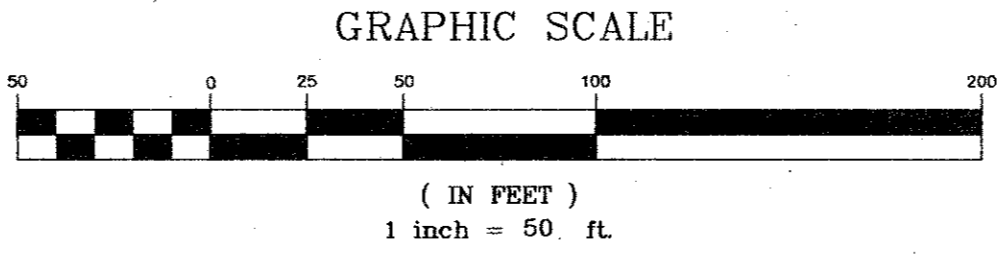

**Q=CIA**

Drainage Area (ac.):	2.91
Design Storm (yrs):	100

**Proposed Conditions (25 YR.)**

C =	0.90
Tc (min.) =	10.0
I (in/hr) =	7.3
Q (cfs) =	19.09

**Proposed Conditions (100 YR.)**

C =	0.90
Tc (min.) =	10.0
I (in/hr) =	8.7
Q (cfs) =	22.89

Storm Duration	I (in/hr)	Q (cfs)	Inflow (cu.ft.)	Outflow (cu.ft.)	Storage (cu.ft.)
5.0	10.5	27.5	8242.0	8591.6	-349.6
10.0	8.7	22.9	13734.0	11455.5	2278.5
15.0	7.5	19.7	17725.4	14319.4	3406.0
20.0	6.8	17.8	21371.0	17183.3	4187.8
30.0	5.8	15.1	27106.7	22911.0	4195.6
40.0	5.0	13.1	31428.0	28638.8	2789.2
50.0	4.5	11.7	34963.7	34366.5	597.1
60.0	3.9	10.2	36865.0	40094.3	-3229.2
120.0	2.6	6.9	49404.8	74460.8	-25056.0
180.0	1.9	5.0	54024.7	108827.3	-54802.6
240.0	0.0	0.0	0.0	143193.8	-143193.8

STORAGE AREA REQUIRED = 4,195.6 C.F.  
STORAGE AREA PROVIDED = 5,285 C.F.


PATE ENGINEERS, INC. Project: SPRINGHILL SUITES NWE # 83100900

Manning's "n" = 0.012


RUNOFF COLLECTION POINT (Inlet or Manhole)	INCREMENTAL DRAINAGE AREA					Time at Upstream Station (min.)	Design Storm Freq. (years)	Intensity I (in./hr.)	Storm Water Runoff Q (cfs)	Slope of Hydraulic Gradient S (ft./ft.)	Storm Sewer Dia. (in.)	Velocity Between Points V (fps)	Coefficient of Headloss Manholes & Junctions (K)	Construct. Slope (ft./ft.)	Capacity (cfs)	Flow Time in Sewer (min.)	Hydraulic Gradient Elevations				
	Upstream Station	Downstream Station	Collection Points (ft.)	Area No.	Runoff Area (acres)												Incremental Area CA	Accumulated CA	Upstream	Downstream	
B7	B6	98	B7	0.30	0.9	0.27	0.27	10.0	100	8.74	2.38	0.001	15	2.03	1.25	0.003	3.81	0.81	629.86	629.76	
B6	B5	99	B6	0.26	0.9	0.23	0.50	10.81	100	8.54	4.34	0.001	18	2.46	0.50	0.003	6.26	0.67	629.72	629.57	
B5	B4	104	B5	0.26	0.9	0.23	0.74	11.48	100	8.38	6.23	0.003	18	3.53	0.50	0.003	6.21	0.49	629.48	629.16	
B4	B3	99	B4	0.15	0.9	0.13	1.30	11.97	100	8.26	10.79	0.003	21	4.71	0.50	0.003	9.45	0.35	629.00	628.63	
B3	B2	86	B3	0.14	0.9	0.13	1.42	12.32	100	8.17	11.72	0.002	24	4.08	0.50	0.003	13.47	0.35	628.50	628.34	
B2	B1	82	B2	0.12	0.9	0.11	1.53	12.67	100	8.09	12.47	0.003	24	4.54	0.50	0.003	13.53	0.30	628.18	627.98	
B1	JUNC	108	B1	0.13	0.9	0.12	1.65	12.97	100	8.02	13.31	0.0015	27	3.75	0.50	0.003	18.26	0.48	627.86	627.74	
BLDG #2	YDI #3	100		0.22	0.9	0.20	0.20	10.0	100	8.74	1.74	0.005	10	3.20	1.25	0.005	1.68	0.52	631.49	630.94	
BLDG #1	YDI #3	157		0.26	0.9	0.23	0.23	10.0	100	8.74	2.06	0.003	12	2.83	1.25	0.003	2.18	0.93	631.33	630.94	
YDI #3	B4	86					0.43	10.93	100	8.51	3.71	0.021	15	3.82	0.50	0.025	11.01	0.37	630.78	629.16	
A4	A3	86	A4	0.73	0.9	0.66	0.66	10.0	100	8.74	5.79	0.003	18	3.28	1.25	0.003	6.26	0.44	629.52	629.30	
A3	A2	206	A3	0.29	0.9	0.26	0.92	10.44	100	8.63	7.99	0.003	21	3.32	0.50	0.003	9.42	1.03	629.21	628.77	
A2	A1	131	A2	0.33	0.9	0.30	1.22	11.47	100	8.38	10.26	0.003	21	4.27	0.50	0.003	9.37	0.51	628.63	628.16	
A1	JUNC	42	A1	0.21	0.9	0.19	1.40	11.98	100	8.26	11.68	0.004	21	5.24	0.50	0.003	9.55	0.13	627.95	627.74	
JUNC	OUT	47.40						3.05	13.45	100	7.90	24.29	0.020	30	5.94	0.50	0.029	69.98	0.11	627.18	626.63

**INLET CAPACITY CALCULATIONS**  
 $Q = 4.82Ay^{1/2}$  WHERE: Q=DISCHARGE IN cfs  
A=AREA OF ORIFICE IN s.f.  
y=HEAD ON GRATE IN ft.

INLET	Q (25 YR) cfs	y ft.	REQUIRED GRATE OPEN AREA (A) s.f.	GRATE INLET MODEL NO. (NEENAH FOUNDRY)	GRATE DIMENSIONS	PROVIDED GRATE OPEN AREA (A) s.f.	Q (25 YR) CAPACITY cfs
A1	1.39	0.5	0.41	R-4370-3	15-INCH DIA.	0.4	1.36
A2	2.18	0.5	0.64	R-4370-4	15-INCH DIA.	0.6	2.05
A3	1.92	0.5	0.56	R-4370-4	15-INCH DIA.	0.6	2.05
A4	4.83	0.5	1.42	R-4370-9	22-INCH DIA.	1.3	4.43
B1	0.86	0.5	0.25	R-4370-2	9.5-INCH DIA.	0.2	0.68
B2	0.79	0.5	0.23	R-4370-2	9.5-INCH DIA.	0.2	0.68
B3	1.19	0.5	0.35	R-4370-3	15-INCH DIA.	0.4	1.36
B4	1.19	0.5	0.35	R-4370-3	15-INCH DIA.	0.4	1.36
B5	1.72	0.5	0.50	R-4370-4	15-INCH DIA.	0.6	2.05
B6	1.72	0.5	0.50	R-4370-3	15-INCH DIA.	0.4	1.36
B7	1.98	0.5	0.58	R-4370-4	15-INCH DIA.	0.6	2.05
SUM =	19.77					19.43	

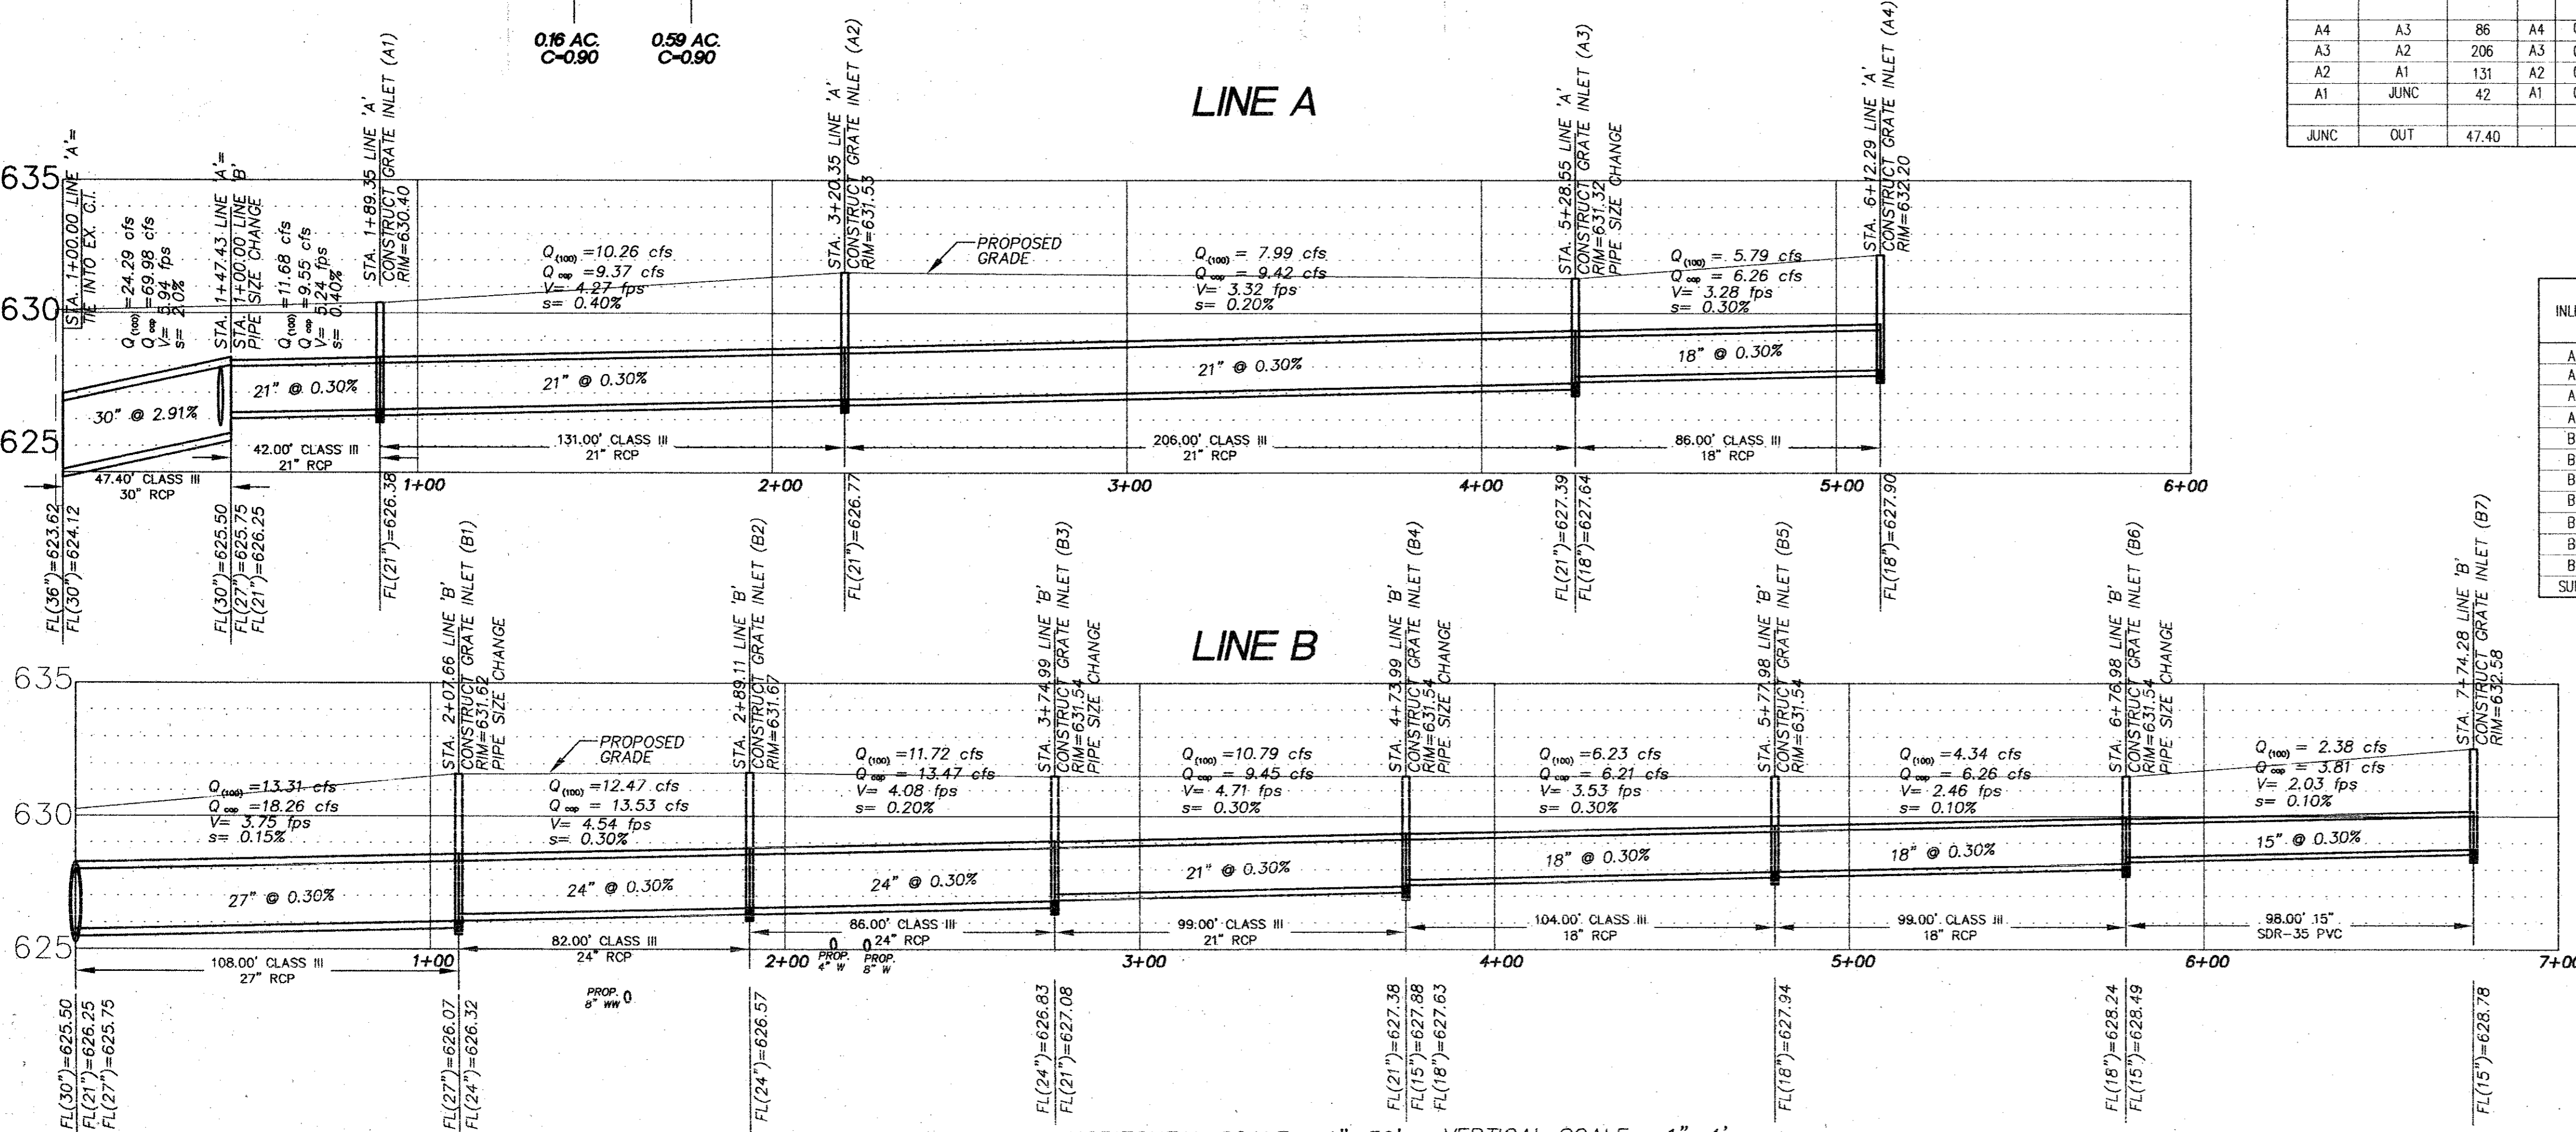

NO.	BY	DATE	REVISION
1	EAE	10/11/02	RECORD DRAWING

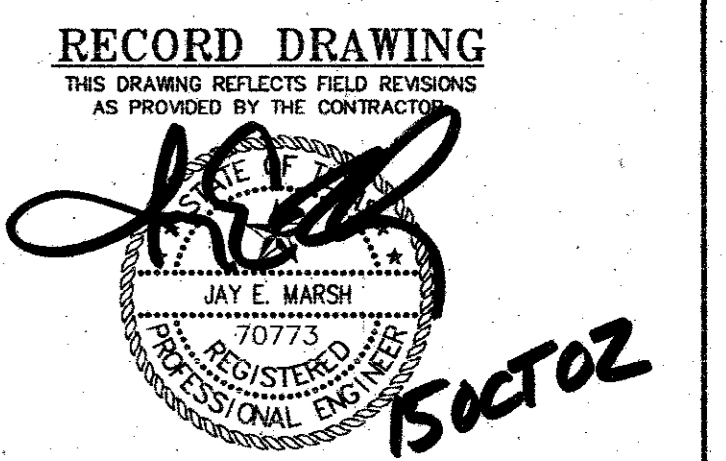

BENCHMARK:  
TOWN OF ADDISON, TEXAS, BENCHMARK NO. 3  
60D NAIL IN POWER POLE AT SOUTHEAST CORNER OF JULIAN ST. AND BROADWAY ST.  
ELEV. 632.50'

**DRAINAGE AREA MAP, CALCULATIONS & PROFILES**

**SPRINGHILL SUITES**

**TOWN OF ADDISON, TEXAS**

DRAWN	DESIGN	DATE	NOTES	SCALE	FILE	NUMBER
JPS	JEM	05/03/01	AS	AS NOTED	MARADA1	C4

**PATE ENGINEERS**  
8150 BROOKRIVER DRIVE  
SUITE S-700  
DALLAS, TEXAS, 75247  
TEL (214) 357-2981  
FAX (214) 357-2985  
JOB NO. 083100900

HORIZONTAL SCALE: 1"=30' VERTICAL SCALE: 1"=4'