





EDWIN LEWIS DRIVE
(FORMERLY ARAPAHO ROAD) (VARIABLE WIDTH RIGHT OF WAY)

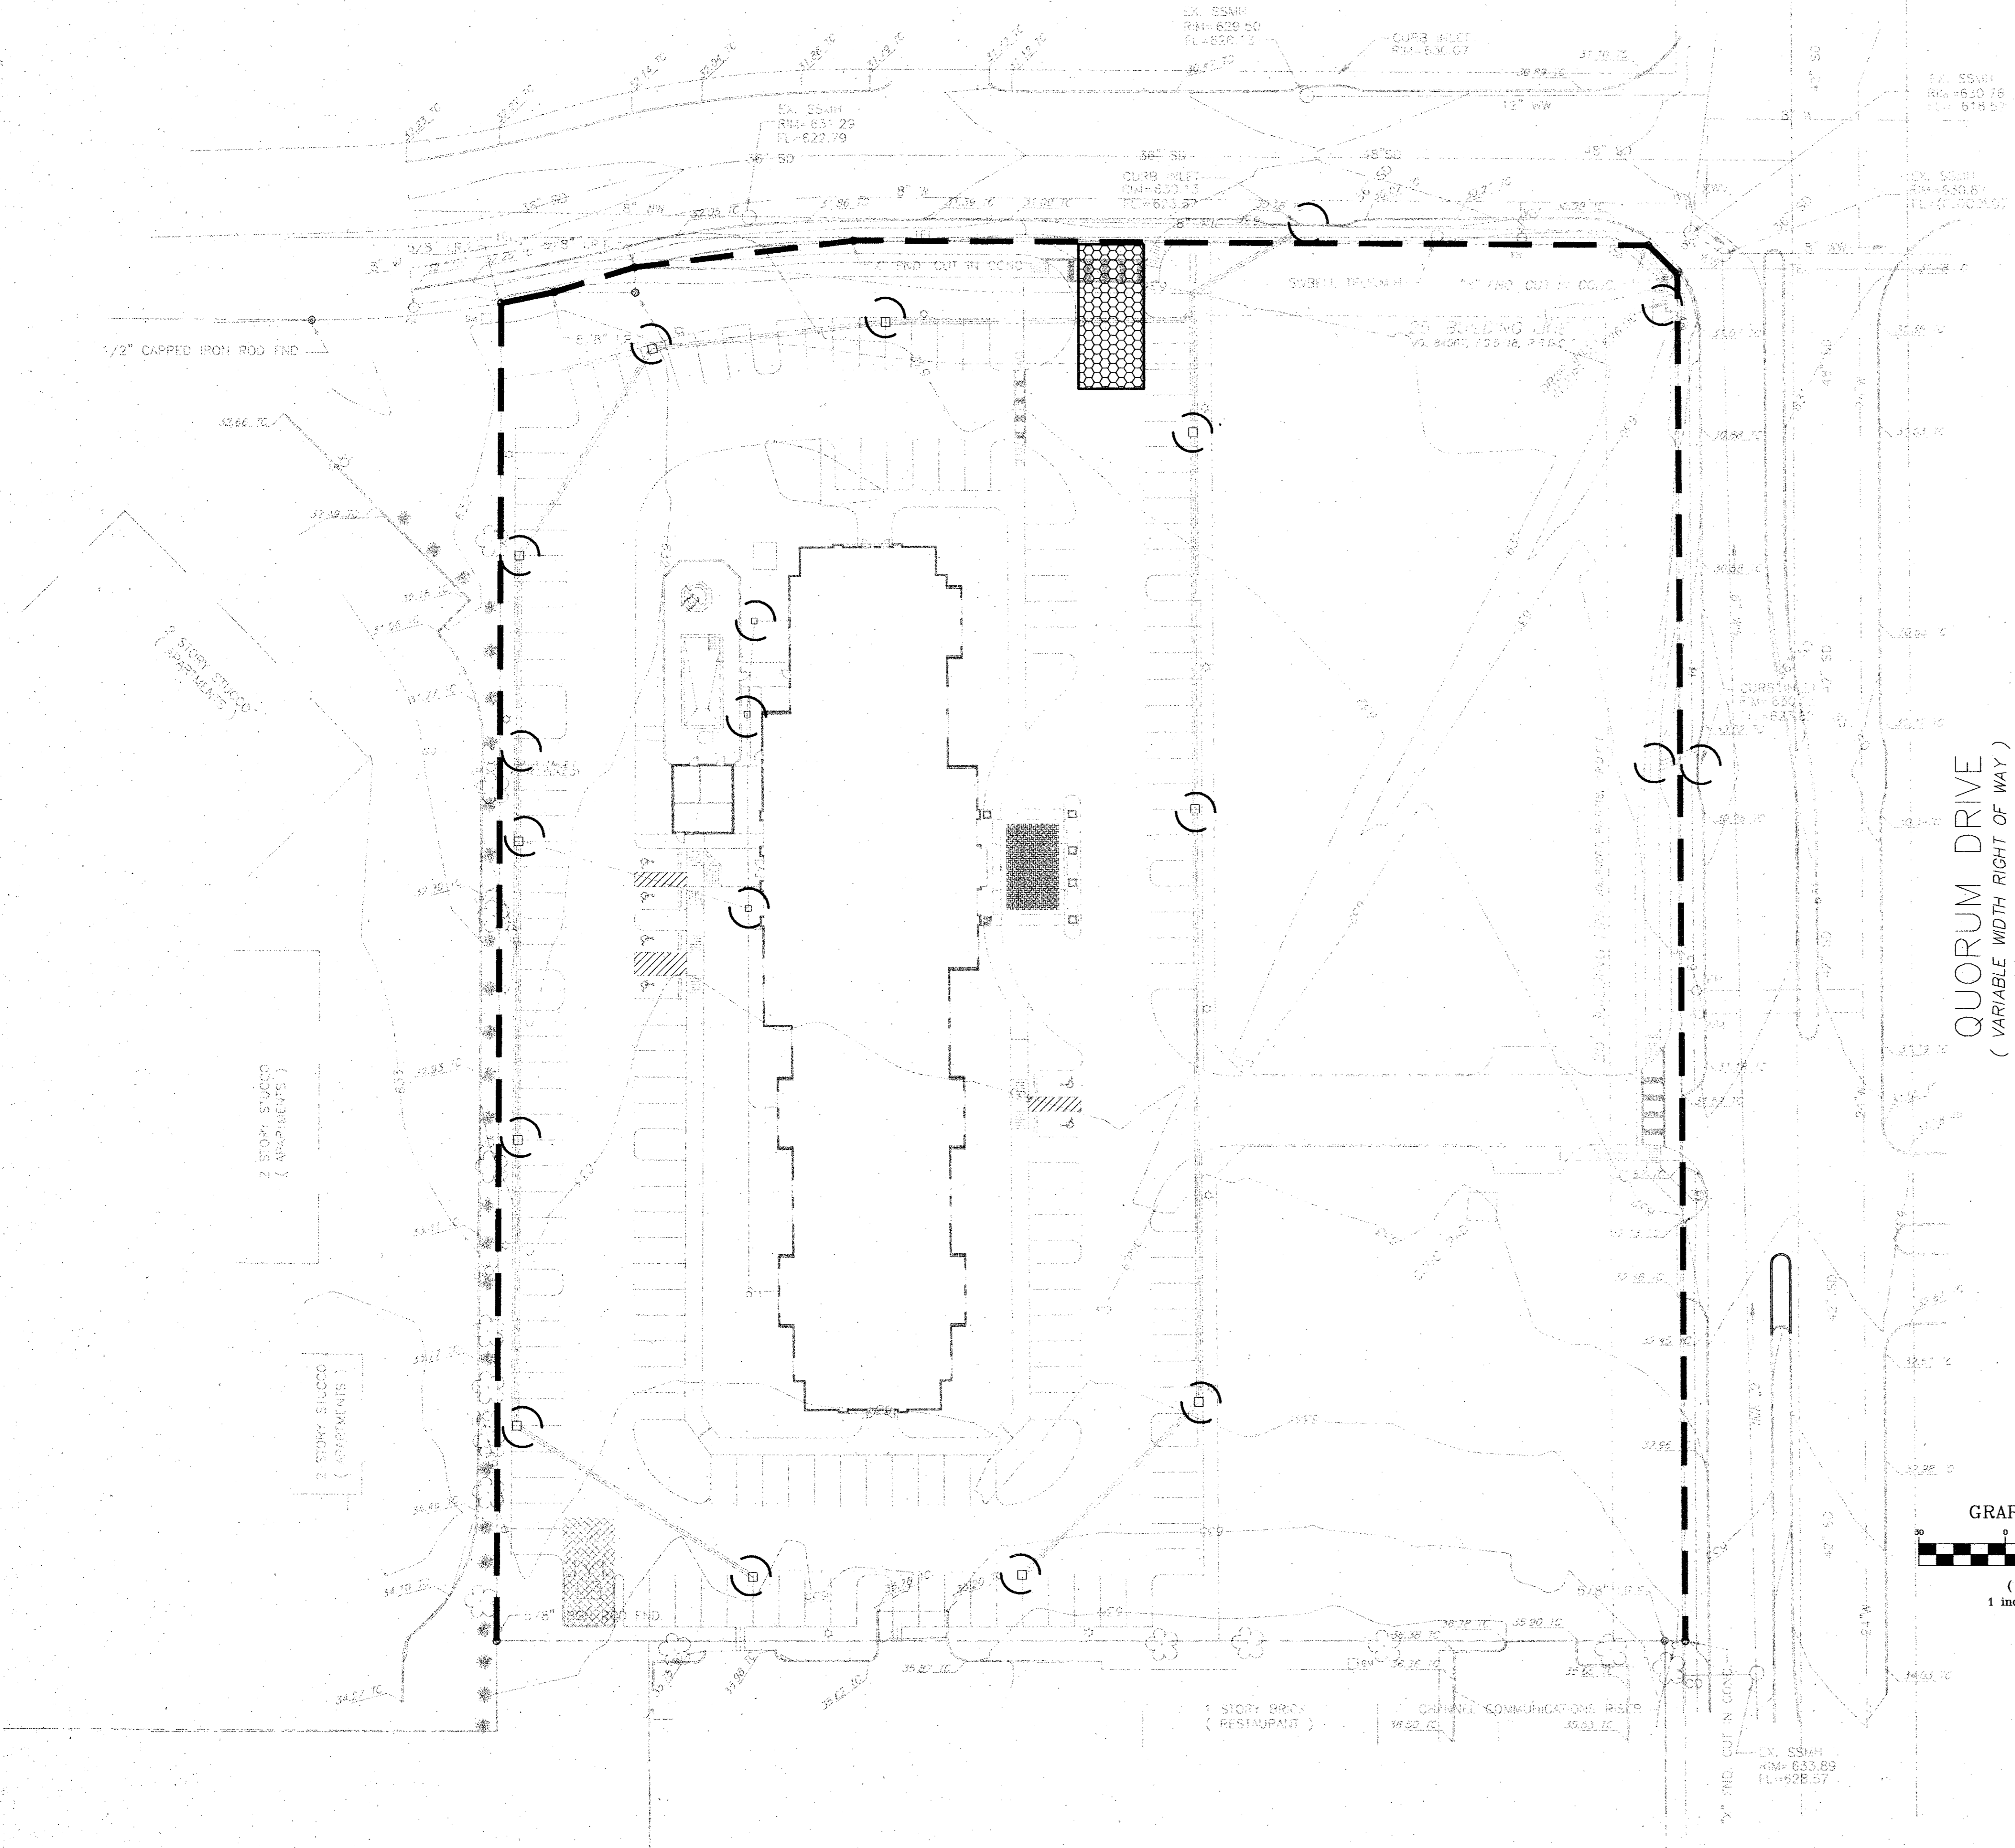

LEGEND:

-  EROSION CONTROL DEVICE TO BE INSTALLED PRIOR TO INITIAL GRADING (BY PROPOSED CONTRACTOR)
-  EROSION CONTROL DEVICE TO BE INSTALLED DURING UNDERGROUND UTILITY CONSTRUCTION (BY UTILITY CONTRACTOR)
-  CONSTRUCTION ENTRANCE (BY PROPOSED CONTRACTOR)

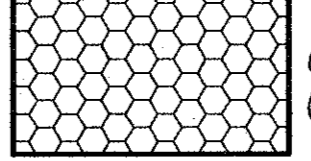BENCHMARK:
TOWN OF ADDISON, TEXAS, BENCHMARK NO. 3
60D NAIL IN POWER POLE AT SOUTHEAST CORNER
OF JULIAN ST. AND BROADWAY ST. ELEV. 632.50'

GRAPHIC SCALE
1 inch = 30 ft.

RECORD DRAWING
THIS DRAWING REFLECTS FIELD REVISIONS
AS PROVIDED BY THE CONTRACTOR

15OCT02

EROSION CONTROL PLAN																	
SPRINGHILL SUITES																	
TOWN OF ADDISON, TEXAS																	
NO.	BY	DATE	REVISION														
△	EAE	10/11/02	RECORD DRAWING														
<table border="1"> <thead> <tr> <th>DRAWN</th> <th>DESIGN</th> <th>DATE</th> <th>NOTES</th> <th>SCALE</th> <th>FILE</th> <th>NUMBER</th> </tr> </thead> <tbody> <tr> <td>JPS</td> <td>JEM</td> <td>05/03/01</td> <td>AS</td> <td>1" = 30'</td> <td>MARADEC1</td> <td>C7</td> </tr> </tbody> </table>				DRAWN	DESIGN	DATE	NOTES	SCALE	FILE	NUMBER	JPS	JEM	05/03/01	AS	1" = 30'	MARADEC1	C7
DRAWN	DESIGN	DATE	NOTES	SCALE	FILE	NUMBER											
JPS	JEM	05/03/01	AS	1" = 30'	MARADEC1	C7											
<p>PATE ENGINEERS 8150 BROOKRIVER DRIVE SUITE S-700 DALLAS, TEXAS, 75247 TEL (214) 357-2981 FAX (214) 357-2985 JOB NO. 083100900</p>																	