

CONSTRUCTION PLANS SPRINGHILL SUITES

QUORUM DRIVE AT EDWIN LEWIS DRIVE

TOWN OF ADDISON, TEXAS


FOR

PORTION OF

QUORUM CENTRE ADDITION

4.5 ACRES

ZONED PD

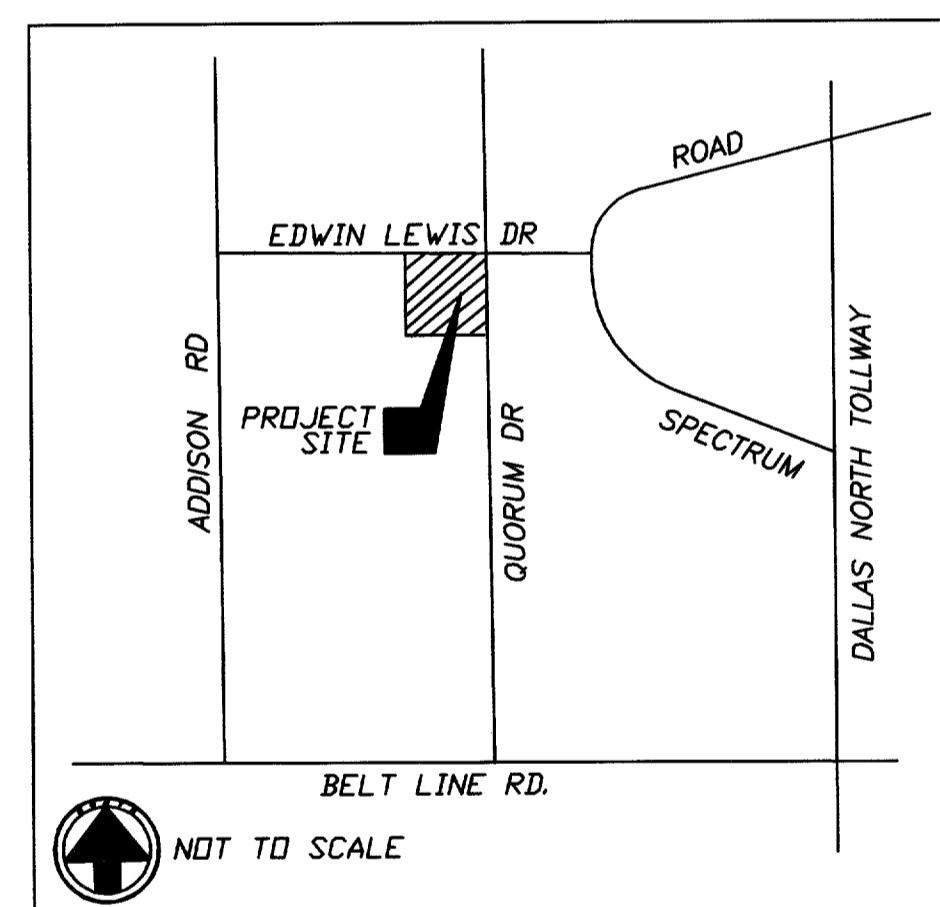

SHEET INDEX

NO.	TITLE
	COVER SHEET
C1	NOTES AND LEGEND
C2	DIMENSION CONTROL & PAVING
C3	GRADING PLAN
C4	DRAINAGE AREA MAP, CALCULATIONS & PROFILES
C5	DRAINAGE PLAN
C6	UTILITY PLAN
C7	EROSION CONTROL PLAN
C8	EROSION CONTROL NOTES
D1	MISCELLANEOUS PAVING DETAILS
D2	MISCELLANEOUS PAVING DETAILS
D3	EROSION CONTROL DETAILS

TOWN OF ADDISON, TEXAS VICINITY MAP

PATE ENGINEERS

8150 BROOKRIVER DRIVE
SUITE S-700
DALLAS, TEXAS, 75247
TEL (214) 357-2981
FAX (214) 357-2985

JOB NO. 083100900


OWNER:

WESTERN INTERNATIONAL
12850 SPURLING DRIVE SUITE 114
DALLAS, TEXAS 75230
PH: (972) 934-8699
CONTACT: MIKE MAHONEY

CONTACT: JAY E. MARSH, P.E.

RECORD DRAWING

THIS DRAWING REFLECTS FIELD REVISIONS
AS PROVIDED BY THE CONTRACTOR.

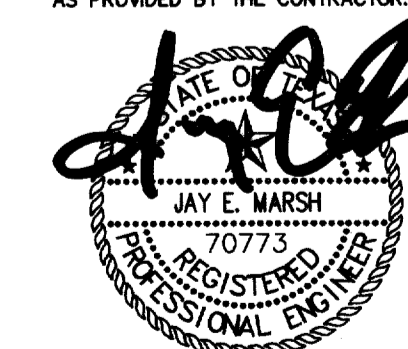

15OCT02

MAY 3, 2001
JOB NO. 083100900