

Q=CIA

PEI#: 083100900

Project Name: Springhill Addition  
By: JEM

Drainage Area (ac.): 2.91  
Design Storm (yrs): 100

Proposed Conditions (25 YR.)  
C = 0.90  
Tc (min.) = 10.0  
I (in/hr) = 7.3  
Q (cfs) = 19.09


Proposed Conditions (100 YR.)  
C = 0.90  
Tc (min.) = 10.0  
I (in/hr) = 8.7  
Q (cfs) = 22.89

Storm Duration	I (in/hr)	Q (cfs)	Inflow (cu.ft.)	Outflow (cu.ft.)	Storage (cu.ft.)
5.0	10.5	27.5	8242.0	8591.6	-349.6
10.0	8.7	22.9	13734.0	11455.5	2278.5
15.0	7.5	19.7	17725.4	14319.4	3406.0
20.0	6.8	17.8	21371.0	17183.3	4187.8
30.0	5.8	15.1	27106.7	22911.0	4195.6
40.0	5.0	13.1	31428.0	28638.8	2789.2
50.0	4.5	11.7	34963.7	34366.5	597.1
60.0	3.9	10.2	36865.0	40094.3	-3229.2
120.0	2.6	6.9	49404.8	74460.8	-25056.0
180.0	1.9	5.0	54024.7	108827.3	-54802.6
240.0	1.5	4.0	60000.0	143193.8	-143193.8

PROVIDED STORAGE VOLUME ON-SITE

AREA DESIGNATION	PROVIDED VOLUME (C.F.)
A1	427
A2	146
A3	592
A4	742
B1	550
B2	471
B3	473
B4	336
B5	473
B6	475
B7	600
SUM =	5,285

STORAGE AREA REQUIRED = 4,195.6 C.F.  
STORAGE AREA PROVIDED = 5,285 C.F.

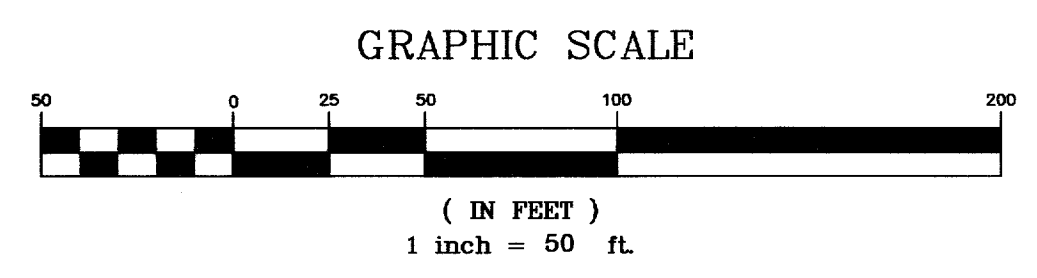

PATE ENGINEERS, INC. Project: SPRINGHILL SUITES NWE #: 83100900

Manning's "n" = 0.012

Upstream Station	Downstream Station	Distance Between Collection Points (ft)	INCREMENTAL DRAINAGE AREA				Time at Upstream Station (min.)	Design Storm Freq. (years)	Intensity I (in/hr.)	Storm Water Runoff Q (cfs)	Slope of Hydraulic Gradient S (ft./ft.)	Storm Sewer Dia. (in.)	Velocity Between Points V (fps)	Coefficient of Headloss Manholes & Junctions (Kj)	Construct. Slope (ft./ft.)	Capacity (cfs)	Flow Time in Sewer (min.)	Hydraulic Gradient Elevations			
			Area (acres)	Runoff Coeff. C	Incremental Area CA	Accumulated CA												Upstream	Downstream		
B7	B6	98	B7	0.30	0.9	0.27	0.27	10.0	100	8.74	2.38	0.001	15	2.03	1.25	0.003	3.81	0.81	629.86	629.76	
B6	B5	99	B6	0.26	0.9	0.23	0.50	10.81	100	8.54	4.34	0.001	18	2.46	0.50	0.003	6.26	0.67	629.72	629.57	
B5	B4	104	B5	0.26	0.9	0.23	0.74	11.48	100	8.38	6.23	0.003	18	3.53	0.50	0.003	6.21	0.49	629.48	629.16	
B4	B3	99	B4	0.15	0.9	0.13	1.30	11.97	100	8.26	10.79	0.003	21	4.71	0.50	0.003	9.45	0.35	629.00	628.63	
B3	B2	86	B3	0.14	0.9	0.13	1.42	12.32	100	8.17	11.72	0.002	24	4.08	0.50	0.003	13.47	0.35	628.50	628.34	
B2	B1	82	B2	0.12	0.9	0.11	1.53	12.67	100	8.09	12.47	0.003	24	4.54	0.50	0.003	13.53	0.30	628.18	627.98	
B1	JUNC	106	B1	0.13	0.9	0.12	1.65	12.97	100	8.02	13.31	0.0015	27	3.75	0.50	0.003	18.26	0.48	627.86	627.74	
BLDG #2	YDI #3	100		0.22	0.9	0.20	0.20	10.0	100	8.74	1.74	0.005	10	3.20	1.25	0.005	1.68	0.52	631.49	630.94	
BLDG #1	YDI #3	157		0.26	0.9	0.23	0.23	10.0	100	8.74	2.06	0.003	12	2.83	1.25	0.003	2.18	0.93	631.33	630.94	
YDI #3	B4	86		0.26	0.9	0.23	0.23	10.93	100	8.51	3.71	0.021	15	3.82	0.50	0.025	11.01	0.37	630.78	629.16	
A4	A3	86	A4	0.73	0.9	0.66	0.66	10.0	100	8.74	5.79	0.003	18	3.28	1.25	0.003	6.26	0.44	629.52	629.30	
A3	A2	206	A3	0.29	0.9	0.26	0.92	10.44	100	8.63	7.99	0.003	21	3.32	0.50	0.003	9.42	1.03	629.21	628.77	
A2	A1	131	A2	0.33	0.9	0.30	1.22	11.47	100	8.38	10.26	0.003	21	4.27	0.50	0.003	9.37	0.51	628.63	628.16	
A1	JUNC	42	A1	0.21	0.9	0.19	1.40	11.98	100	8.26	11.68	0.004	21	5.24	0.50	0.003	9.55	0.13	627.95	627.74	
JUNC	OUT	47.40						3.05	13.45	100	7.90	24.29	0.020	30	5.94	0.50	0.029	69.98	0.11	627.18	626.63

**INLET CAPACITY CALCULATIONS**  
Q=4.82Ay<sup>1.48</sup> WHERE: Q=DISCHARGE IN cfs  
A=AREA OF ORIFICE IN s.f.  
y=HEAD ON GRATE IN ft.

INLET	Q (25 YR) cfs	y ft.	REQUIRED GRATE OPEN AREA (A) s.f.	GRATE INLET MODEL NO. (NEENAH FOUNDRY)	GRATE DIMENSIONS	PROVIDED GRATE OPEN AREA (A) s.f.	Q (25 YR) CAPACITY cfs
A1	1.39	0.5	0.41	R-4370-3	15-INCH DIA.	0.4	1.36
A2	2.18	0.5	0.64	R-4370-4	15-INCH DIA.	0.6	2.05
A3	1.92	0.5	0.56	R-4370-4	15-INCH DIA.	0.6	2.05
A4	4.83	0.5	1.42	R-4370-9	22-INCH DIA.	1.3	4.43
B1	0.86	0.5	0.25	R-4370-2	9.5-INCH DIA.	0.2	0.68
B2	0.79	0.5	0.23	R-4370-2	9.5-INCH DIA.	0.2	0.68
B3	1.19	0.5	0.35	R-4370-3	15-INCH DIA.	0.4	1.36
B4	1.19	0.5	0.35	R-4370-3	15-INCH DIA.	0.4	1.36
B5	1.72	0.5	0.50	R-4370-4	15-INCH DIA.	0.6	2.05
B6	1.72	0.5	0.50	R-4370-3	15-INCH DIA.	0.4	1.36
B7	1.98	0.5	0.58	R-4370-4	15-INCH DIA.	0.6	2.05
SUM	19.77					19.43	

**RECORD DRAWING**  
THIS DRAWING REFLECTS FIELD REVISIONS AS PROVIDED BY THE CONTRACTOR.

NO.	BY	DATE	REVISION
1	EAE	10/11/02	RECORD DRAWING

BENCHMARK:  
TOWN OF ADDISON, TEXAS, BENCHMARK NO. 3  
600 NAIL IN POWER POLE AT SOUTHEAST CORNER OF JULIAN ST. AND BROADWAY ST.  
ELEV. 632.50'



**PATE ENGINEERS**  
8150 BROOKRIVER DRIVE  
SUITE S-700  
DALLAS, TEXAS, 75247  
TEL (214) 357-2981  
FAX (214) 357-2985  
JOB NO. 083100900

**DRAINAGE AREA MAP, CALCULATIONS & PROFILES**

**SPRINGHILL SUITES**

**TOWN OF ADDISON, TEXAS**

DRAWN	DESIGN	DATE	NOTES	SCALE	FILE	NUMBER
JPS	JEM	05/03/01	AS	AS NOTED	MARADDA1	C4

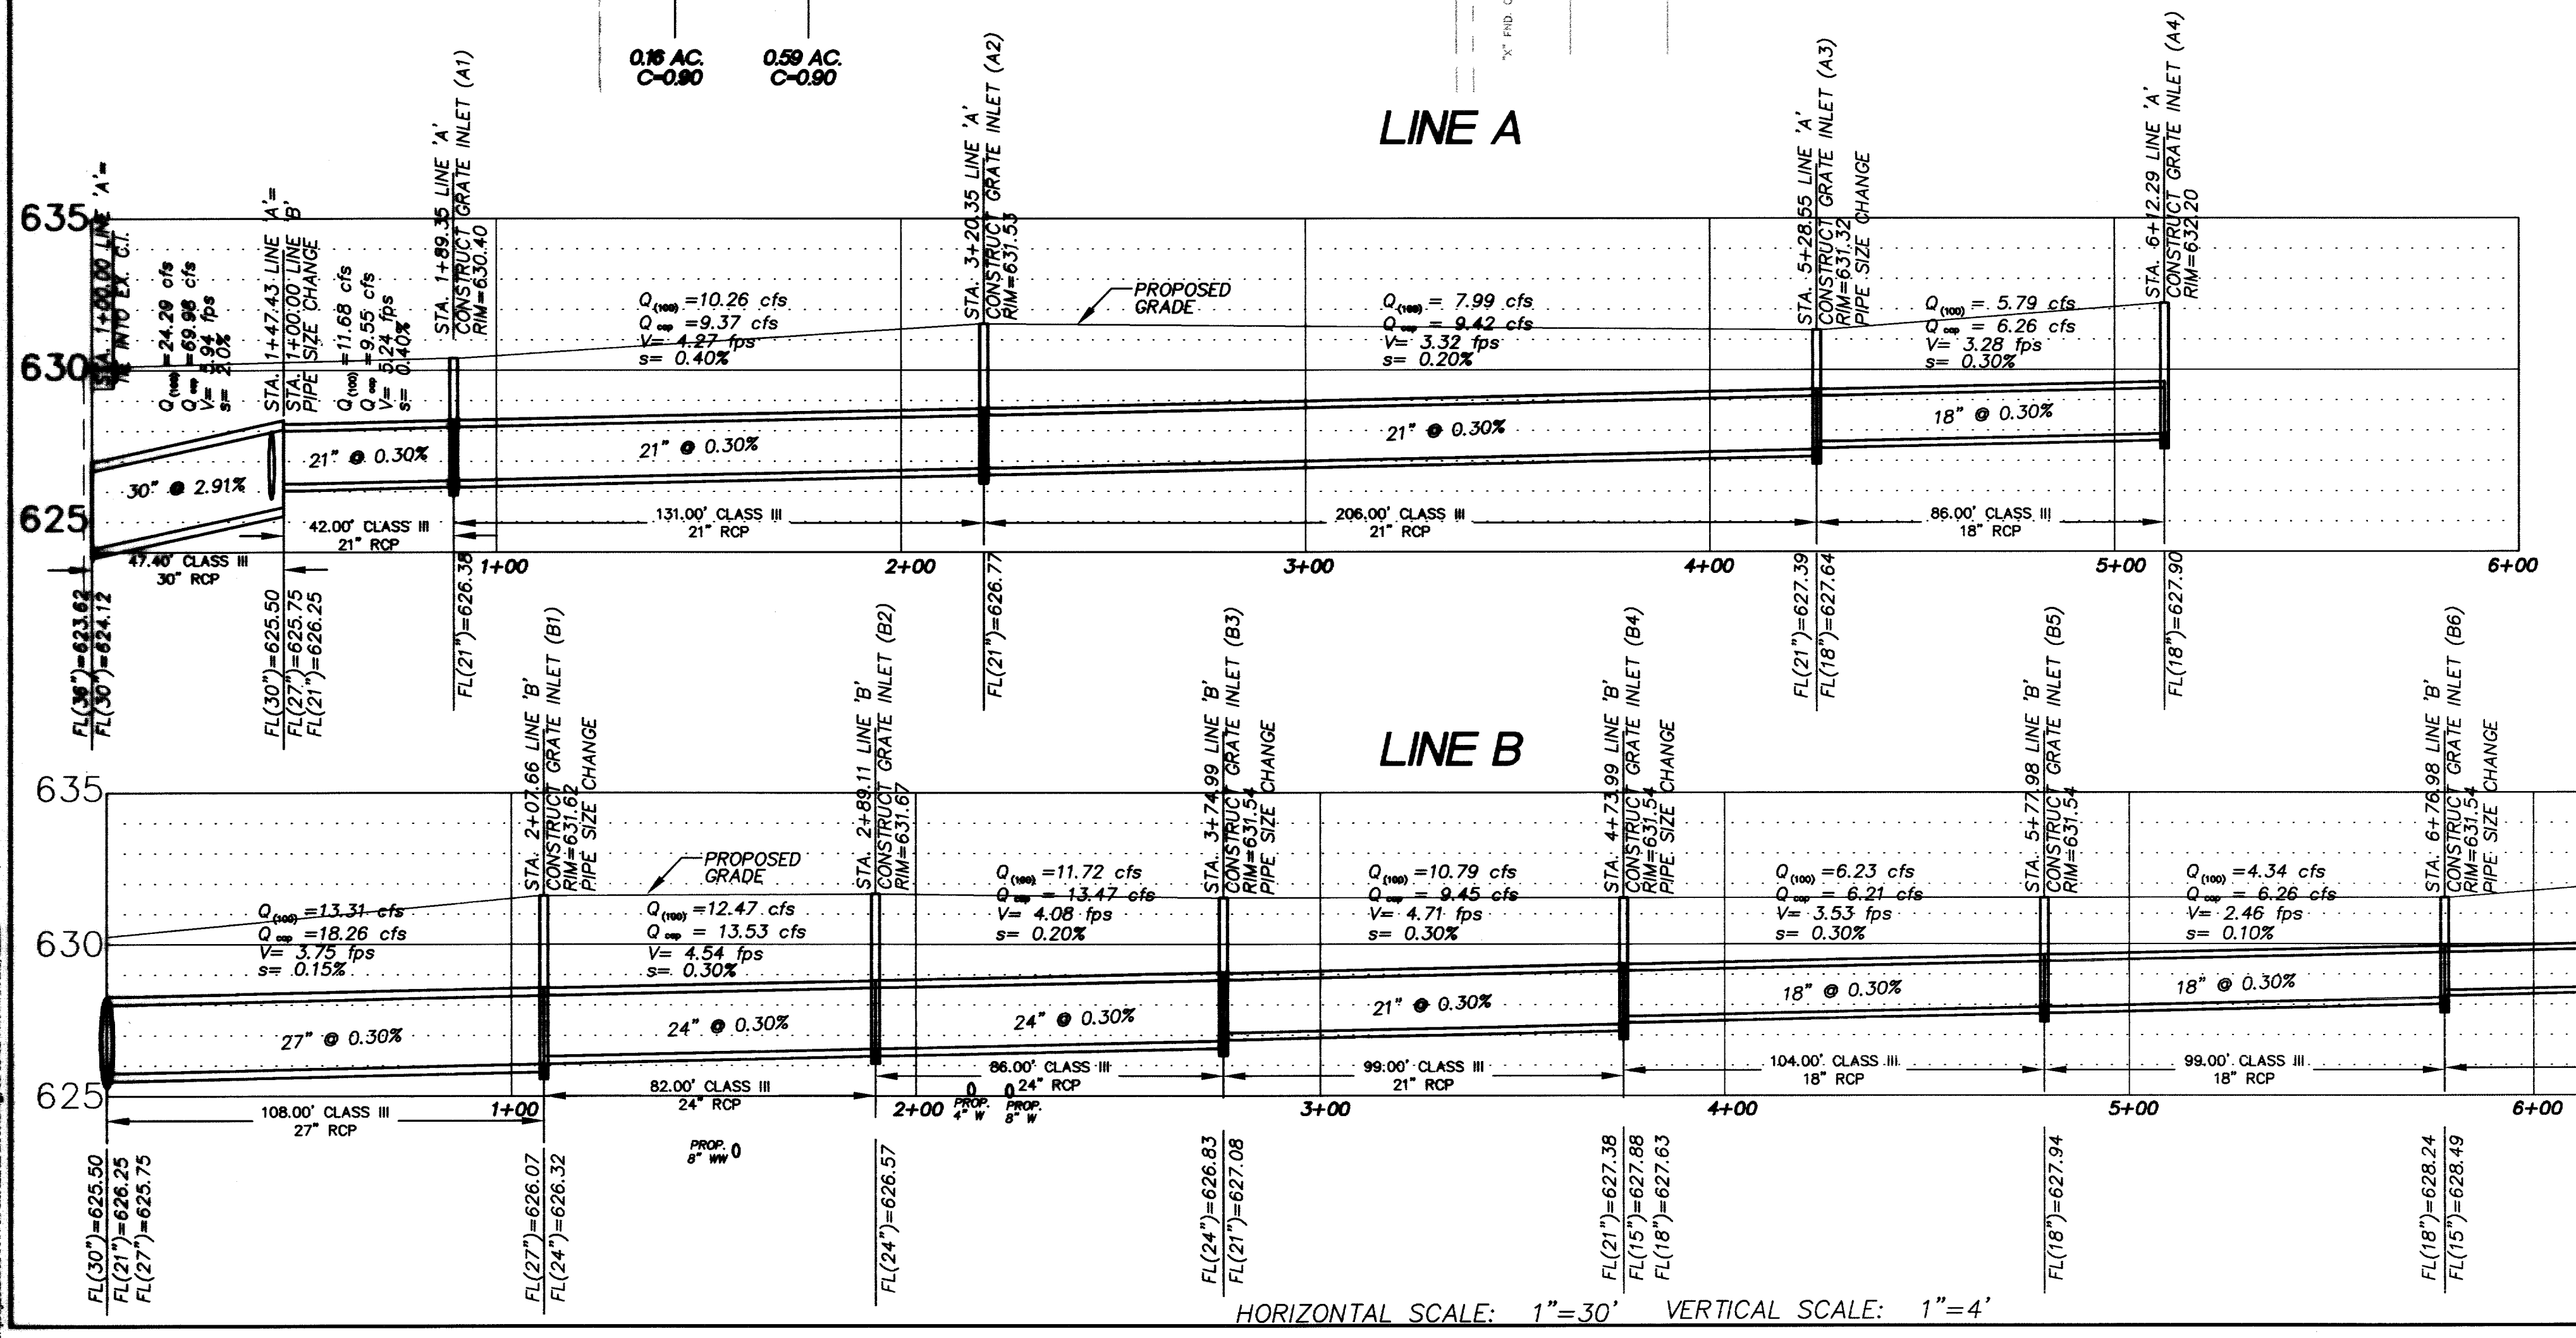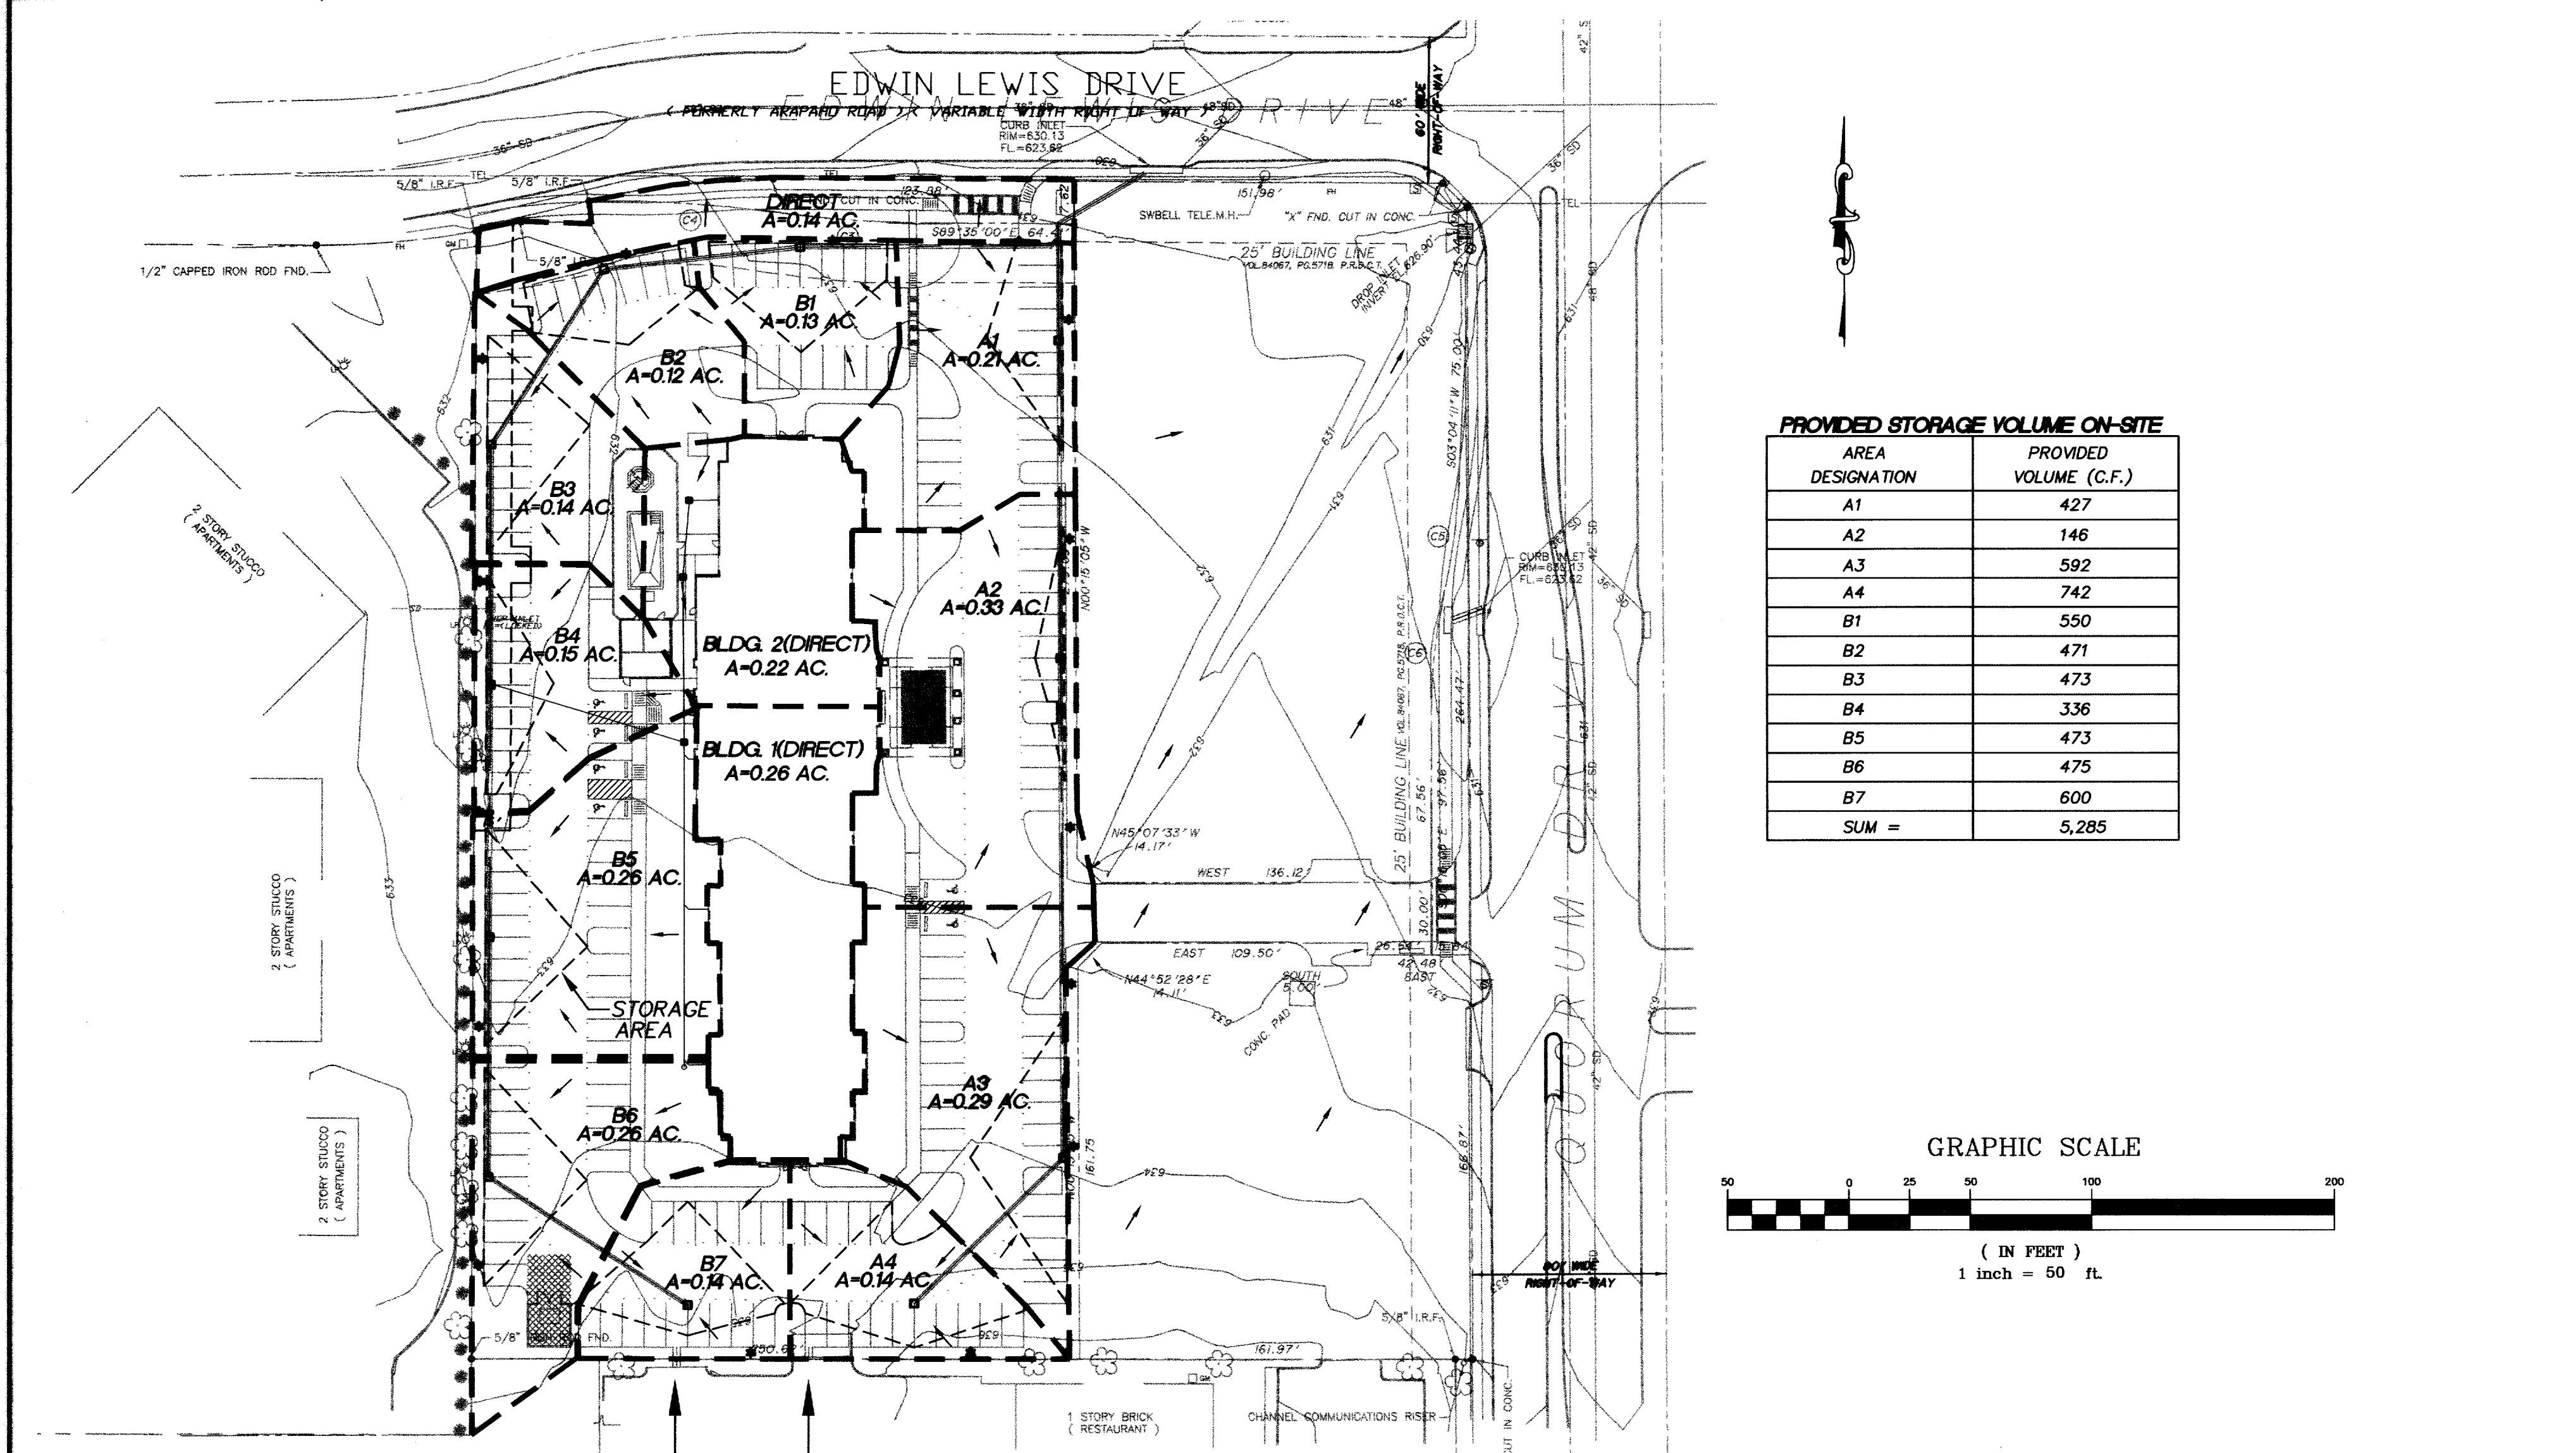

HORIZONTAL SCALE: 1"=30' VERTICAL SCALE: 1"=4'