

SEAL:
 PROGRESS SET - FOR REVIEW ONLY
 Issued 9/27/18

This drawing and all parts of it are the property of Mayse & Associates, Inc. and no part of it may be reproduced, stored in a retrieval system, or transmitted in any form or by any means, electronic, mechanical, photocopying, recording, or by any information storage and retrieval system, without the prior written consent of Mayse & Associates, Inc. Mayse & Associates, Inc. reserves all other rights, including the copyright.

R. Phillip Brigger, P.E. #120083
 Raymond L. Goodson, Jr., Inc.

This drawing and all parts of it are the property of Mayse & Associates, Inc. and no part of it may be reproduced, stored in a retrieval system, or transmitted in any form or by any means, electronic, mechanical, photocopying, recording, or by any information storage and retrieval system, without the prior written consent of Mayse & Associates, Inc. Mayse & Associates, Inc. reserves all other rights, including the copyright.

RAYMOND L. GOODSON, JR., INC.
 CONSULTING ENGINEERS
 12001 N. GULF Fwy., Suite 100
 Dallas, Texas 75247 214/728-8100
 E-Mail: rlg@rlginc.com FAX: 214/728-8103

Engineer:

WESTERN INTERNATIONAL OFFICE BUILDING
 15275 QUORUM DR.
 ADDISON, TX 75001





WESTERN INTERNATIONAL
 13647 MONFORT DRIVE
 DALLAS, TX 75240

Revisions:
09 21 2018 PERMIT ISSUE
 9/27/2018 - ADDENDUM #1
 CIVIL COMMENTS

BENCHMARKS:
 BM#1
 BRASS DISC AT THE SOUTHWEST CORNER OF A 10' CURB INLET, ON THE WEST SIDE OF QUORUM DRIVE, 186 FEET ± SOUTH OF EDWIN LEWIS ROAD AS SHOWN.
 ELEVATION = 630.11

SHEET NO.
C5.00

STORM SEWER PLAN						
WESTERN INTERNATIONAL OFFICE BUILDING						
WESTERN INTERNATIONAL						
MAYSE & ASSOCIATES INC.						
TOWN OF ADDISON, TEXAS						
DESIGN	DRAWN	DATE	SCALE	XREF	FILE	NO.
RLG	RLG	9/27/18	1"=20'	1813.013	1813	013
JOB NO.	SUBMITTAL:					
1813.013						

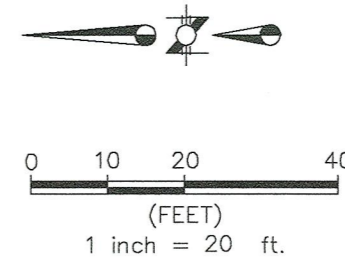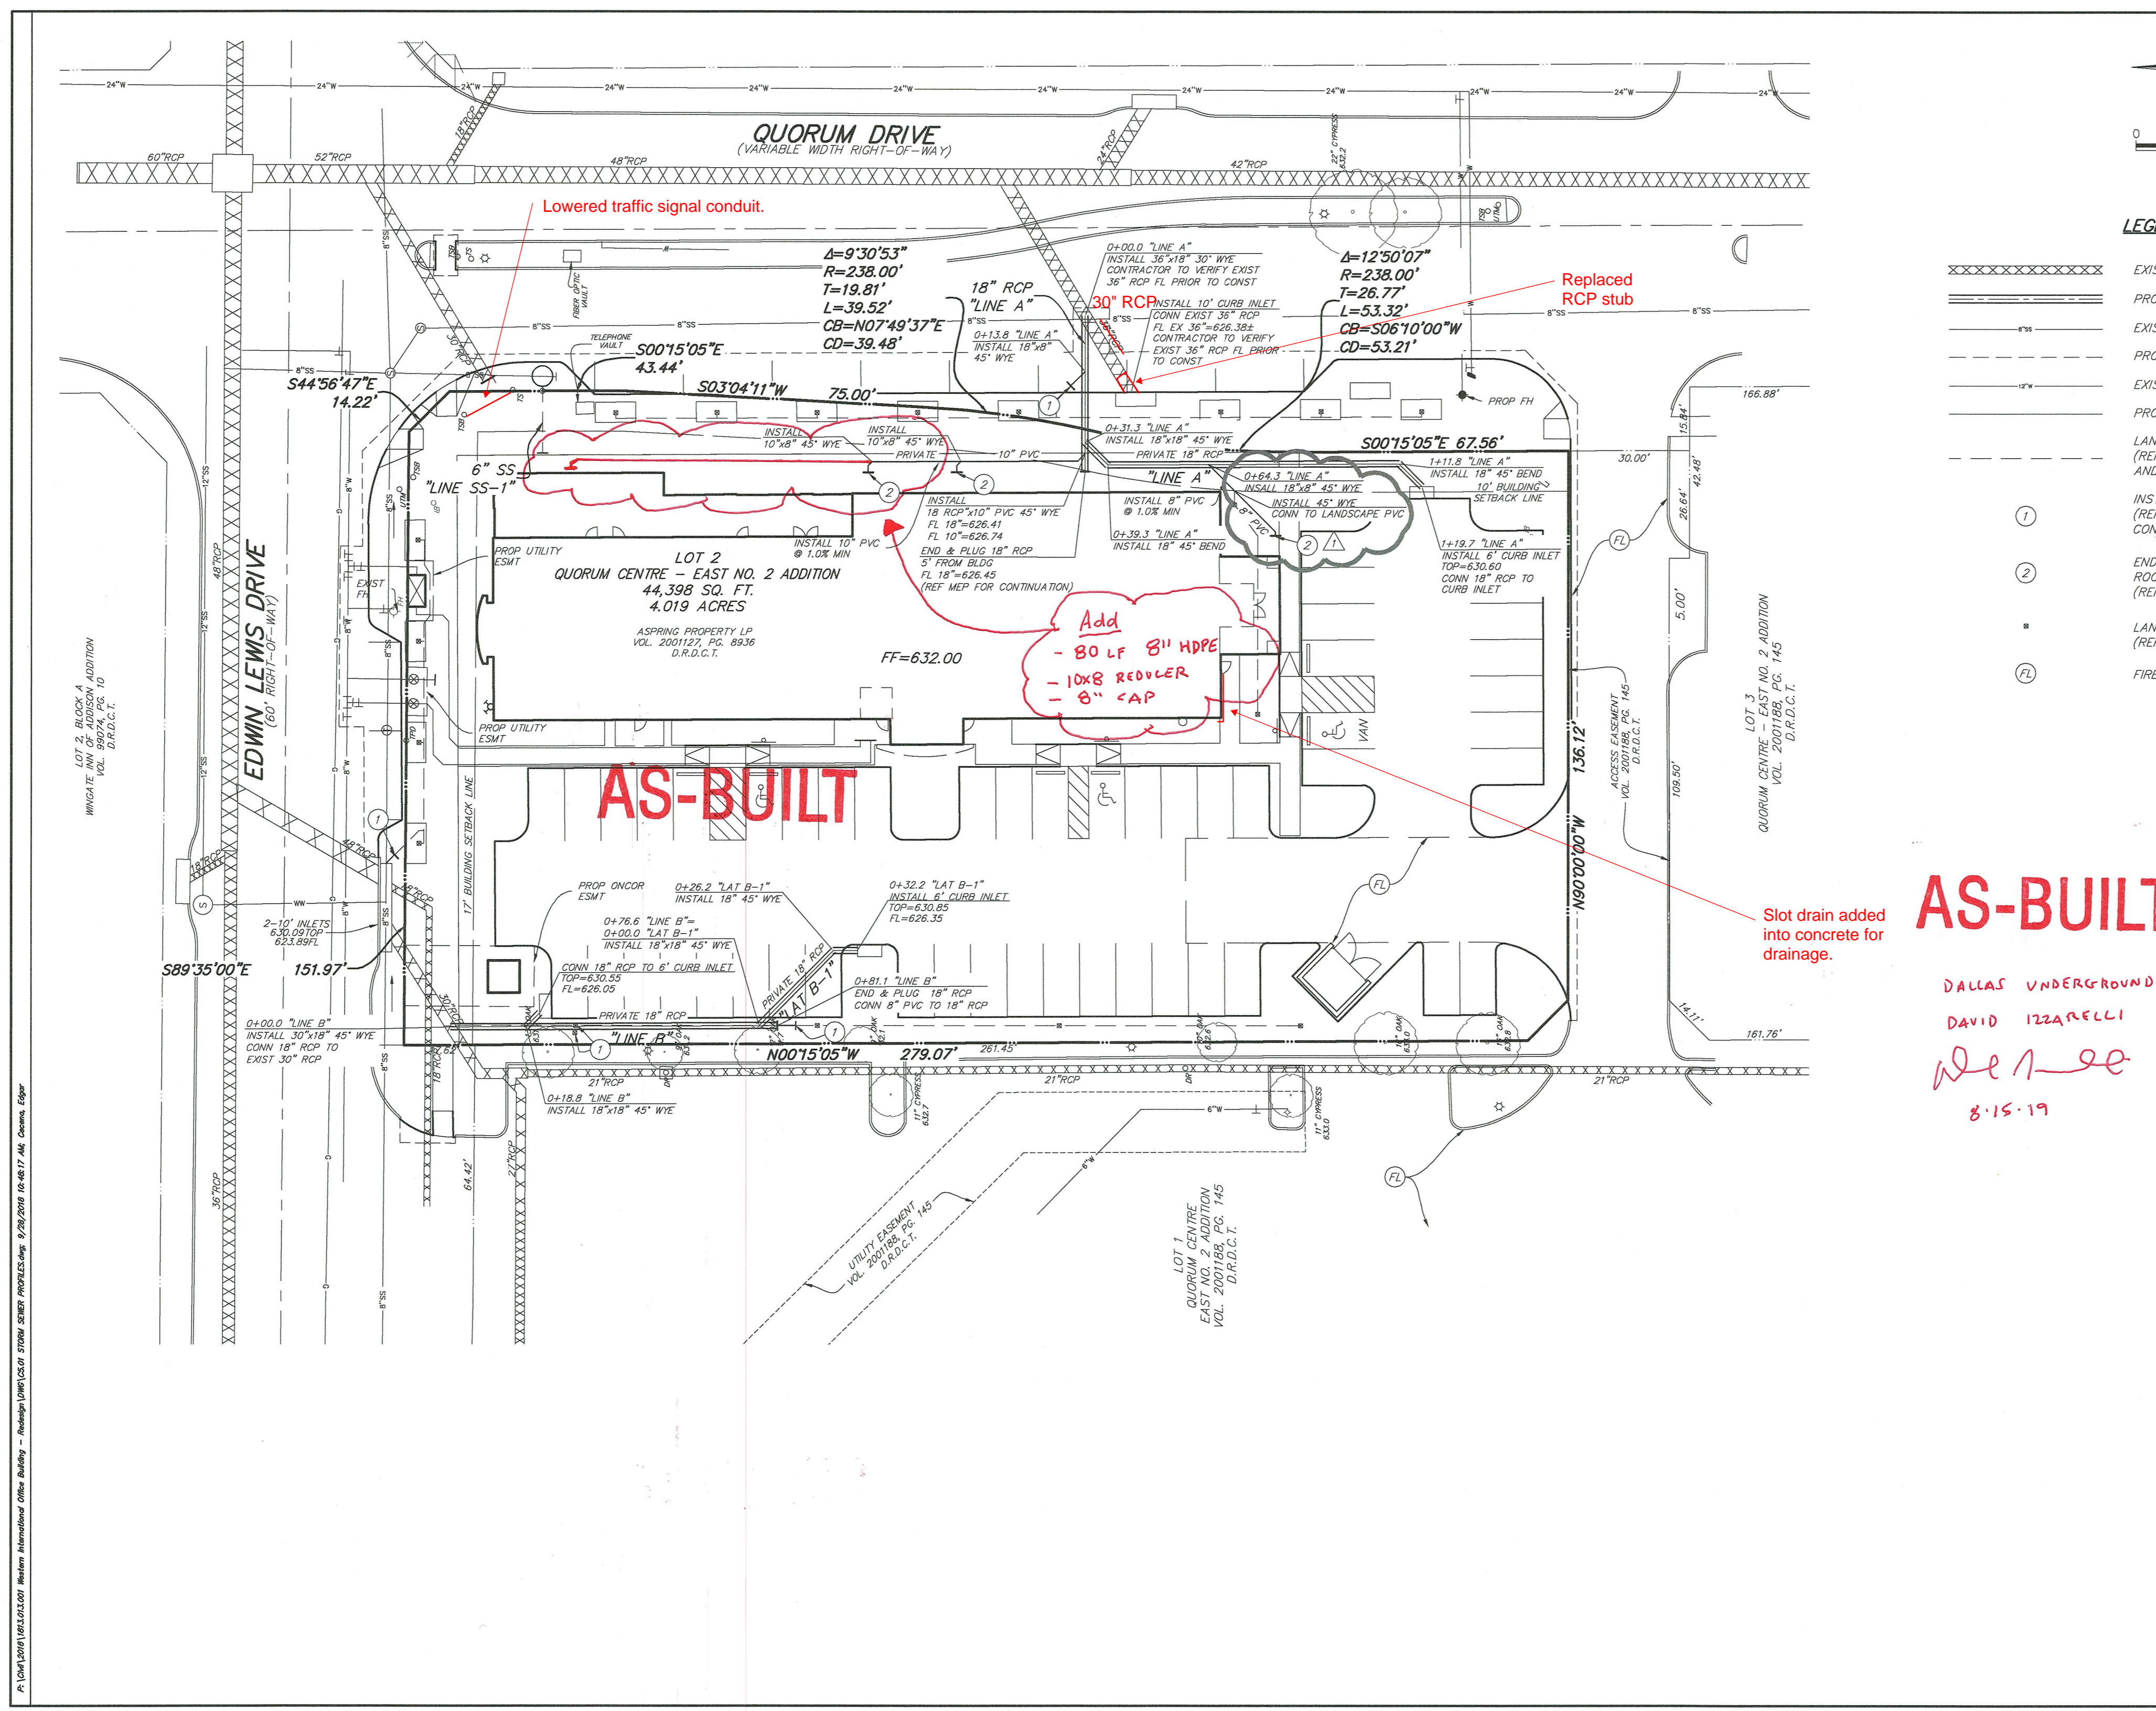

LEGEND

- XXXXXX EXISTING STORM SEWER
- PROPOSED STORM SEWER LINE
- EXISTING SANITARY SEWER LINE
- PROPOSED SANITARY SEWER LINE
- EXISTING WATER LINE
- PROPOSED WATER LINE
- LANDSCAPE PVC (REF LANDSCAPE FOR SIZE AND LOCATION)
- ① INSTALL 8" PVC (REF LANDSCAPE FOR CONNECTION)
- ② END AND PLUG 8" PVC (REF LANDSCAPE FOR CONNECTION)
- LANDSCAPE AREA DRAIN (REF LANDSCAPE PLANS)
- FIRE LANE

AS-BUILT

DALLAS UNDERGROUND LLC
 DAVID IZZARELLI
 We see
 8.15.19

Slot drain added into concrete for drainage.

Add
 - 80 LF 8" HDPE
 - 10x8 REVDLER
 - 8" CAP

AS-BUILT