


**BENCHMARKS:**  
 BM#1  
 BRASS DISC AT THE SOUTHWEST  
 CORNER OF A 10' CURB INLET, ON  
 THE WEST SIDE OF QUORUM DRIVE,  
 186 FEET ± SOUTH OF EDWIN LEWIS  
 ROAD AS SHOWN.  
 ELEVATION = 630.11

**RLG** RAYMOND L. GOODSON JR., INC.  
 CONSULTING ENGINEERS  
 12001 N. CENTRAL EXPRESSWAY, SUITE 300  
 DALLAS, TEXAS 75243 214/739-8100  
 E-MAIL: rlg@rlginc.com FIRM REG. F-493

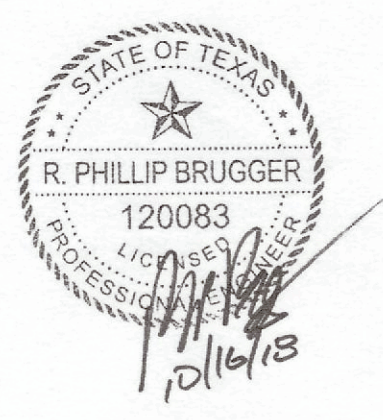

**ADDISON**

**APPROVED FOR CONSTRUCTION**  
 INFRASTRUCTURE & DEVELOPMENT SERVICES

BY: *[Signature]*  
 DATE: 10/16/18

IN APPROVING THESE PLANS, THE TOWN OF ADDISON ASSUMES NO RESPONSIBILITY  
 FOR THEIR ADEQUACY, WHICH REMAINS WITH THE ENGINEER OF RECORD.

18801 WEST GROVE DRIVE, ADDISON, TX 75001 - (972) 450-2871

SHEET NO.  
**C5.01**

<b>STORM SEWER PROFILES</b>					
<b>WESTERN INTERNATIONAL OFFICE BUILDING</b>					
<b>WESTERN INTERNATIONAL</b>					
<b>MAYSE &amp; ASSOCIATES INC.</b>					
<b>TOWN OF ADDISON, TEXAS</b>					
DESIGN	DRAWN	DATE	SCALE	XREF	FILE
RLG	RLG	10/16/18	H: 1"=20' V: 1"=5'	1813.013	1813 013
JOB NO.	1813.013 SUBMITTAL:				

P:\CWA\2018\1813\013\001 Western International Office Building - Redevelop LIME (CLOT) STORM SEWER PROFILES.dwg 10/15/2018 10:46:54 AM C:\Users\...