



- LEGEND**
- XXXXXX EXISTING STORM SEWER
  - ===== PROPOSED STORM SEWER LINE
  - EXISTING SANITARY SEWER LINE
  - PROPOSED SANITARY SEWER LINE
  - EXISTING WATER LINE
  - PROPOSED WATER LINE
  - LANDSCAPE PVC (REF LANDSCAPE FOR SIZE AND LOCATION)
  - FL FIRE LANE
  - ① 6" 45' BEND
  - ② 2" 45' BEND

**AS-BUILT**

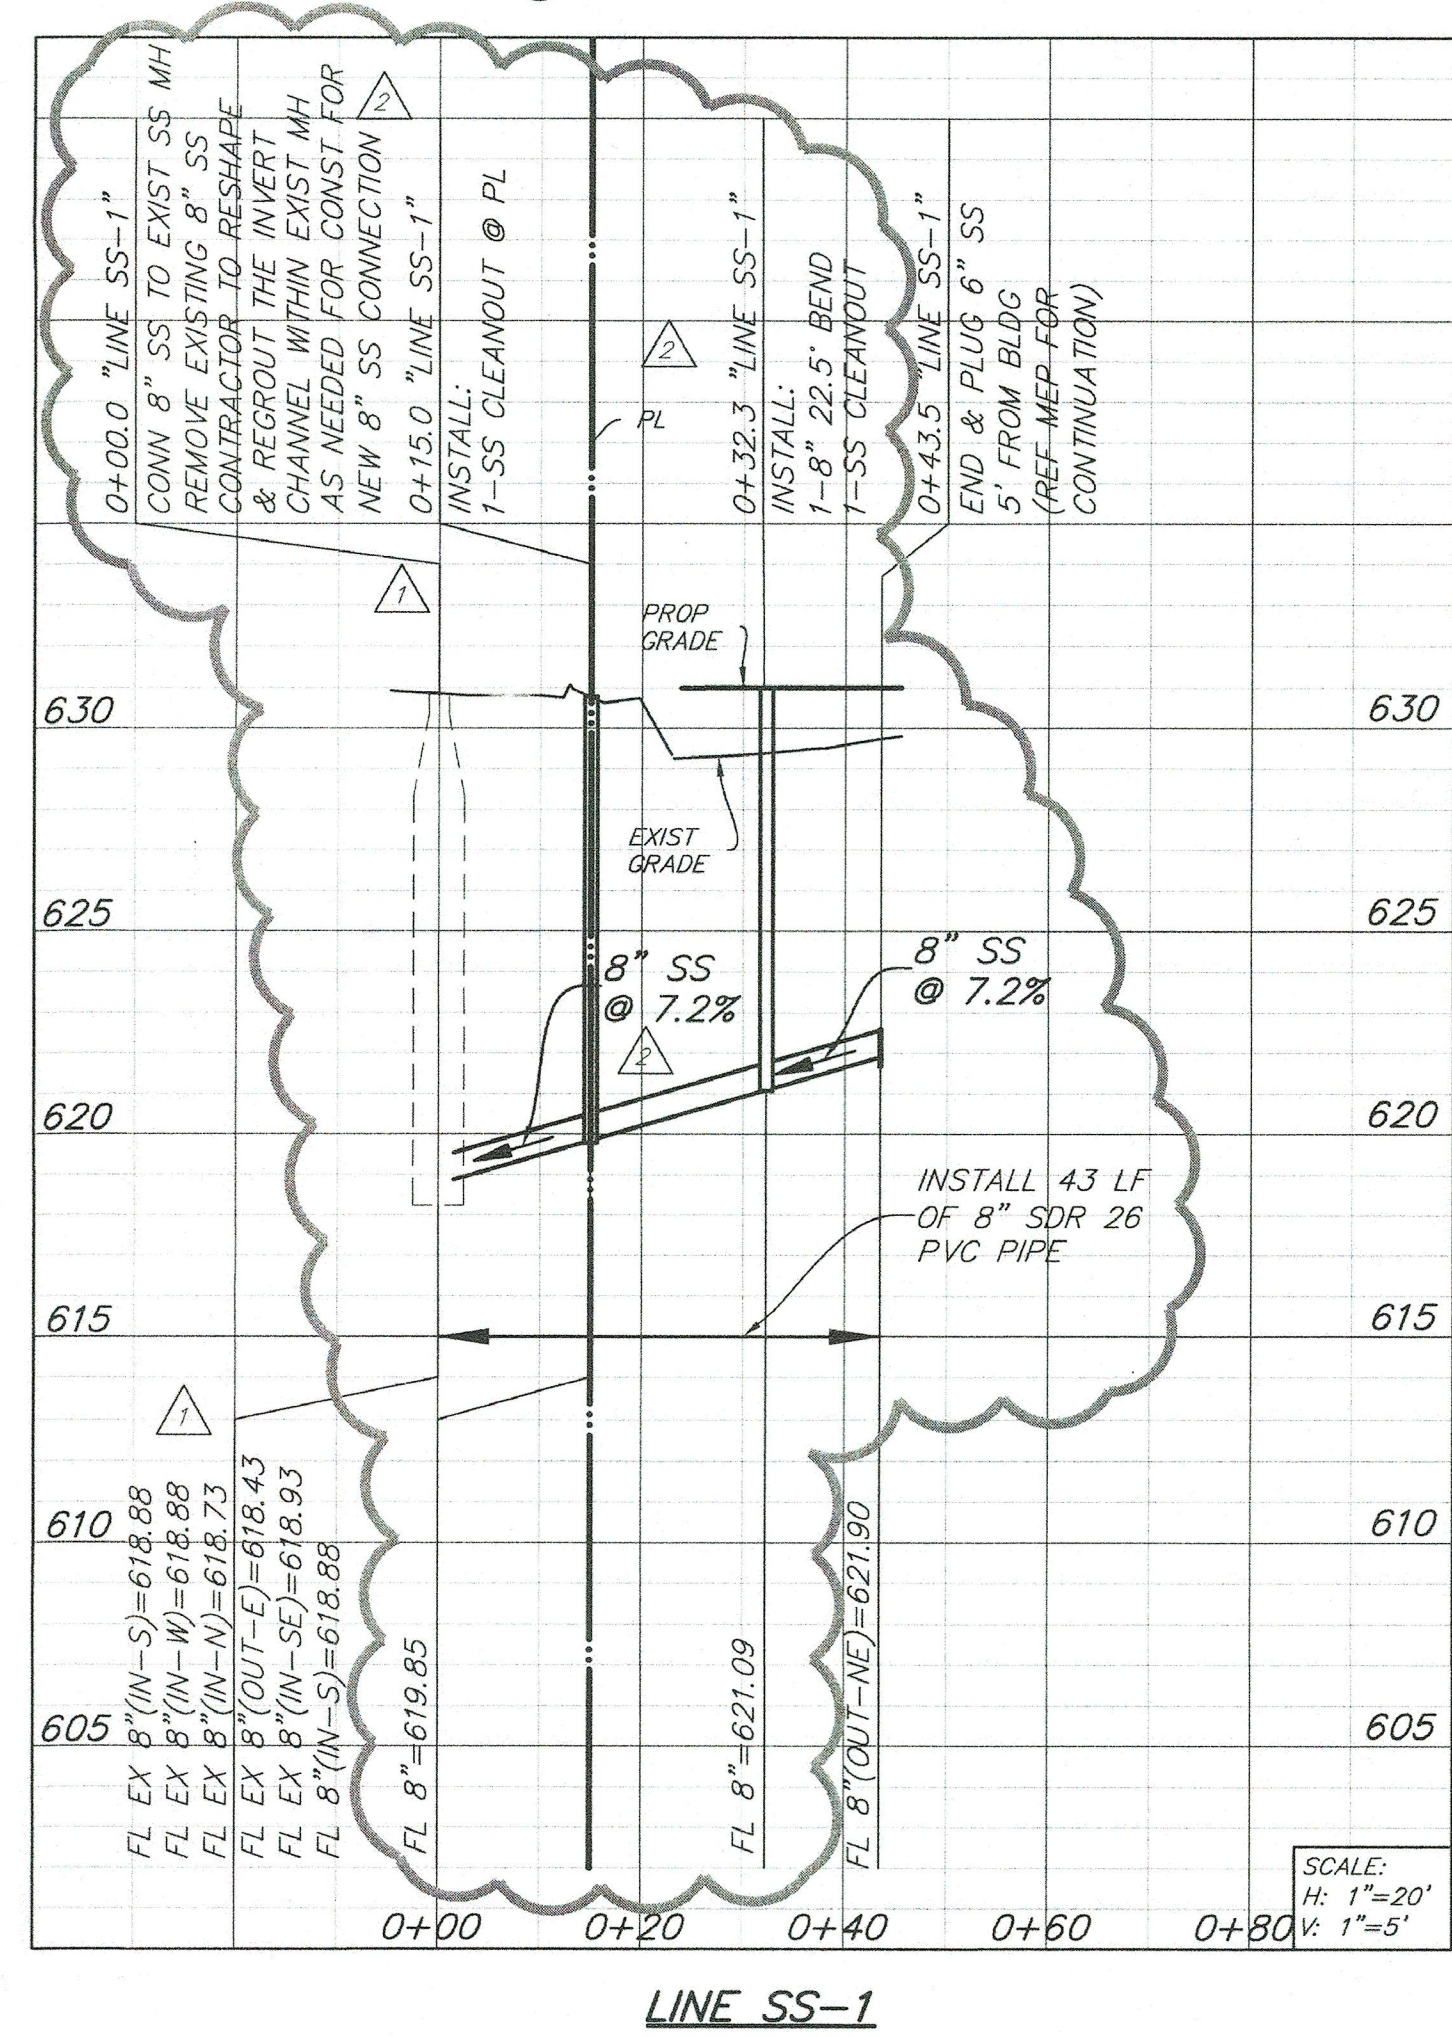

**BENCHMARKS:**  
BM#1  
BRASS DISC AT THE SOUTHWEST CORNER OF A 10' CURB INLET, ON THE WEST SIDE OF QUORUM DRIVE, 186 FEET ± SOUTH OF EDWIN LEWIS ROAD AS SHOWN.  
ELEVATION = 630.11

**RAYMOND L. GOODSON JR., INC.**  
CONSULTING ENGINEERS  
12001 N. CENTRAL EXPRESSWAY, SUITE 300  
DALLAS, TEXAS 75243 214/739-8100  
E-MAIL: rlg@rlg.com FIRM REG. 1-493

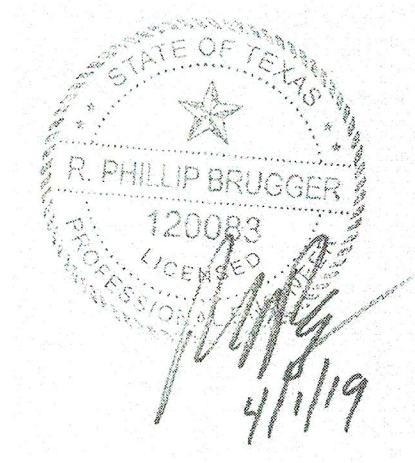

SHEET NO.  
**C6.00**

**ADDISON**

APPROVED FOR CONSTRUCTION  
INFRASTRUCTURE & DEVELOPMENT SERVICES

BY: *[Signature]*  
DATE: 4/1/19

IN APPROVING THESE PLANS, THE TOWN OF ADDISON ASSUMES NO RESPONSIBILITY FOR THEIR ADEQUACY, WHICH REMAINS WITH THE ENGINEER OF RECORD.

18801 WESTGROVE DRIVE, ADDISON, TX 75001 • (972) 450-2871

- △ 4/1/2019 REVISION
- △ 1/9/2019 RFI#29

UTILITY PLAN & PROFILES						
WESTERN INTERNATIONAL OFFICE BUILDING						
WESTERN INTERNATIONAL						
MAYSE & ASSOCIATES INC.						
TOWN OF ADDISON, TEXAS						
DESIGN	DRAWN	DATE	SCALE	XREF	FILE	NO.
RLG	RLG	10/16/18	1"=20'	1813.013	1813	013
JOB NO. 1813.013		SUBMITTAL:				