


CIVIL & LANDSCAPE PLANS FOR CONSTRUCTION OF
PAVING, STREETScape & UTILITY IMPROVEMENTS

ADDISON RESIDENTIAL ADDITION

SHEET NO.	INDEX OF DRAWINGS
C1	COVER SHEET
C2, C3	FINAL PLAT
C4	HORIZONTAL CONTROL PLAN
C4a	DEMOLITION PLAN
C5	PAVING TYPICAL SECTIONS
C6	RECOMMENDED UTILITY LOCATIONS
C7	SIGNAGE & STRIPING PLAN
C8-C12	PAVING PLANS & PROFILES
C13	ROUGH GRADING PLAN
C14	SLEEVING PLAN
C15	PAVING DETAILS
C16, C17	STREETSCAPE PLANS
C18, C19	STREETSCAPE, LIGHT & SUBDRAIN DETAILS
C20	DRAINAGE AREA MAP
C21-C25	STORM WATER PLANS
C26, C27	STORM WATER PROFILES
C28, C29	STORM WATER DETAILS
C30	WATER & WASTEWATER PLAN
C31, C32	WATER & WASTEWATER PROFILES
C33-C36	WATER & WASTEWATER DETAILS
C37	POLLUTION CONTROL PLAN
C38	POLLUTION CONTROL DETAILS
C39	ELECTRICAL PLAN
C40	ELECTRICAL SYMBOLS, NOTES & SCHEDULES
C41	PLANTING & FURNITURE PLAN
C42	PLANTING DETAILS
C43, C44	IRRIGATION PLANS
C45	TOWN OF ADDISON IRRIGATION SPECS.
C46	IRRIGATION DETAILS

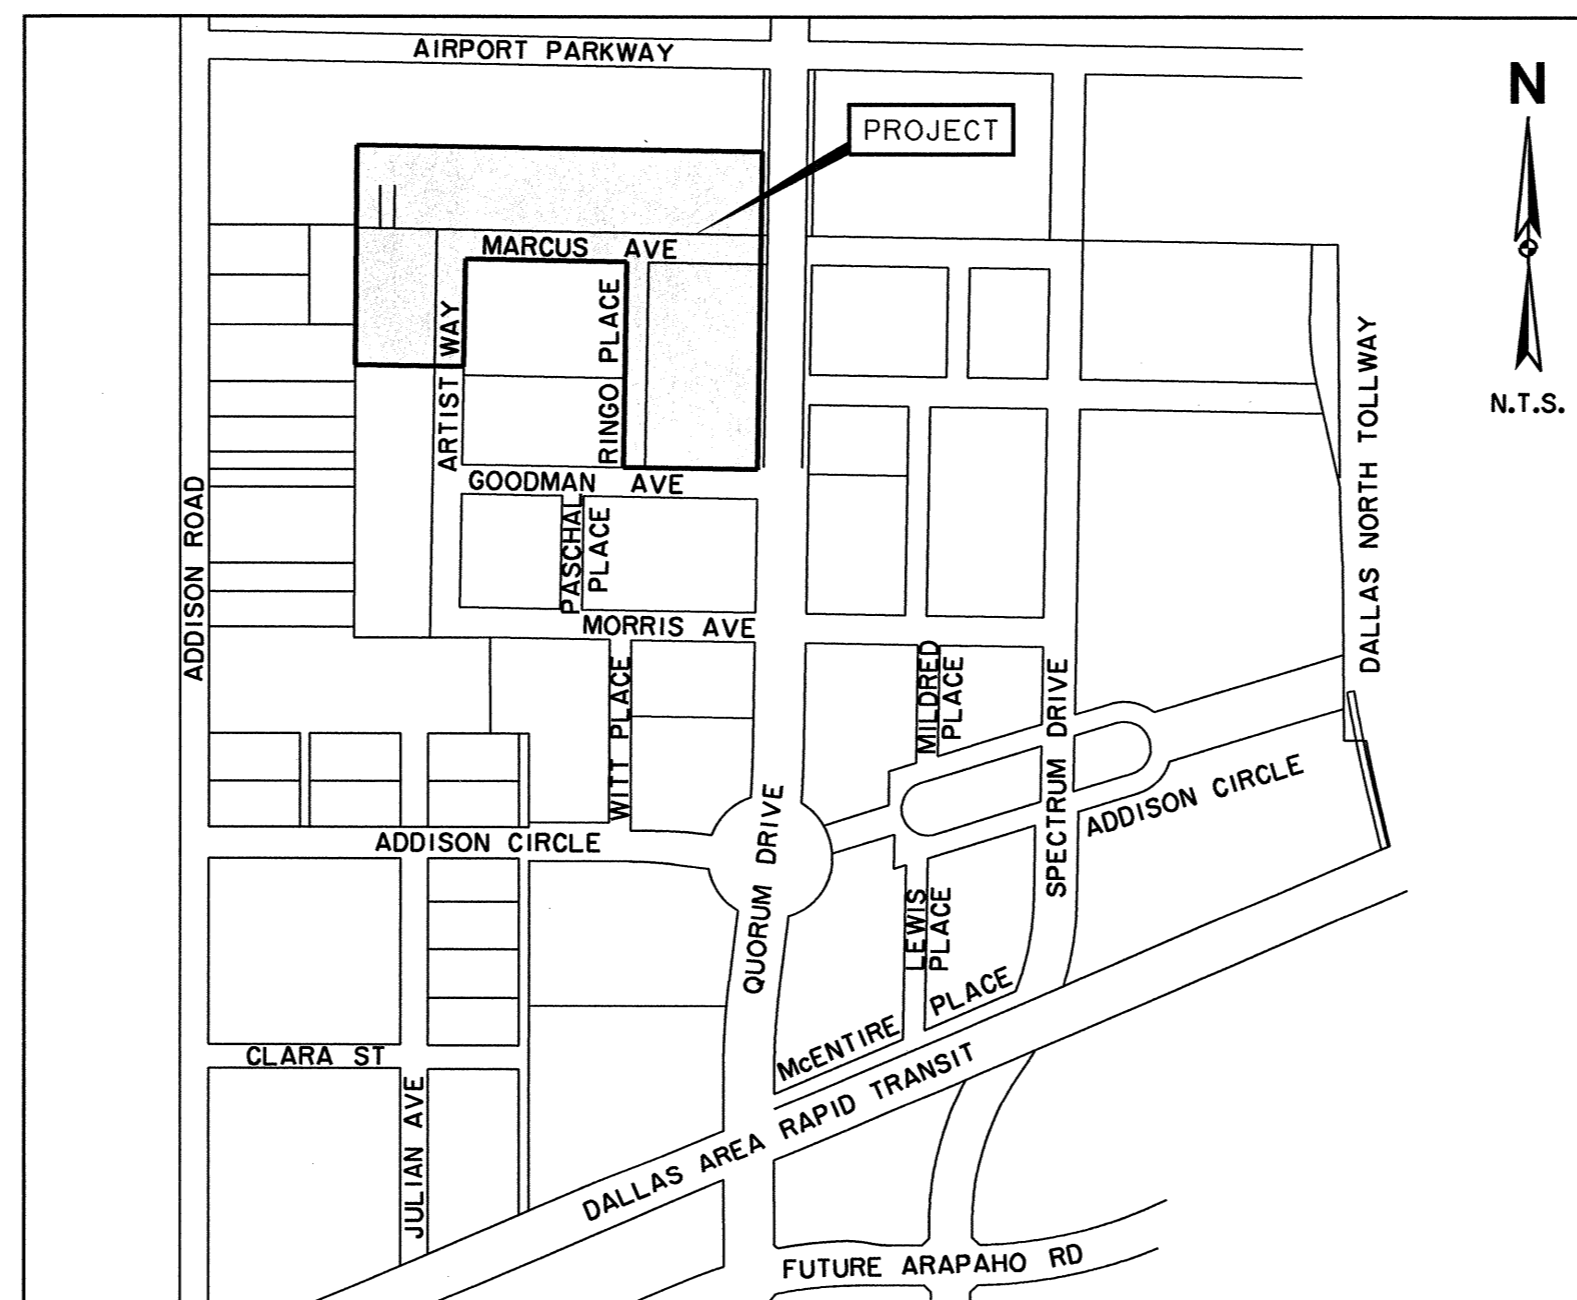

LOCATION MAP

OWNER:

FAIRFIELD RESIDENTIAL, LLC
2045 N. HIGHWAY 360, SUITE 250
GRAND PRAIRIE, TEXAS 75050
(817) 307-8060

ENGINEER:

HUITT-ZOLLARS, INC.
3131 MCKINNEY AVE., SUITE 600
DALLAS, TEXAS 75204
(214) 871-3311 FAX (214) 871-0757
KEVIN N. CARLSON, P.E.
email: kcarlson@huitt-zollars.com
TX. REG. NO. 89232

RECORD DRAWING

THIS DRAWING HAS BEEN MODIFIED FROM THE ORIGINAL TO SHOW ONLY THE FIELD CHANGES AND ADJUSTMENTS MADE DURING CONSTRUCTION BY THE CONTRACTOR WHICH WERE DOCUMENTED AND FURNISHED TO THE ENGINEER FOR THE PURPOSE OF PREPARING THESE RECORD DRAWINGS. FIELD INSPECTION OF CONSTRUCTION WAS PERFORMED BY OTHERS. TO THE BEST OF OUR KNOWLEDGE AND UNDERSTANDING THESE RECORD DRAWINGS REPRESENT THE "AS-BUILT" CONDITIONS.

