
N.T.S.

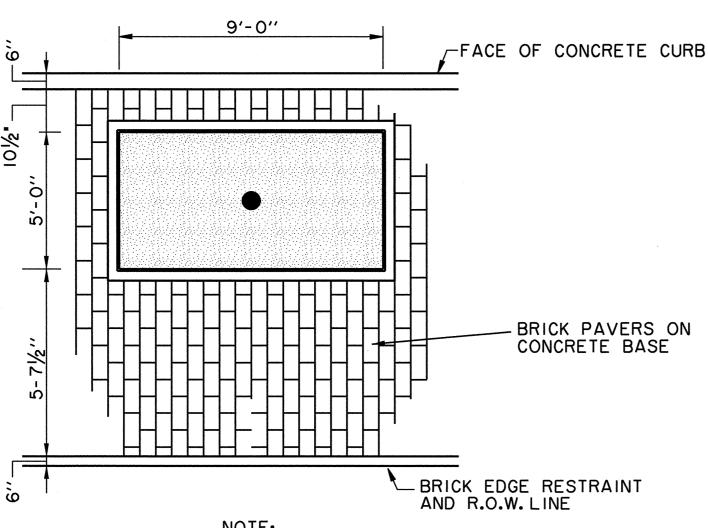

NOTE: PLANTING BED BEYOND R.O.W. IS UNDER SEPARATE CONTRACT.

TREE PIT PLAN (MARCUS AVENUE & ARTIST WAY) N.T.S.

of logical., and ref name., and ref levels.


It logical., and ref name., and ref levels.

ਵੁਵਾਵਾਵ 2 2 2 2 2

RFO, H. NPROJNOI340801NDGNNDETBD.DGN, I-61 on ref lagical. On ref name., on ref levels.


on ref lagical. On ref name., on ref levels.

on ref lagical. On ref name., on ref levels.

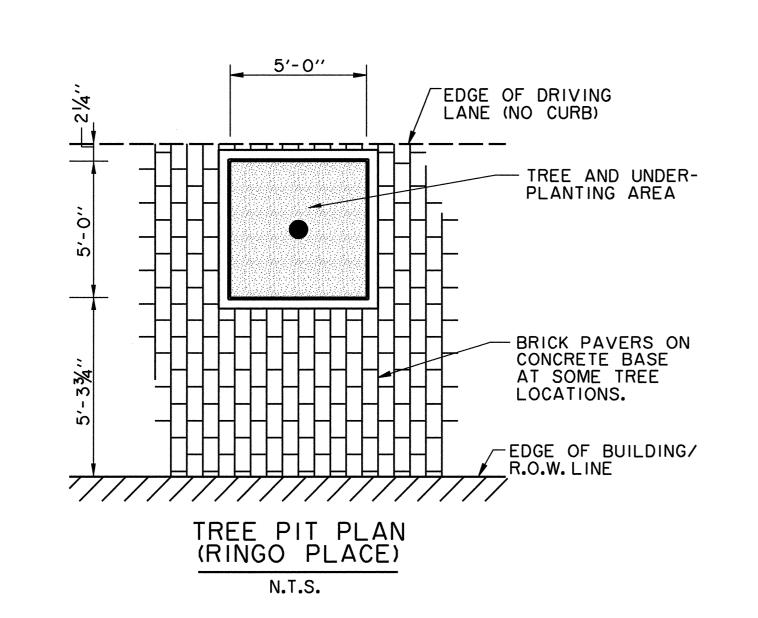


GENERAL NOTES CONCRETE SUBBASE FOR SIDEWALKS

- I. REINFORCED CONCRETE SIDEWALK SHALL BE A MINIMUM OF FOUR (4) INCHES THICK AND SHALL BE 3000 PSI AT 28 DAYS (5 SACK MIX) UNLESS NOTED OTHERWISE.
- 2. ALL BAR DIMENSIONS ARE GIVEN AS CENTER TO CENTER OF BARS AND ARE LOCATED AS SHOWN.
- 3. ALL REINFORCING STEEL SHALL BE NO. 3 ON 18" CENTERS LONGITUDINALLY, 18" CENTERS TRANSVERSELY AND SHALL CONFORM TO THE REQUIREMENTS OF ASTM A-615, GRADE 60.
- 4. I" THICK MIN. FINE WASHED SAND CUSHION SHALL BE FREE FROM ORGANIC MATERIALS OR CLAYS AND SHALL BE USED FOR GRADE ADJUSTMENT.
- 5. SUBGRADE SHALL BE COMPACTED TO A DENSITY NOT LESS THAN 95% OF STANDARD PROCTOR DENSITY AT 0 TO +3% OF OPTIMUM MOISTURE.
- 6. TOOLED JOINTS (CONTRACTION JOINTS) SHALL BE ON FIVE (5) FOOT CENTERS AND SHALL BE ROUND ONE-FOURTH (1/4) INCH RADIUS.

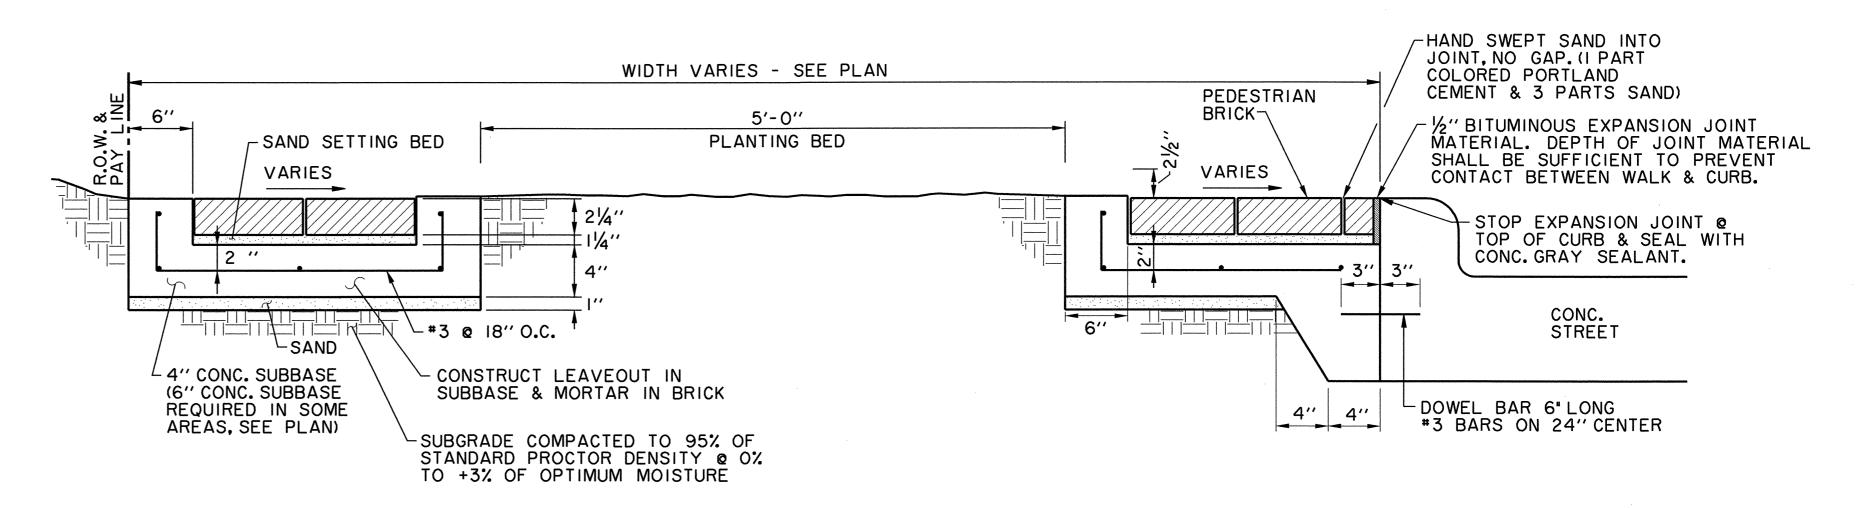


BRICK SIDEWALK INSTALLATION IN PEDESTRIAN AREA N.T.S.

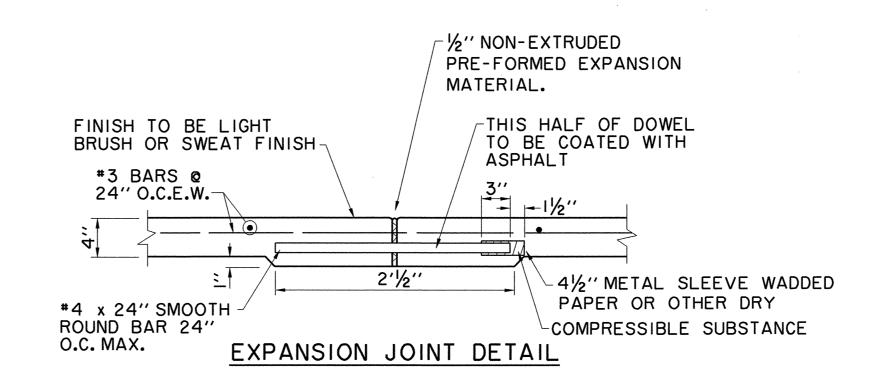

RECORD DRAWING

THIS DRAWING HAS BEEN MODIFIED FROM THE ORIGINAL TO SHOW ONLY THE FIELD CHANGES AND ADJUSTMENTS MADE DURING CONSTRUCTION BY THE CONTRACTOR WHICH WERE DOCUMENTED AND FURNISHED TO THE ENGINEER FOR THE PURPOSE OF PREPARING THESE RECORD DRAWINGS. FIELD INSPECTION OF CONSTRUCTION WAS PERFORMED BY OTHERS. TO THE BEST OF OUR KNOWLEDGE AND UNDERSTANDING THESE RECORD DRAWINGS REPRESENT THE "AS-BUILT" CONDITIONS.

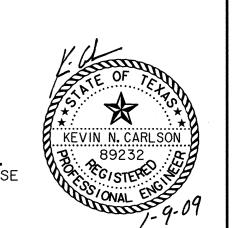

| | STREETSCAPE DETAILS | | | | | | | |
|--|---|-------|--------|----------|------------|----|-----|--|
| ADDISON RESIDENTIAL | | | | | | | | |
| | | | | | | | | |
| TOWN OF ADDISON, TEXAS | | | | | | | | |
| | Huitt - Zollars, Inc. 3131 Mckinney Ave., Suite 600, Dallas, TX 75204 Phone (214) 871-3311/Fax (214) 871-0757 | | | | | | | |
| DESIGN | CHECKED | APPR. | SCALE | DATE | PROJECT NO |). | NO. | |
| HZI | HZI | | N.T.S. | 11/20/08 | | | CI8 | |
| h. \ nea :\ 01340901\ dan\ 36305T50D D | | | | | | | | |