
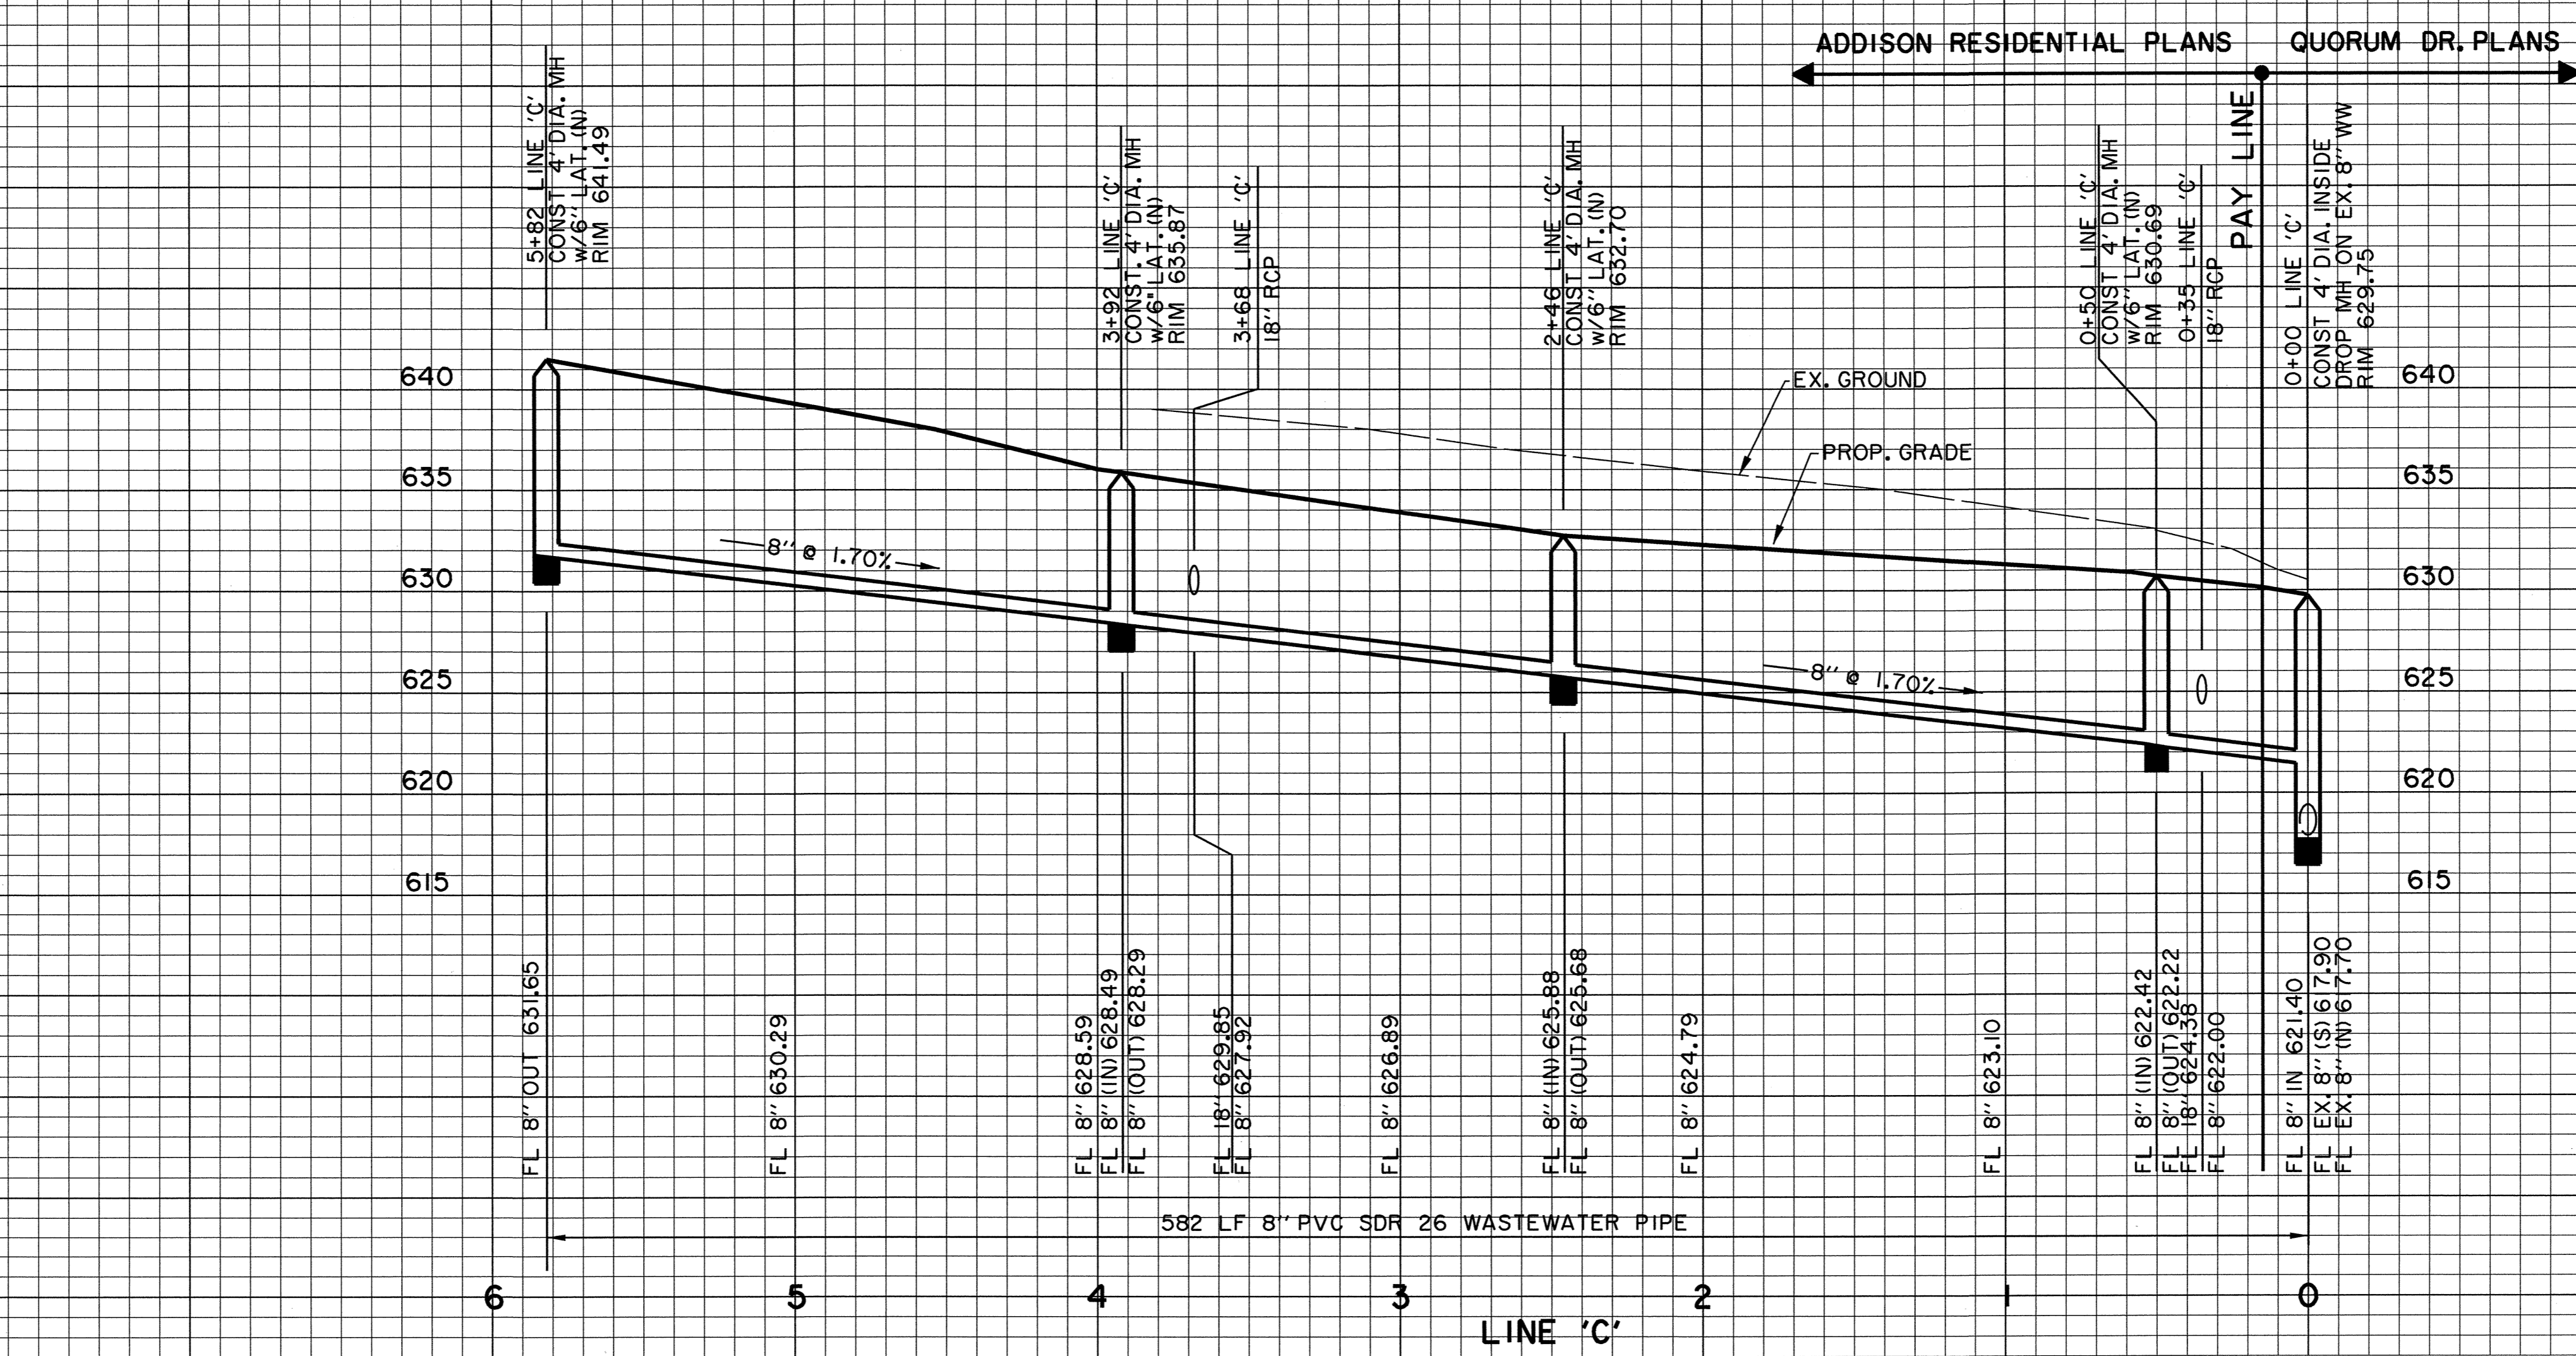


REF: 340880004-2-10-12-2023-B1
NO. OF LOGS: 1
NO. OF REVISIONS: 1
DATE: 11/20/08
PROJECT NO.: C31
NO. OF SHEETS: 1

REF: 11/10/08-60-00000
FILE: 11/10/08-60-00000
PROJECT: 11/10/08-60-00000

NO. OF LOGS: 1
NO. OF REVISIONS: 1
DATE: 11/20/08
PROJECT NO.: C31
NO. OF SHEETS: 1

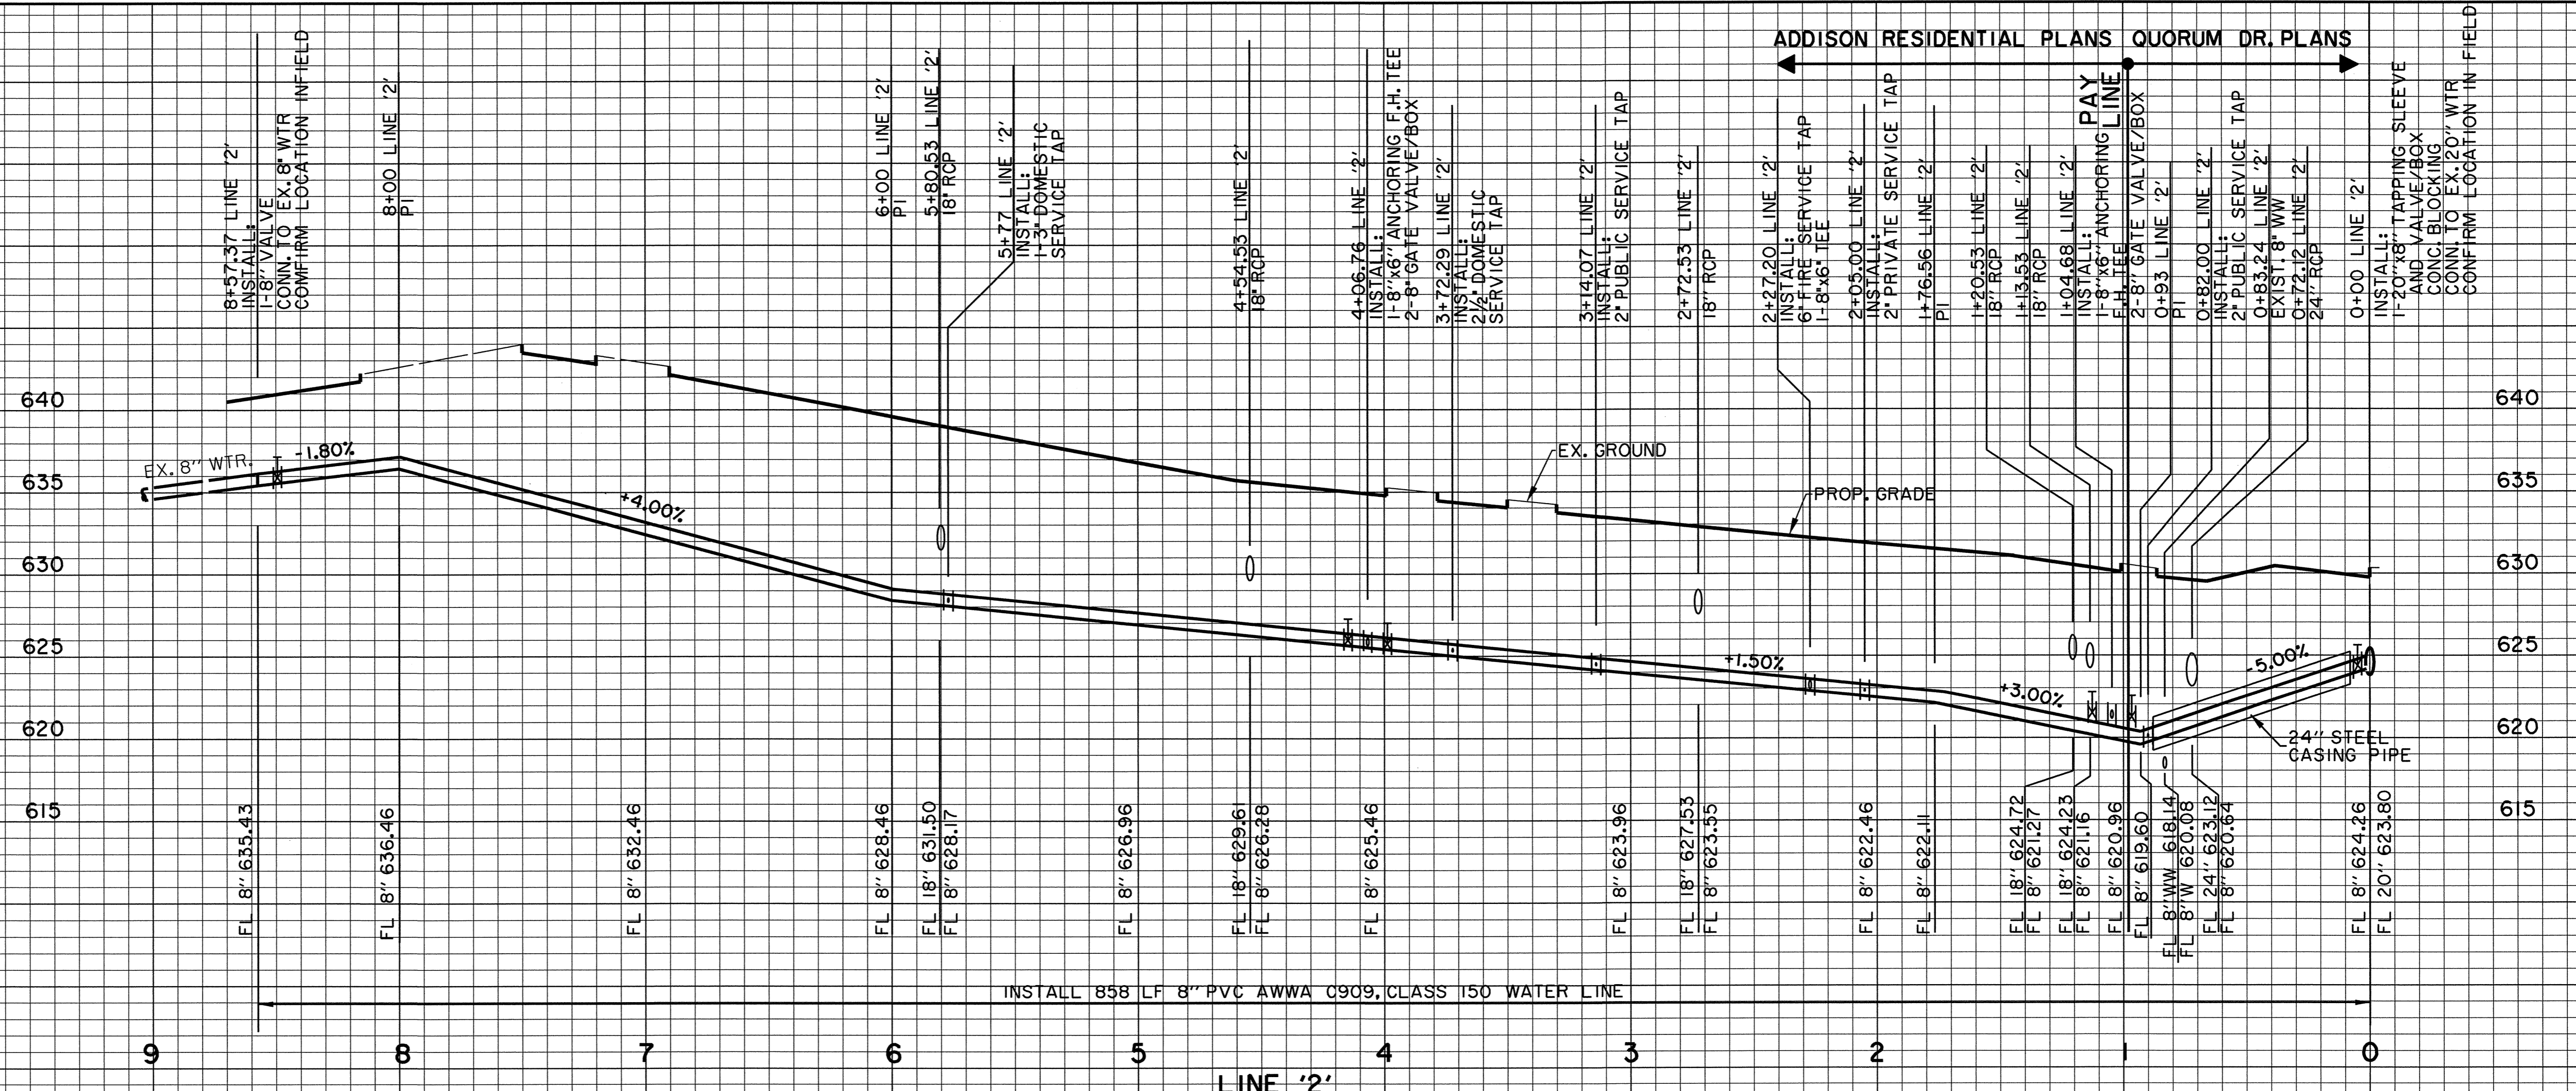

- BENCHMARKS:**
- BM#5**
1" CUT ON 8" INLET ON NORTH CURB LINE OF GOODMAN AVE. +75' EAST OF PASCHAL PLACE. ELEV. 629.98
 - BM#6**
1" CUT AT 6' OF 8" INLET AT THE SOUTHWEST CORNER OF MORRIS AVE. AND WITT PLACE. ELEV. 627.29
 - BM#7**
1" CUT AT WEST CORNER OF ADDISON THEATRE CENTRE PARKING LOT, SECOND ENTRANCE NORTH OF ADDISON RD. ELEV. 637.66



RECORD DRAWING
THIS DRAWING HAS BEEN MODIFIED FROM THE ORIGINAL TO SHOW ONLY THE FIELD CHANGES AND ADJUSTMENTS MADE DURING CONSTRUCTION BY THE CONTRACTOR WHICH WERE DOCUMENTED AND FURNISHED TO THE ENGINEER FOR THE PURPOSE OF PREPARING THESE RECORD DRAWINGS. FIELD INSPECTION OF CONSTRUCTION WAS PERFORMED BY OTHERS TO THE BEST OF OUR KNOWLEDGE AND UNDERSTANDING THESE RECORD DRAWINGS REPRESENT THE 'AS-BUILT' CONDITIONS.

WATER & WASTEWATER PROFILES						
ADDISON RESIDENTIAL						
TOWN OF ADDISON, TEXAS						
DESIGN	CHECKED	APPR.	SCALE	DATE	PROJECT NO.	NO.
HZI	HZI	DEM	H ₁ 1"=40' V ₁ 1"=6'	11/20/08		C31