



HOPE INVESTMENTS, LTD. VOL. 96022, PG. 60
 UNITED STATES POSTAL SERVICE ADDISON ADDITION VOL. 88078, PG. 357
 SOUTH & WESTERN ADDITION VOL. 96140, PG. 3247
 LOT 1, BLOCK A SHEPHERD ADDITION VOL. 97214 PG. 04261
 TRACT 11 ROSSROADS AVIATION, INC. VOL. 67044 PG. 0213
 TRACT 21
 TRACT 11 S.A. COOY HIS HEIRS & ASSIGNS VOL. 71165 PG. 2799
 TRACT 21
 100 MIRROR & GLASS, INC. VOL. 79020 PG. 0875
 TRACT 21 RENT A CAR SYSTEM, INC. VOL. 99089 PG. 03138
 AYES PROPERTIES ADDITION VOL. 85083 PG. 1059
 TRACT 11 RENT A CAR SYSTEM, INC. VOL. 99089 PG. 03138
 HOPE INVESTMENTS, LTD. VOL. 96022, PG. 60
 UNITED STATES POSTAL SERVICE ADDISON ADDITION VOL. 88078, PG. 357
 SOUTH & WESTERN ADDITION VOL. 96140, PG. 3247
 LOT 1, BLOCK A SHEPHERD ADDITION VOL. 97214 PG. 04261
 TRACT 11 ROSSROADS AVIATION, INC. VOL. 67044 PG. 0213
 TRACT 21
 TRACT 11 S.A. COOY HIS HEIRS & ASSIGNS VOL. 71165 PG. 2799
 TRACT 21
 100 MIRROR & GLASS, INC. VOL. 79020 PG. 0875
 TRACT 21 RENT A CAR SYSTEM, INC. VOL. 99089 PG. 03138
 AYES PROPERTIES ADDITION VOL. 85083 PG. 1059
 TRACT 11 RENT A CAR SYSTEM, INC. VOL. 99089 PG. 03138

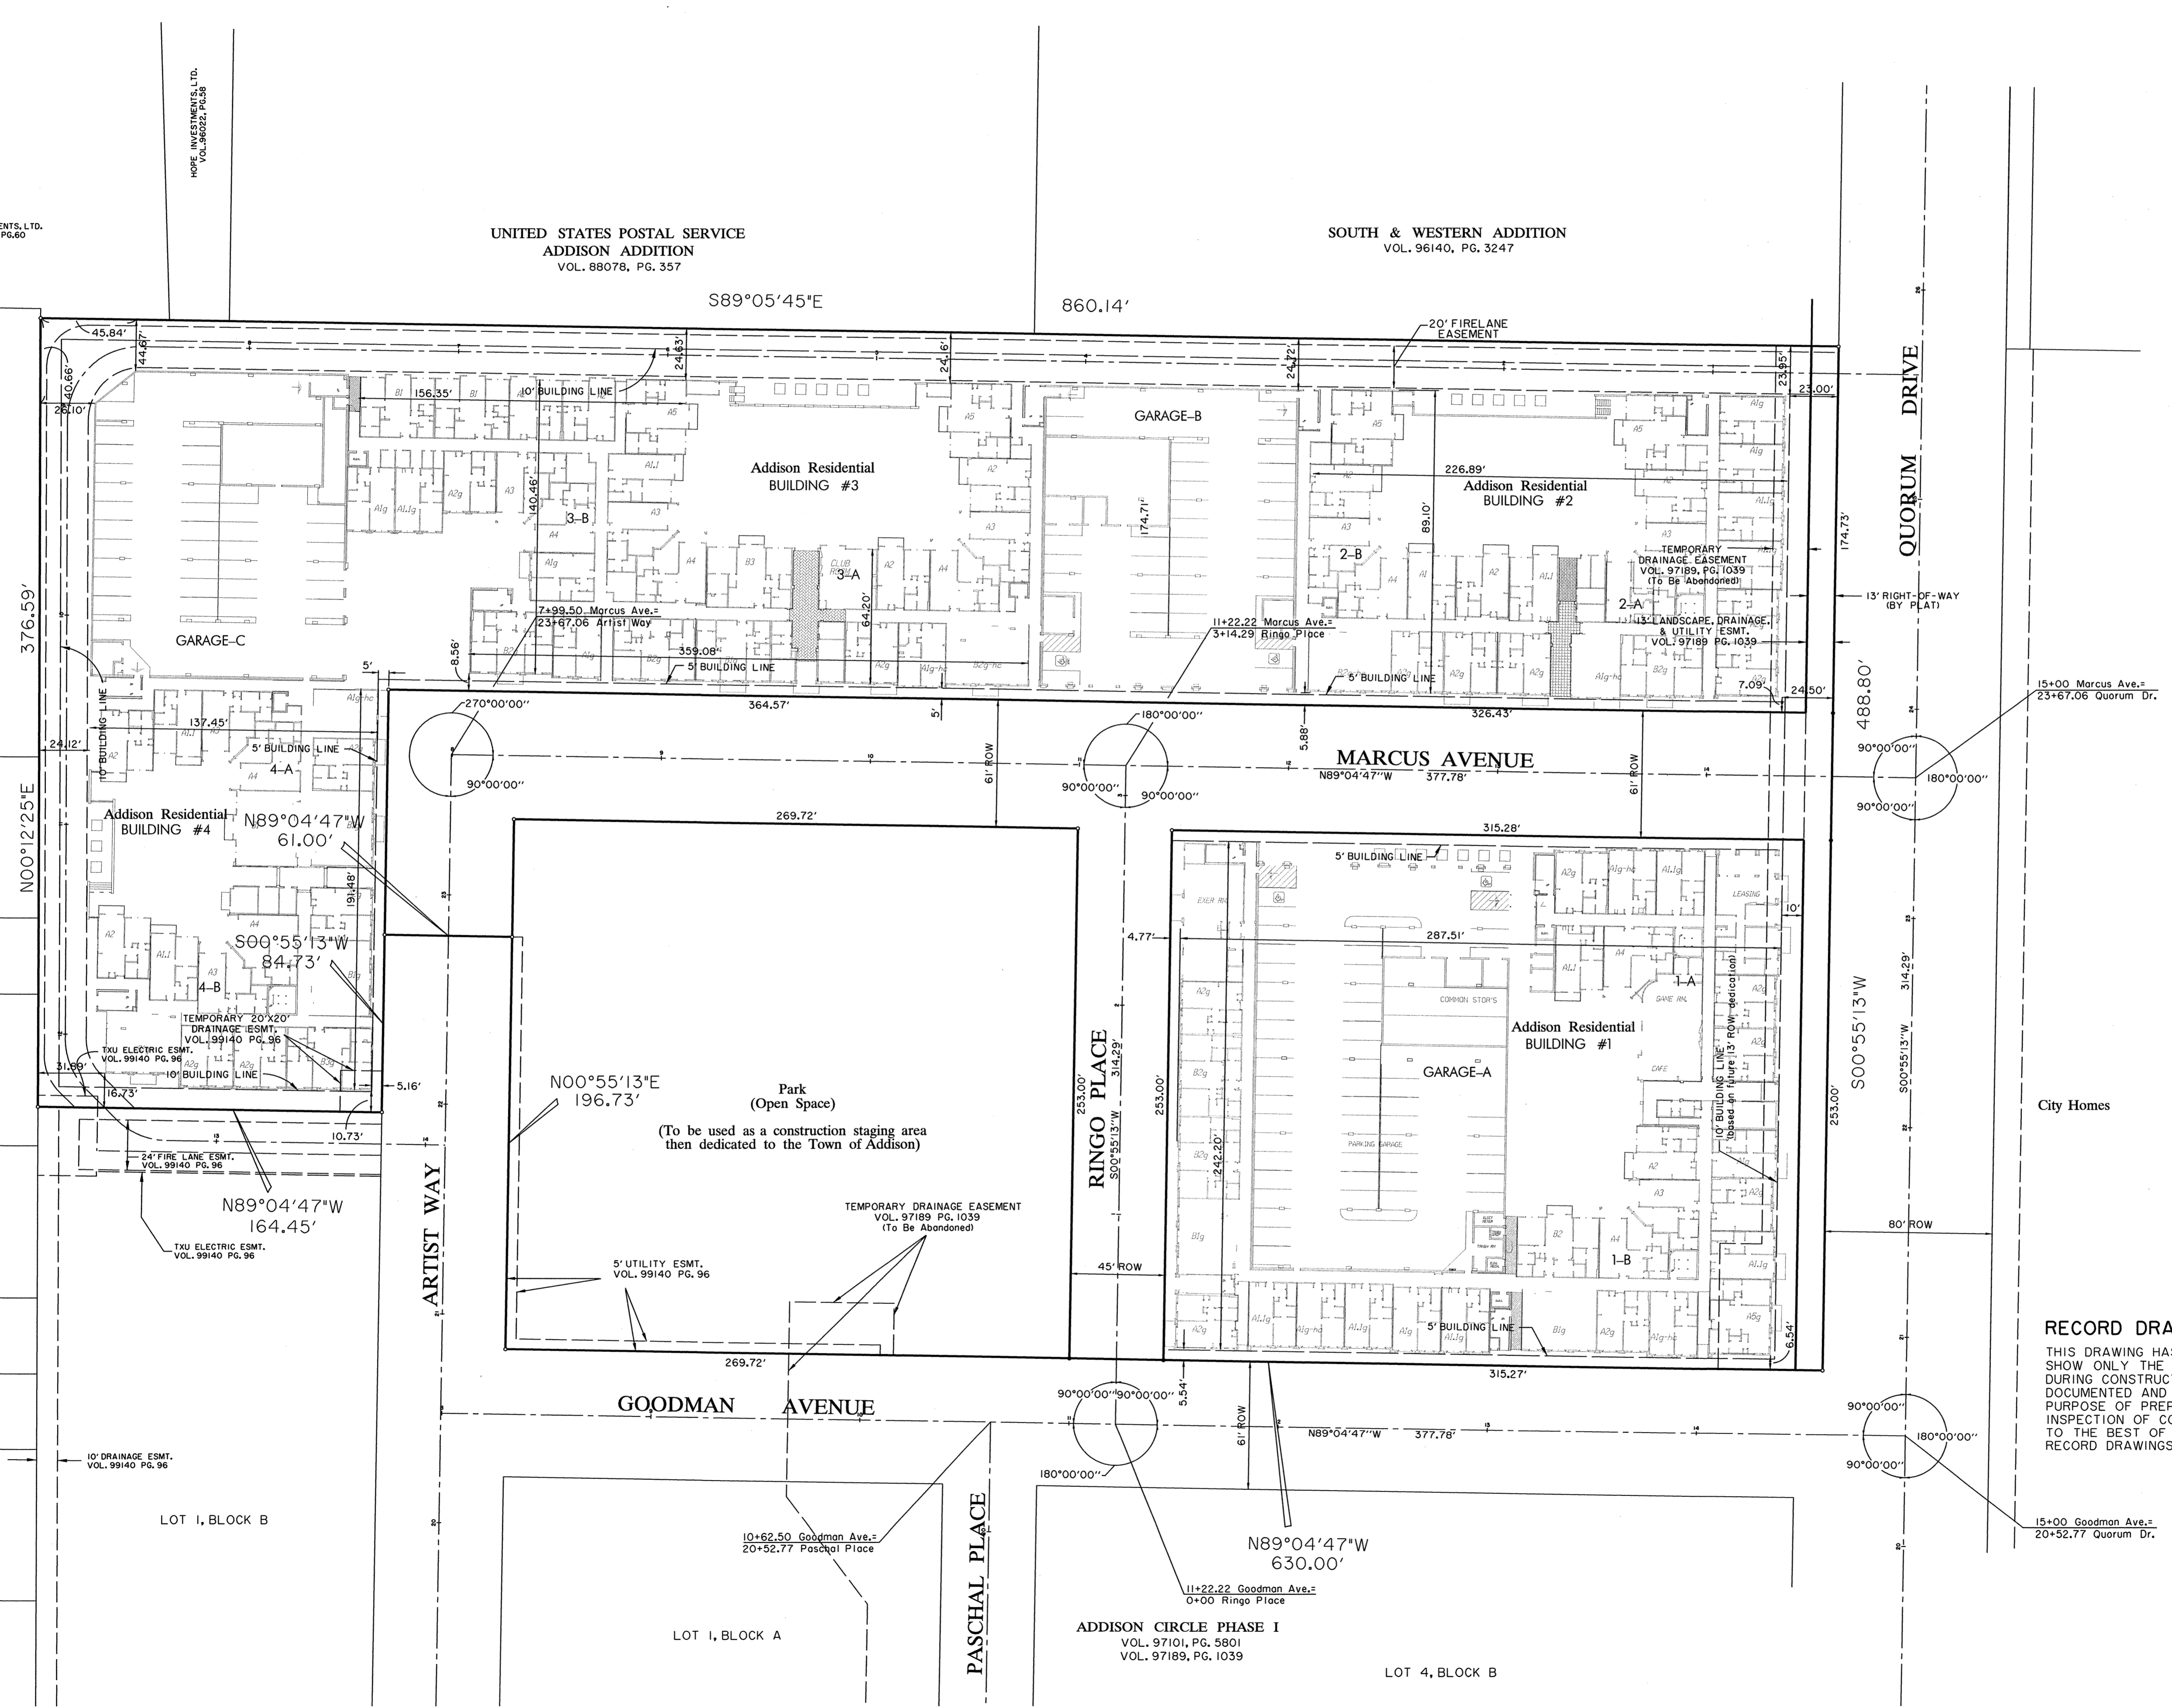

RECORD DRAWING
 THIS DRAWING HAS BEEN MODIFIED FROM THE ORIGINAL TO SHOW ONLY THE FIELD CHANGES AND ADJUSTMENTS MADE DURING CONSTRUCTION BY THE CONTRACTOR WHICH WERE DOCUMENTED AND FURNISHED TO THE ENGINEER FOR THE PURPOSE OF PREPARING THESE RECORD DRAWINGS. FIELD INSPECTION OF CONSTRUCTION WAS PERFORMED BY OTHERS. TO THE BEST OF OUR KNOWLEDGE AND UNDERSTANDING THESE RECORD DRAWINGS REPRESENT THE "AS-BUILT" CONDITIONS.

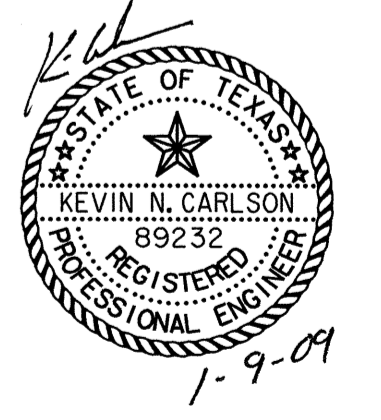

HORIZONTAL CONTROL PLAN						
ADDISON RESIDENTIAL						
TOWN OF ADDISON, TEXAS						
HUNT - ZOLLERS, INC. 3131 McKinney Ave., Suite 600, Dallas, TX 75204 Phone (214) 871-3311 / Fax (214) 871-0757						
DESIGN	CHECKED	APPR.	SCALE	DATE	PROJECT NO.	NO.
HZI	HZI	DEM	1"=40'	11/20/08		C4