


no ref logical•, •no ref name•, •no ref levels•
no ref logical•, •no ref name•, •no ref levels•
8 8 8 8 8


RFO, Ht. NPROJNO1340801NDGNNDETBD.DGN, 1-61 on ref lagicals, ono ref names, ono ref levelse ono ref lagicals, ono ref names, ono ref levelse ono ref lagicals, ono ref names, ono ref levelse ono ref lagicals, ono ref names, ono ref levelse

24 DWF. YAUPON HOLLY 24 JOHN FANICK PERENNIAL PHLOX 12" O.C. 12" O.C. I , HIGHRISE LIVE OAK

> 5'X9' TREE WELL PLANTING SCALE: 1/4"=1'-0"

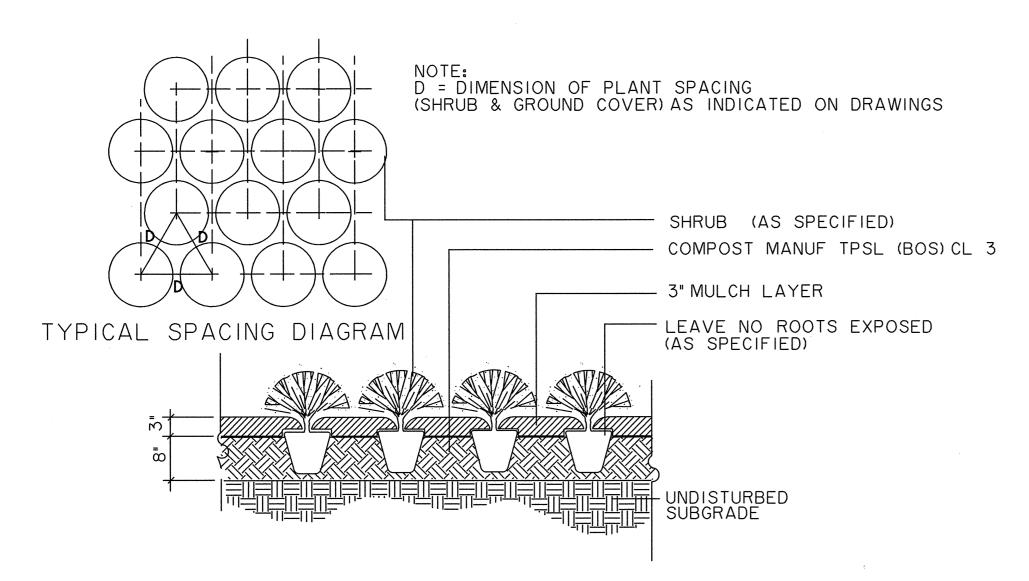

SHRUB PLANTING DETAIL N.T.S.

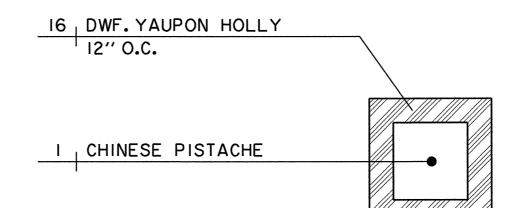


5'X5' TREE WELL PLANTING SCALE: 4"=1'-0" PLANTING NOTES:

- I. SOIL IN THE TREE WELL PLANTERS SHALL BE PREPARED USEING THE EarthKind LANDSCAPE MANAGEMENT PROGRAM. THIS SHALL INCLUDE TILLING THREE INCHES OF EXPANDED SHALE TO A DEPTH OF 6 INCHES, THEN ADDITIONALLY TILLING 3 INCHES OF WELL-COMPOSITED ORGANIC MATTER ON TOP OF THAT. AFTER PLANTING, APPLY A 3 INCH LAYER OF SHREDDED HARDWOOD MULCH. SUBMIT SAMPLES OF ALL SOIL AMENDMENT MATERIALS, INCLUDING MULCH TO THE TOWN FOR APPROVAL PRIOR TO BEGINNING WORK.
- 2. ALL TREE PIT BACKFILL AND TREE WELL PLANTER TOP SOIL SHALL BE CLEAN, NATIVE BLACK CLAY SOIL FREE OF ROCK I INCH OR LARGER. BACKFILL/TOPSOIL SHALL BE APPROVED BY THE TOWN. THE CONTRACTOR SHALL PROVIDE THE SOURCE OF THE SOIL TO THE OWNER FOR REVIEW AND APPROVAL.

RECORD DRAWING

THIS DRAWING HAS BEEN MODIFIED FROM THE ORIGINAL TO SHOW ONLY THE FIELD CHANGES AND ADJUSTMENTS MADE DURING CONSTRUCTION BY THE CONTRACTOR WHICH WERE DOCUMENTED AND FURNISHED TO THE ENGINEER FOR THE PURPOSE OF PREPARING THESE RECORD DRAWINGS. FIELD INSPECTION OF CONSTRUCTION WAS PERFORMED BY OTHERS. TO THE BEST OF OUR KNOWLEDGE AND UNDERSTANDING THESE RECORD DRAWINGS REPRESENT THE "AS-BUILT" CONDITIONS.

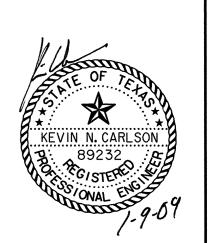

| PLANTING DETAILS | | |
|------------------|-------|-------------|
| ADI | DISON | RESIDENTIAL |
| | | |

TOWN OF ADDISON, TEXAS

Huitt - Zollars, Inc. 3131 Mckinney Ave., Suite 600, Dallas, TX 75204 Phone (214) 871-3311/Fax (214) 871-0757 SCALE DATE PROJECT NO. DESIGN CHECKED APPR.

HZI N.T.S. 11/20/08

h:\proj\01340801\dgn\3629PLANTDET1.DGN

NOTE: SEE SHEET C19 FOR SUBSURFACE DRAIN SYSTEM DETAIL