

MARCUS AVENUE

SEE QUORUM DRIVE IRRIGATION PLANS

SEE SHEET C51 FOR CONTINUATION OF WATER DISTRIBUTION ZONE 5



SCALE IN FEET
SCALE: 1" = 20'

Park (Open Space)

SEE 5'x5' TREE PIT IRRIGATION DIAGRAM (THIS SHEET) TYP.

RINGO PLACE

Addison Residential

BUILDING #1

City Homes


QUORUM DRIVE

CONC. PVMT.

CONC. PVMT.

CONC. PVMT.

NOTE:
ALL IRRIGATION LINES SHALL BE LOCATED IN SLEEVES OR PLANTERS OR PLANTERS ARE DIAGRAMMATIC AND DO NOT REPRESENT THE ABSOLUTE LOCATIONS.

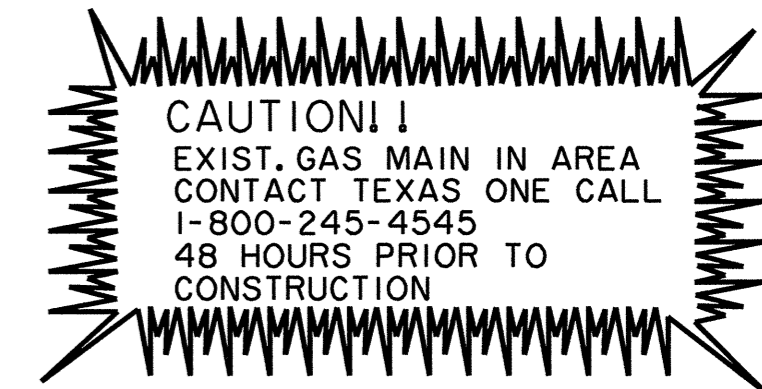

PHONE SERVICE TO CONTROLLER WILL BE FROM EXISTING SERVICE ON QUORUM DRIVE. CONTACT TOBY PARKER WITH SBC 972-234-7037

NOTE:
ALL IRRIGATION LINES SHALL BE LOCATED IN SLEEVES OR PLANTERS IRRIGATION LINES NOT SHOWN IN SLEEVES OR PLANTERS ARE DIAGRAMMATIC AND DO NOT REPRESENT THE ABSOLUTE LOCATIONS.

NOTE:
See Landscaping Plans For Landscaping Along Fire Lane Alley.

BENCHMARKS:

BM#5
"C" CUT ON 8" INLET ON NORTH CURB LINE OF GOODMAN AVE. +75' EAST OF PASCHAL PLACE. ELEV. 629.98

BM#6
"C" CUT AT C OF 8" INLET AT THE SOUTHWEST CORNER OF MORRIS AVE. AND WITT PLACE. ELEV. 627.29

BM#7
"C" CUT AT WEST CORNER OF ADDISON THEATRE CENTRE PARKING LOT, SECOND ENTRANCE NORTH OF ADDISON RD. ELEV. 637.66

RECORD DRAWING

THIS DRAWING HAS BEEN MODIFIED FROM THE ORIGINAL TO SHOW ONLY THE FIELD CHANGES AND ADJUSTMENTS MADE DURING CONSTRUCTION BY THE CONTRACTOR WHICH WERE DOCUMENTED AND FURNISHED TO THE ENGINEER FOR THE PURPOSE OF PREPARING THESE RECORD DRAWINGS. FIELD INSPECTION OF CONSTRUCTION WAS PERFORMED BY OTHERS. TO THE BEST OF OUR KNOWLEDGE AND UNDERSTANDING THESE RECORD DRAWINGS REPRESENT THE "AS-BUILT" CONDITIONS.




IRRIGATION PLAN
ADDISON RESIDENTIAL

TOWN OF ADDISON, TEXAS


Hull - Zellers, Inc.
3131 McKinney Ave., Suite 600, Dallas, TX 75204
Phone (214) 871-3311/Fax (214) 871-0757

DESIGN	CHECKED	APPR.	SCALE	DATE	PROJECT NO.	NO.
HZI	HZI	DEM	1"=20'	11/20/08		C44

SPRINKLER: H:\proj\01340801\dgn\3629LRR01B.DGN, 2-24-08, 5:00 PM, H:\proj\01340801\dgn\3629LRR01B.DGN, 11/20/08, 11:17:19 AM
SHEET: 44 OF 44
SHEET TITLE: IRRIGATION PLAN
SHEET NO.: 44
PROJECT: ADDISON RESIDENTIAL
DATE: 11/20/08
DRAWN BY: HZI
CHECKED BY: HZI
APPROVED BY: DEM
SCALE: 1"=20'
DATE: 11/20/08
PROJECT NO.:
NO.: C44

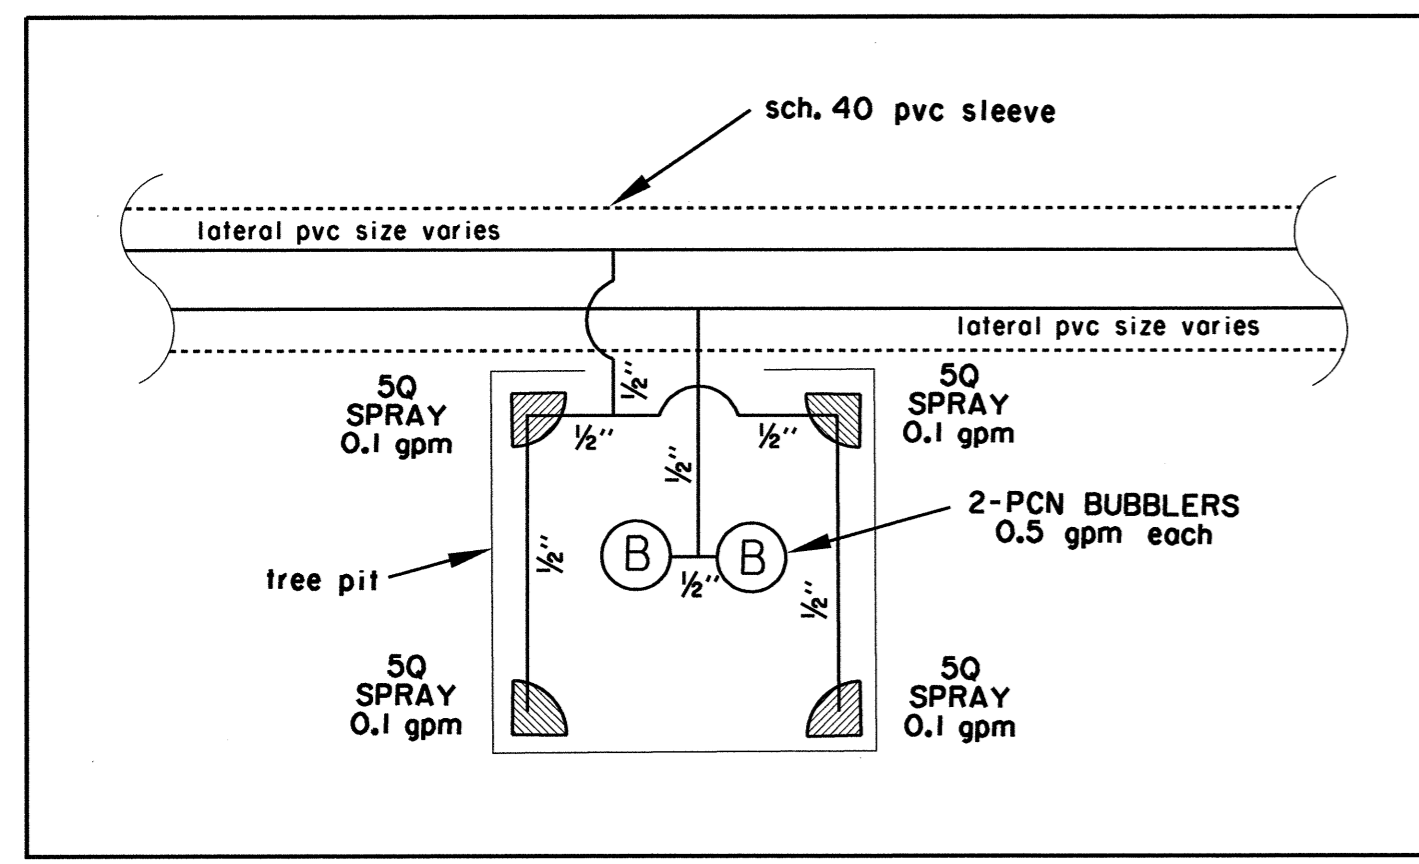

5'x5' TREE PIT DIAGRAM
nts

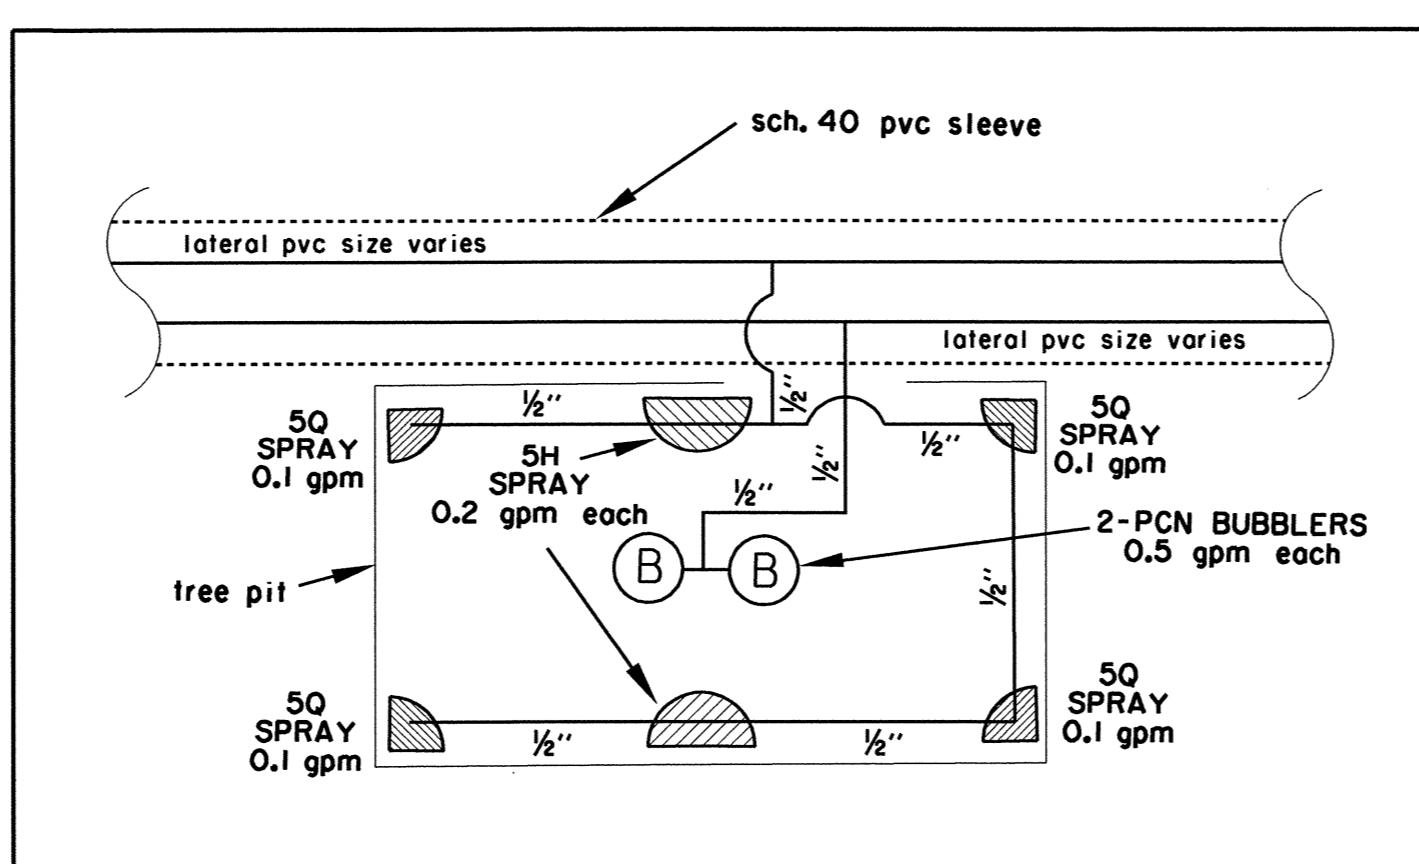

5'x9' TREE PIT DIAGRAM
nts

CONC. PVMT.

CONC. PVMT.

GOODMAN AVENUE

EXER. RM.

A2g

B2g

B2g

B1g

A2g

A1.1g

A1g-hc

A1.1g

A1g

A1.1g

A1g

A1.1g

B1g

A2g

A1g-hc

A5g

A2g

B2g

B2g

B1g

A2g

A1.1g

A1g-hc

A1.1g

A1g

A1.1g

A1g

A1.1g

B1g

A2g

A1g-hc

A2g

A1g-hc

A1.1g

A1.1

A4

GAME RM.

A1.1

A4

CAFE

A2g

A2g

A2

A1g

A3

A2g

B2

A4

1-B

A1.1g

A2g

A1g-hc

A2g

A1g-hc

COMMON STOR'S

GARAGE-A

PARKING GARAGE

ELECT. METER

TRASH RM.

ELECT. METER

LEASING

GAME RM.

CAFE

A2

A1.1g

A5g

A1.1g

A1g-hc

A1.1g

A1g-hc

A1.1g

A1g-hc

A1.1g

A1g-hc