

CONSTRUCTION PLANS FOR

MILDRED STREET IMPROVEMENTS


As Built

- MAYOR:**
D. LYNN SPRULL
- COUNCIL MEMBERS:**
JOHN BRANCH
MARY DOLAN
JIM DUFFY
DAVID GRANOFF
RILEY REINKER
- CITY MANAGER:**
RON WHITEHEAD
- DIRECTOR OF STREETS:**
ROBIN JONES
- DIRECTOR OF UTILITIES:**
DON PREECE
- DIRECTOR OF PARKS:**
SLADE STRICKLAND

INDEX TO DRAWINGS

Sheet No.	Description
	COVER SHEET
M1	PAVING, STA. 0+00 TO STA. 5+00
M2	PAVING, STA. 5+00 TO STA. 8+50
M3	PAVING, STA. 8+50 TO STA. 11+45
M4	STANDARD DETAILS-PAVING
M5	STANDARD DETAILS-PAVING
M6	STANDARD DETAILS-PAVING
M7	STANDARD DETAILS-PAVING
M8	DRAINAGE AREA MAP
M9	DRAINAGE, STA. 0+00 TO STA. 5+00
M10	DRAINAGE, STA. 5+00 TO STA. 8+50
M11	DRAINAGE, STA. 8+50 TO STA. 11+45
M12	STANDARD DETAILS, DRAINAGE
S1	SANITARY SEWER LOCATION MAP
S2	SANITARY SEWER PLAN
S3	SANITARY SEWER - MILDRED STREET
S4	SANITARY SEWER - MILDRED STREET
S5	SANITARY SEWER - PROFILES
S6	SANITARY SEWER - JULIAN TO QUORUM
S7	SANITARY SEWER - QUORUM TO DALLAS NORTH TOLLWAY
S8	STANDARD DETAILS, SANITARY SEWER
S9	STANDARD DETAILS, SANITARY SEWER
S10	STANDARD DETAILS, SANITARY SEWER

APPROVED BY: _____ DATE: _____
D. LYNN SPRULL, MAYOR

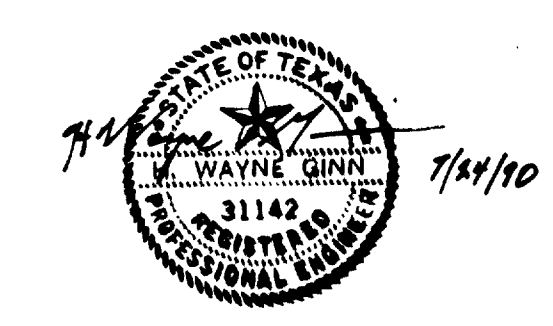

GINN, INC.
Consulting Engineers Dallas, Texas
JUNE, 1990