


REVISIONS AUG. 1988  
 Compiled from aerial photographs taken February 25, 1986 with the Wild RC-8 camera. Horizontal and vertical control was extended from existing U.S. Coast and Geodetic Survey monuments. Further densification was performed by Aero-Triangulation using the Wild BC-1 Avioyt.



Grid lines and values shown are based on the Texas State Coordinate System, North Central Zone.

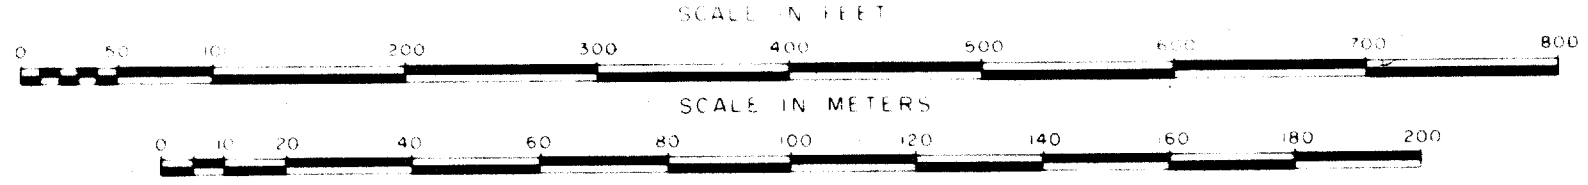

TOWN OF ADDISON  
 DALLAS COUNTY, TEXAS  
**MILDRED STREET IMPROVEMENTS**  
*As Built*  
**DRAINAGE AREA MAP**  
 GINN, INC.  
 Consulting Engineers Dallas, Texas

Designed - TEC	Drawn - TEC	Date - June, 1990	Job No. - 90439
Approved - HWG	Checked - GF	Scale - 1" = 100'	Sheet MB of 12