


B.M. "□" on Center of 14' Inlet, 50'
Left of Sta. 30 + 69 Elevation 634.90'

Harris Corporation

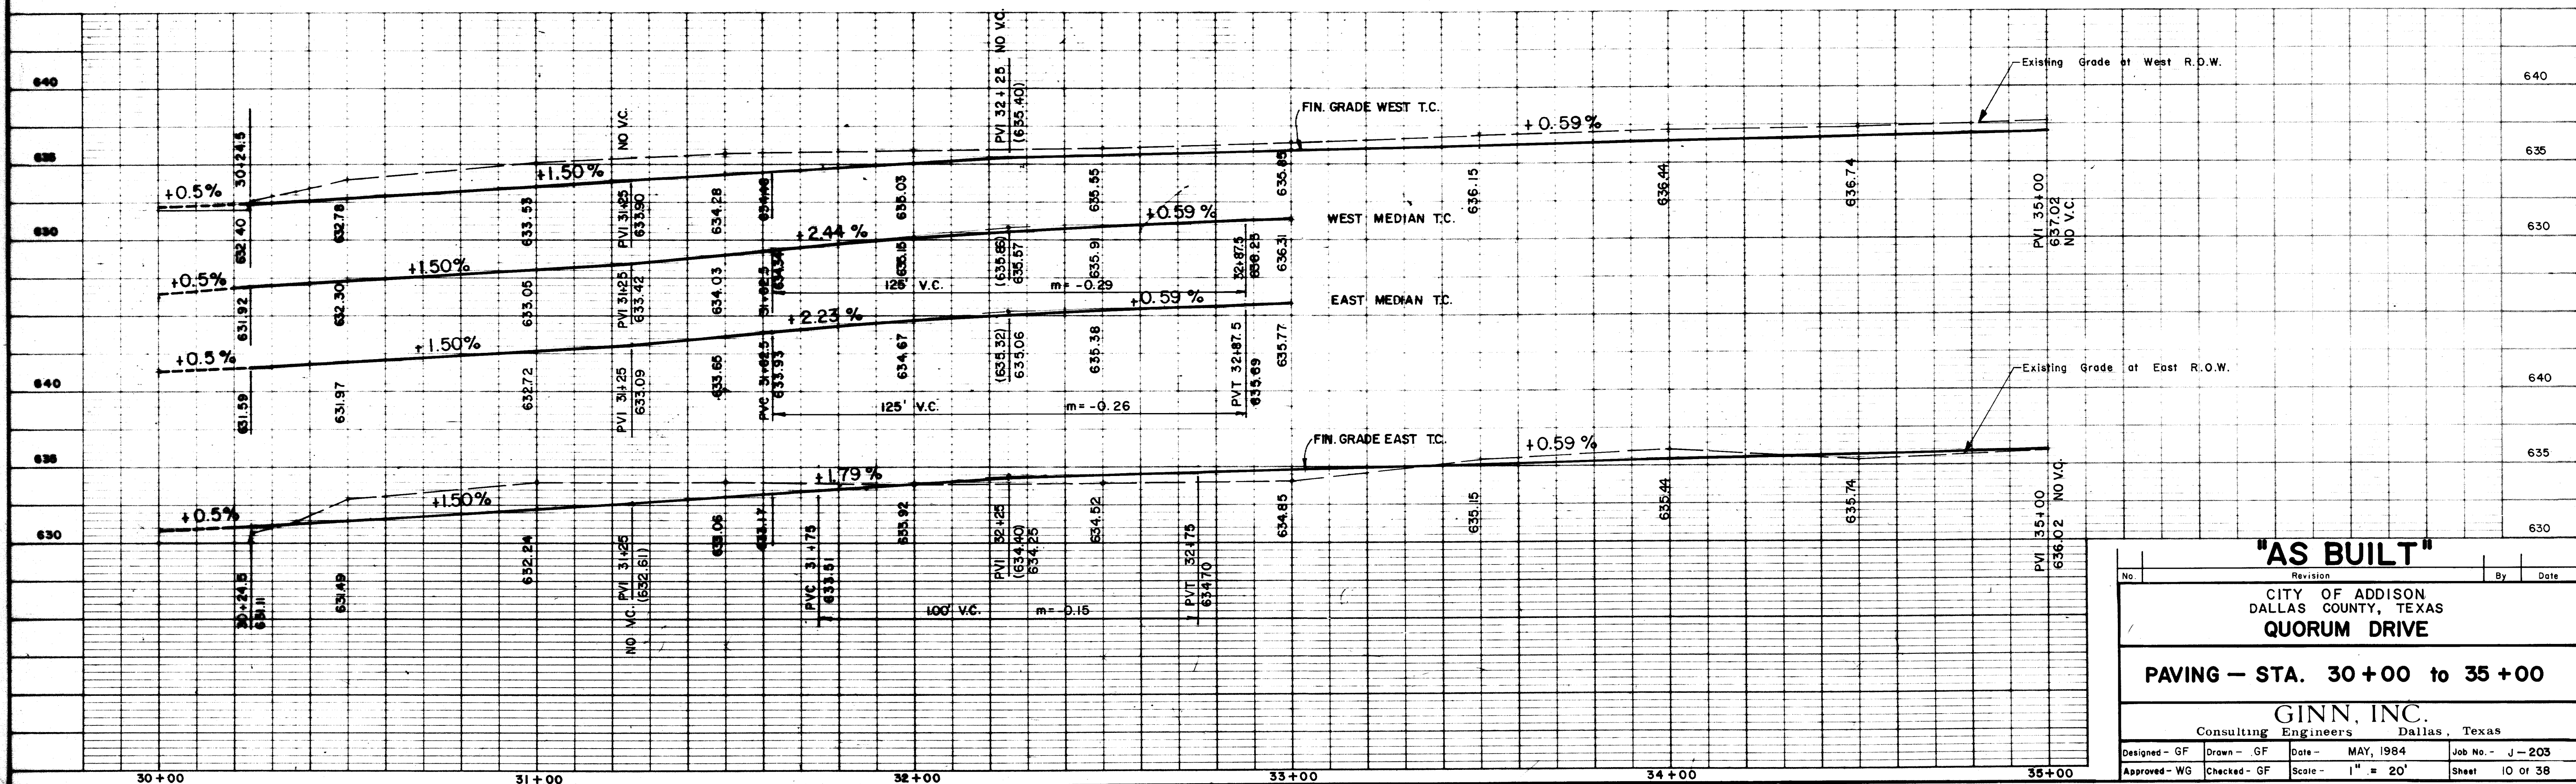

"AS BUILT"			
No.	Revision	By	Date
CITY OF ADDISON DALLAS COUNTY, TEXAS QUORUM DRIVE			
PAVING - STA. 30+00 to 35+00			
GINN, INC. Consulting Engineers Dallas, Texas			
Designed - GF	Drawn - GF	Date - MAY, 1984	Job No. - J-203
Approved - WG	Checked - GF	Scale - 1" = 20'	Sheet 10 of 38