



Curve Data

Δ	= 60°40'48"
T	= 248.75'
R	= 425.00'
L	= 450.10'

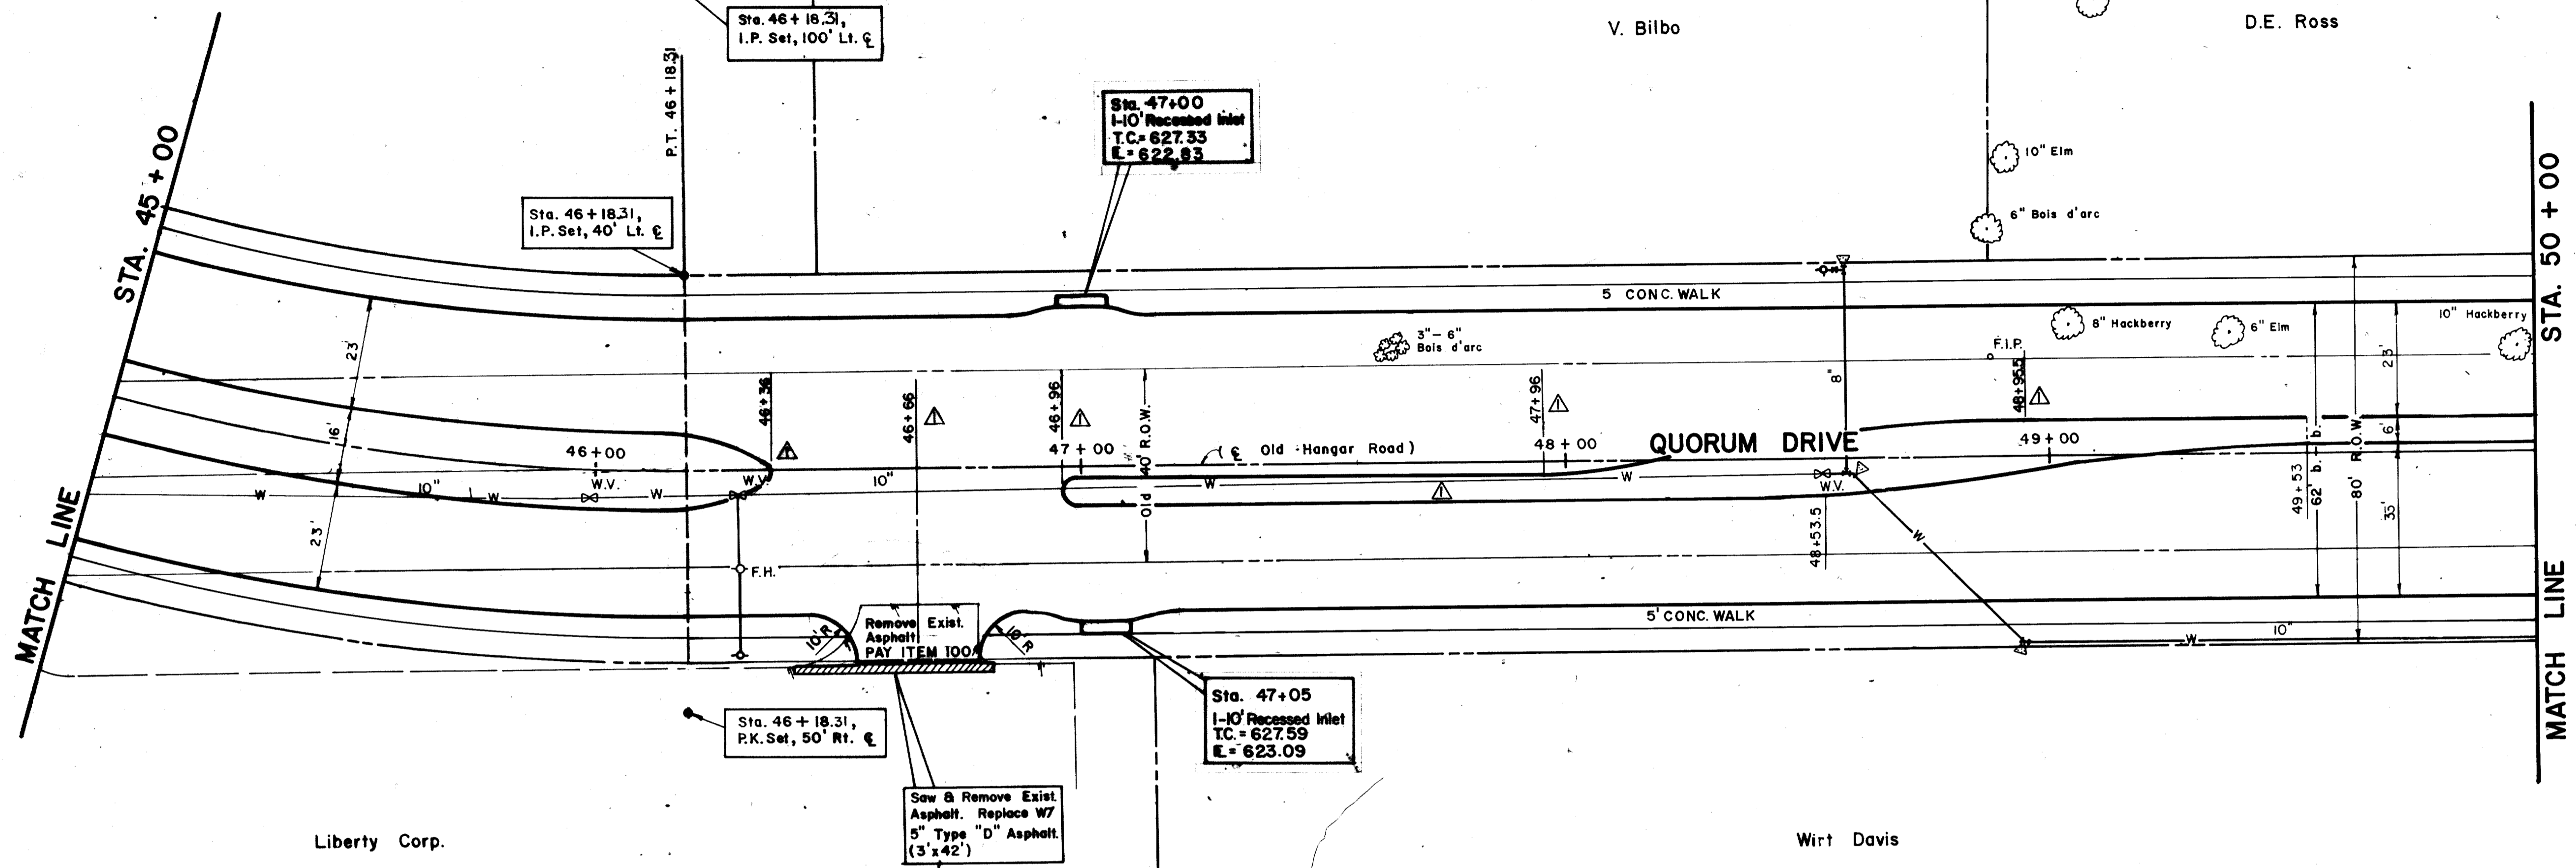

B.M. "D" On Northmost N.W. Corner United Fidelity Life Ins. Parking Lot - Sta. 46 + 91.50, 39.3' Rt. ϵ Elevation 627.58

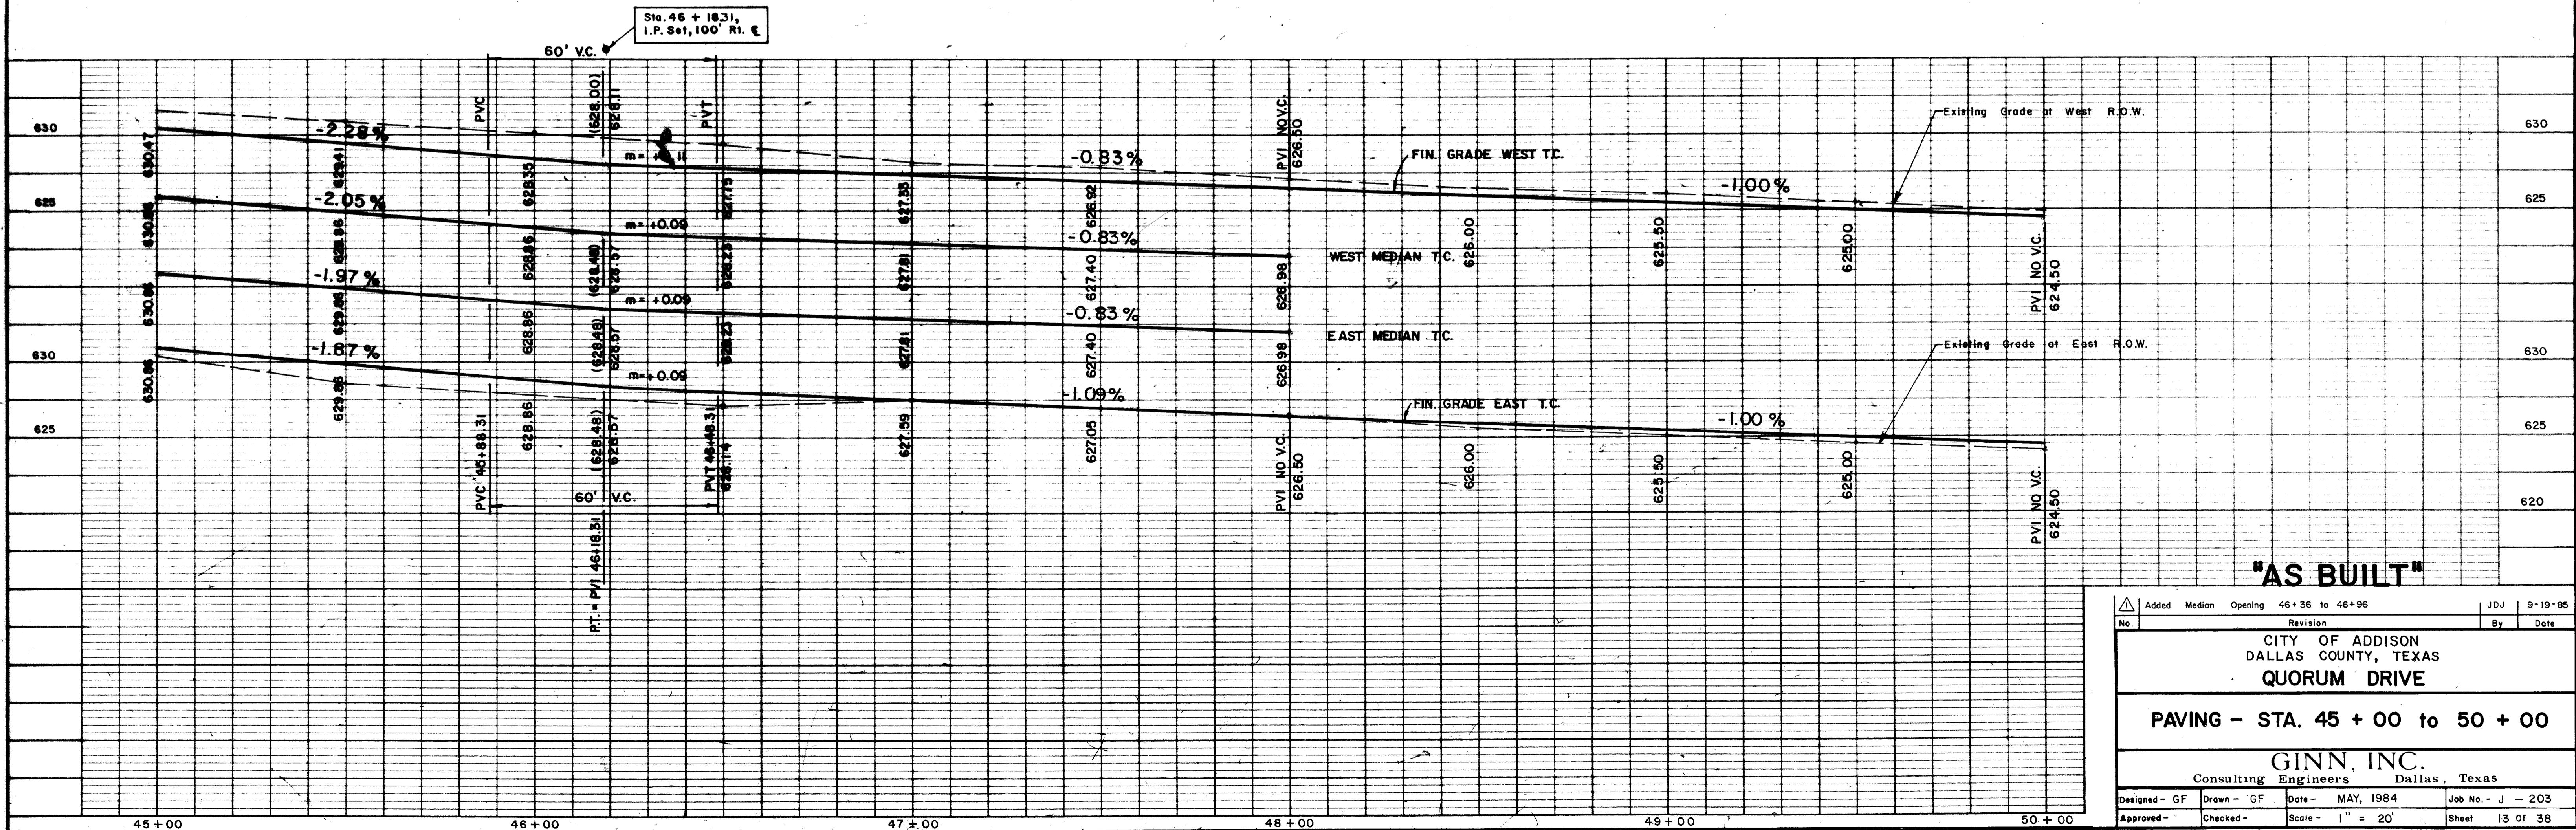

"AS BUILT"

Added	Median Opening	46+36 to 46+96	JDJ	9-19-85
No.	Revision		By	Date

CITY OF ADDISON
DALLAS COUNTY, TEXAS
QUORUM DRIVE

PAVING - STA. 45 + 00 to 50 + 00

GINN, INC.
Consulting Engineers Dallas, Texas

Designed - GF	Drawn - GF	Date - MAY, 1984	Job No. - J - 203
Approved -	Checked -	Scale - 1" = 20'	Sheet 13 of 38