


CITY OF ADDISON DALLAS COUNTY, TEXAS

QUORUM DRIVE PAVING, DRAINAGE AND UTILITIES

FROM ARAPAHO ROAD NORTH TO WESTGROVE

PROJECT LENGTH: ±6108 L.F.

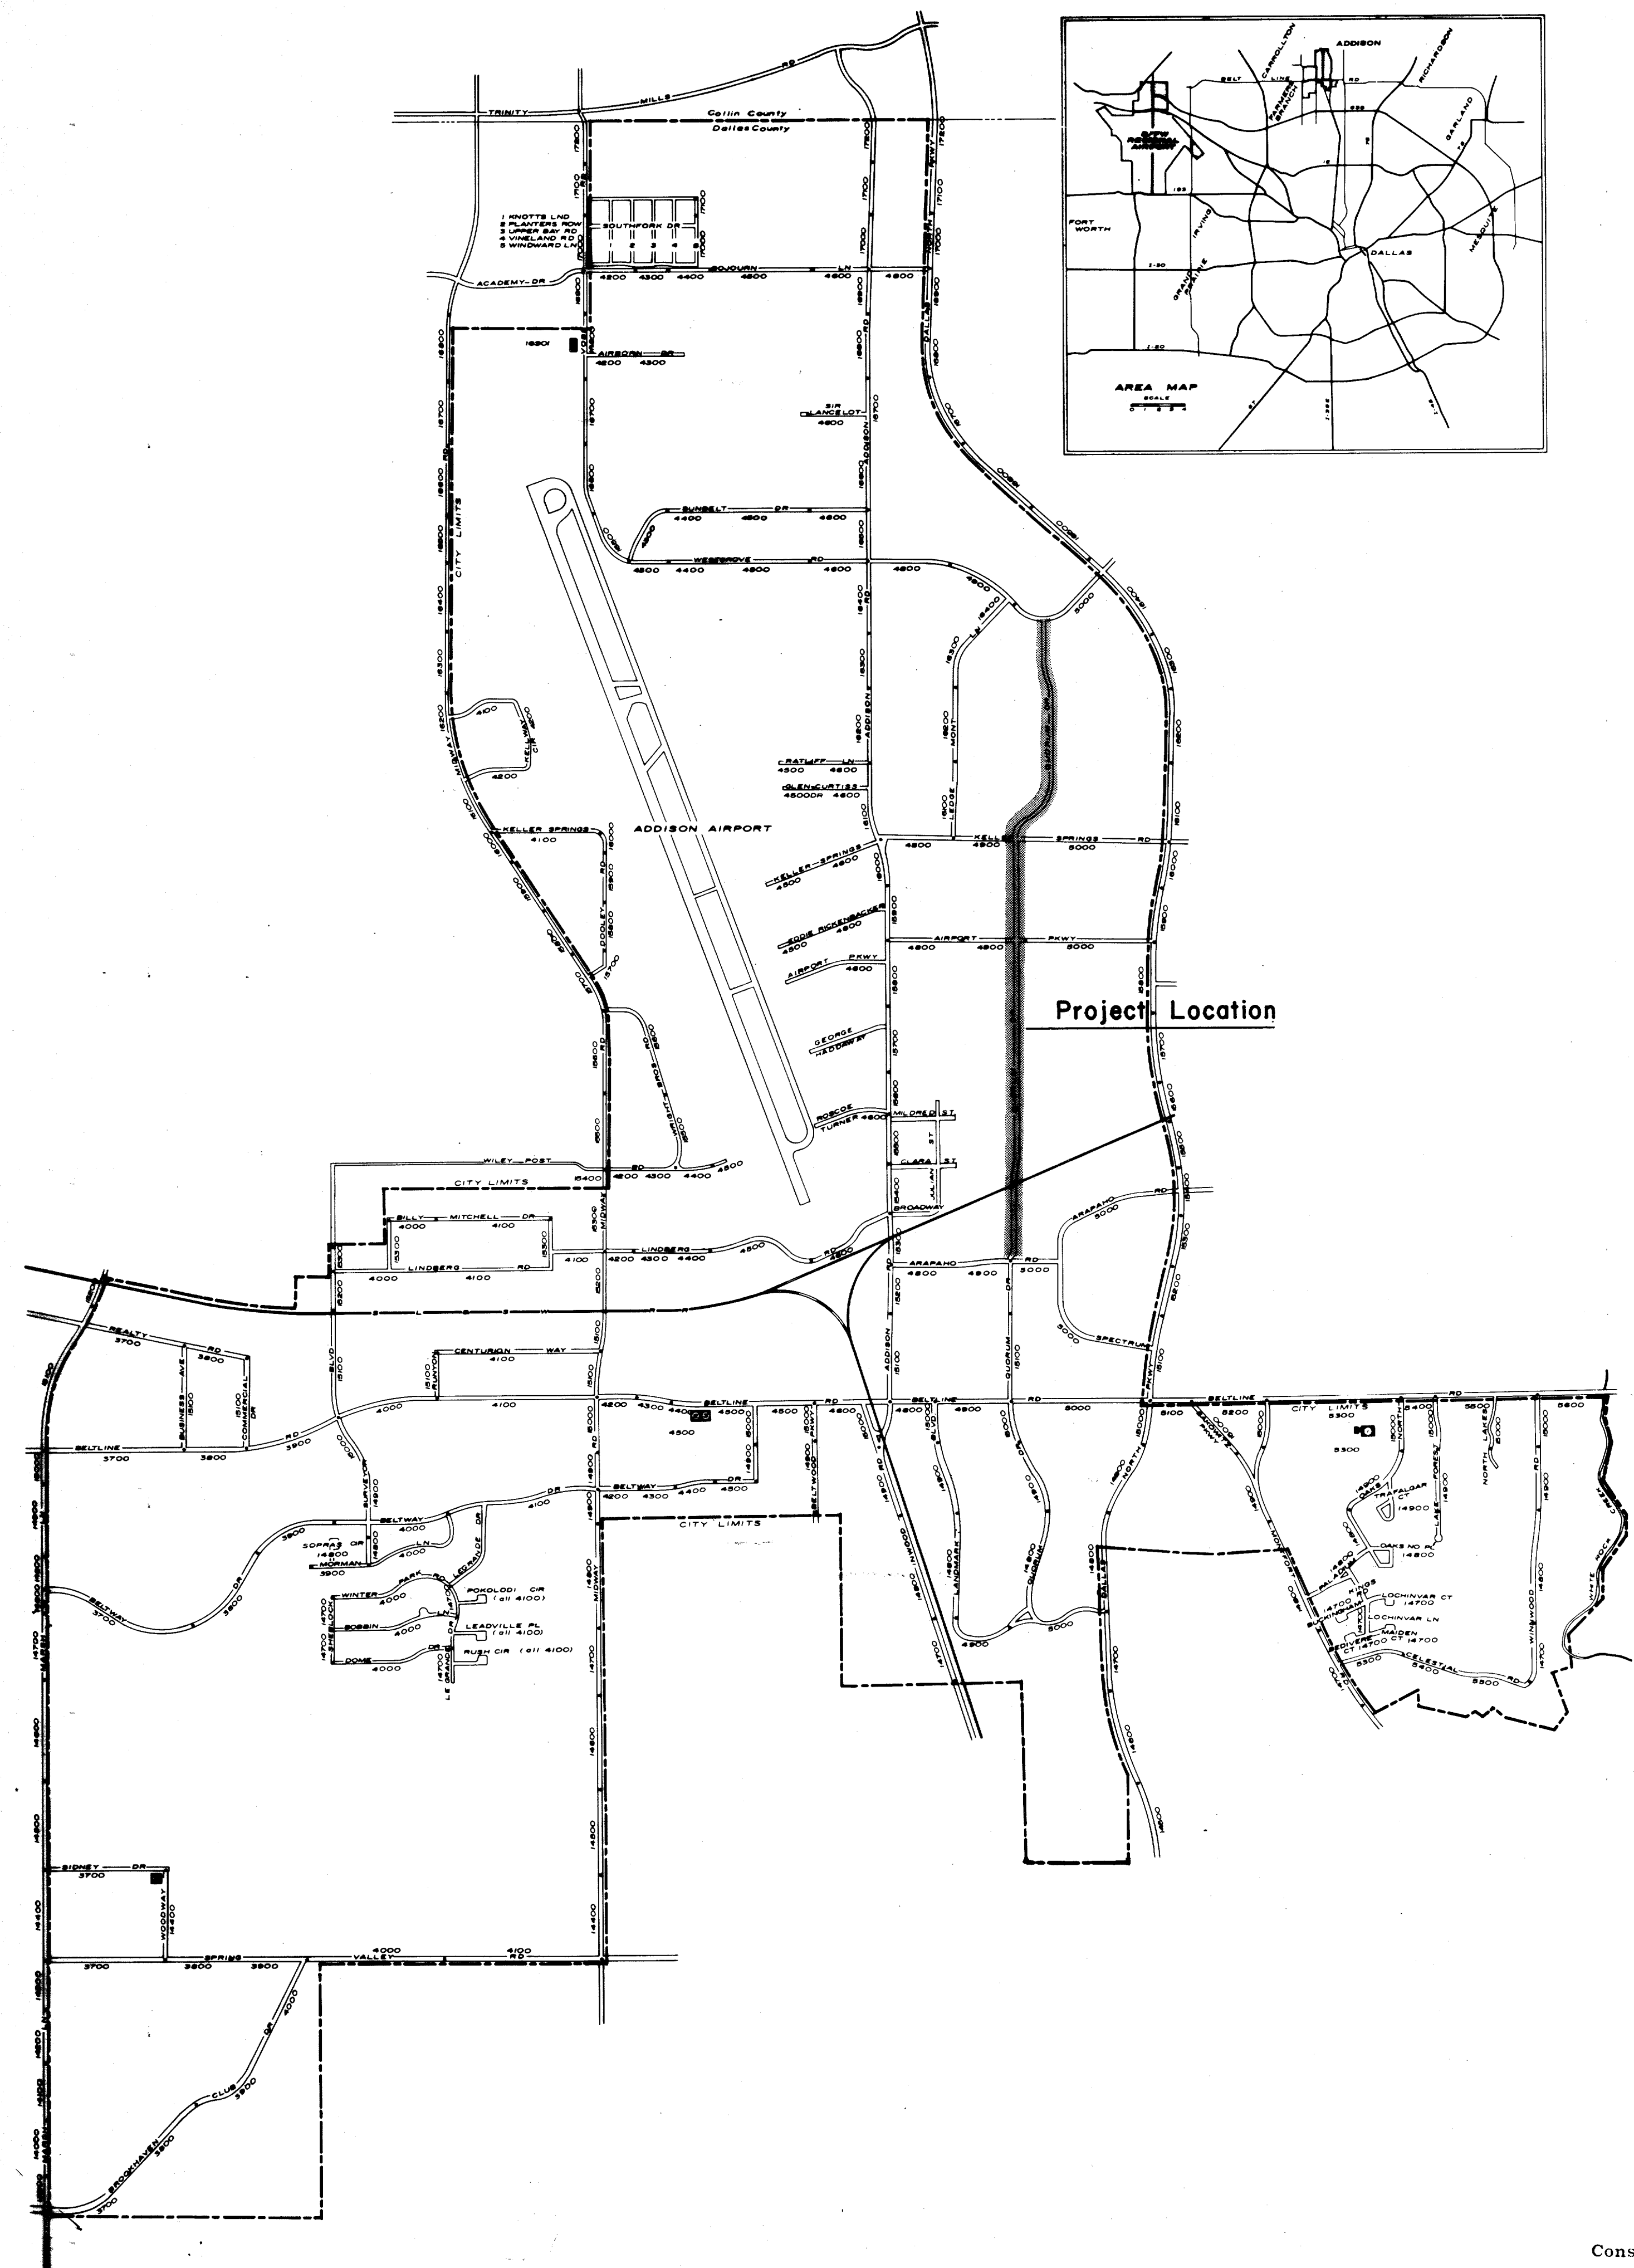

CITY OF ADDISON

- Mayor:
Jerry J. Redding
Council Members:
John B. Allen
Richard Roder
Barry Finkelstein
Stewart Beatty
Greg Cole
City Manager:
Ron Whitehead

"AS BUILT"
CITY OF ADDISON
Approved By: _____
Mayor

GINN, INC.
Consulting Engineers Dallas, Texas
MAY, 1984