


Curve Data
 $\Delta = 60^\circ 40' 48"$
 $T = 248.75'$
 $R = 425.00'$
 $L = 450.10'$

5th Sm. Curve Data
 $\Delta = 55^\circ 02' 45"$
 $R = 400.0'$
 $L = 384.29'$
 $T = 208.43'$
 $D = 14^\circ 19' 26"$

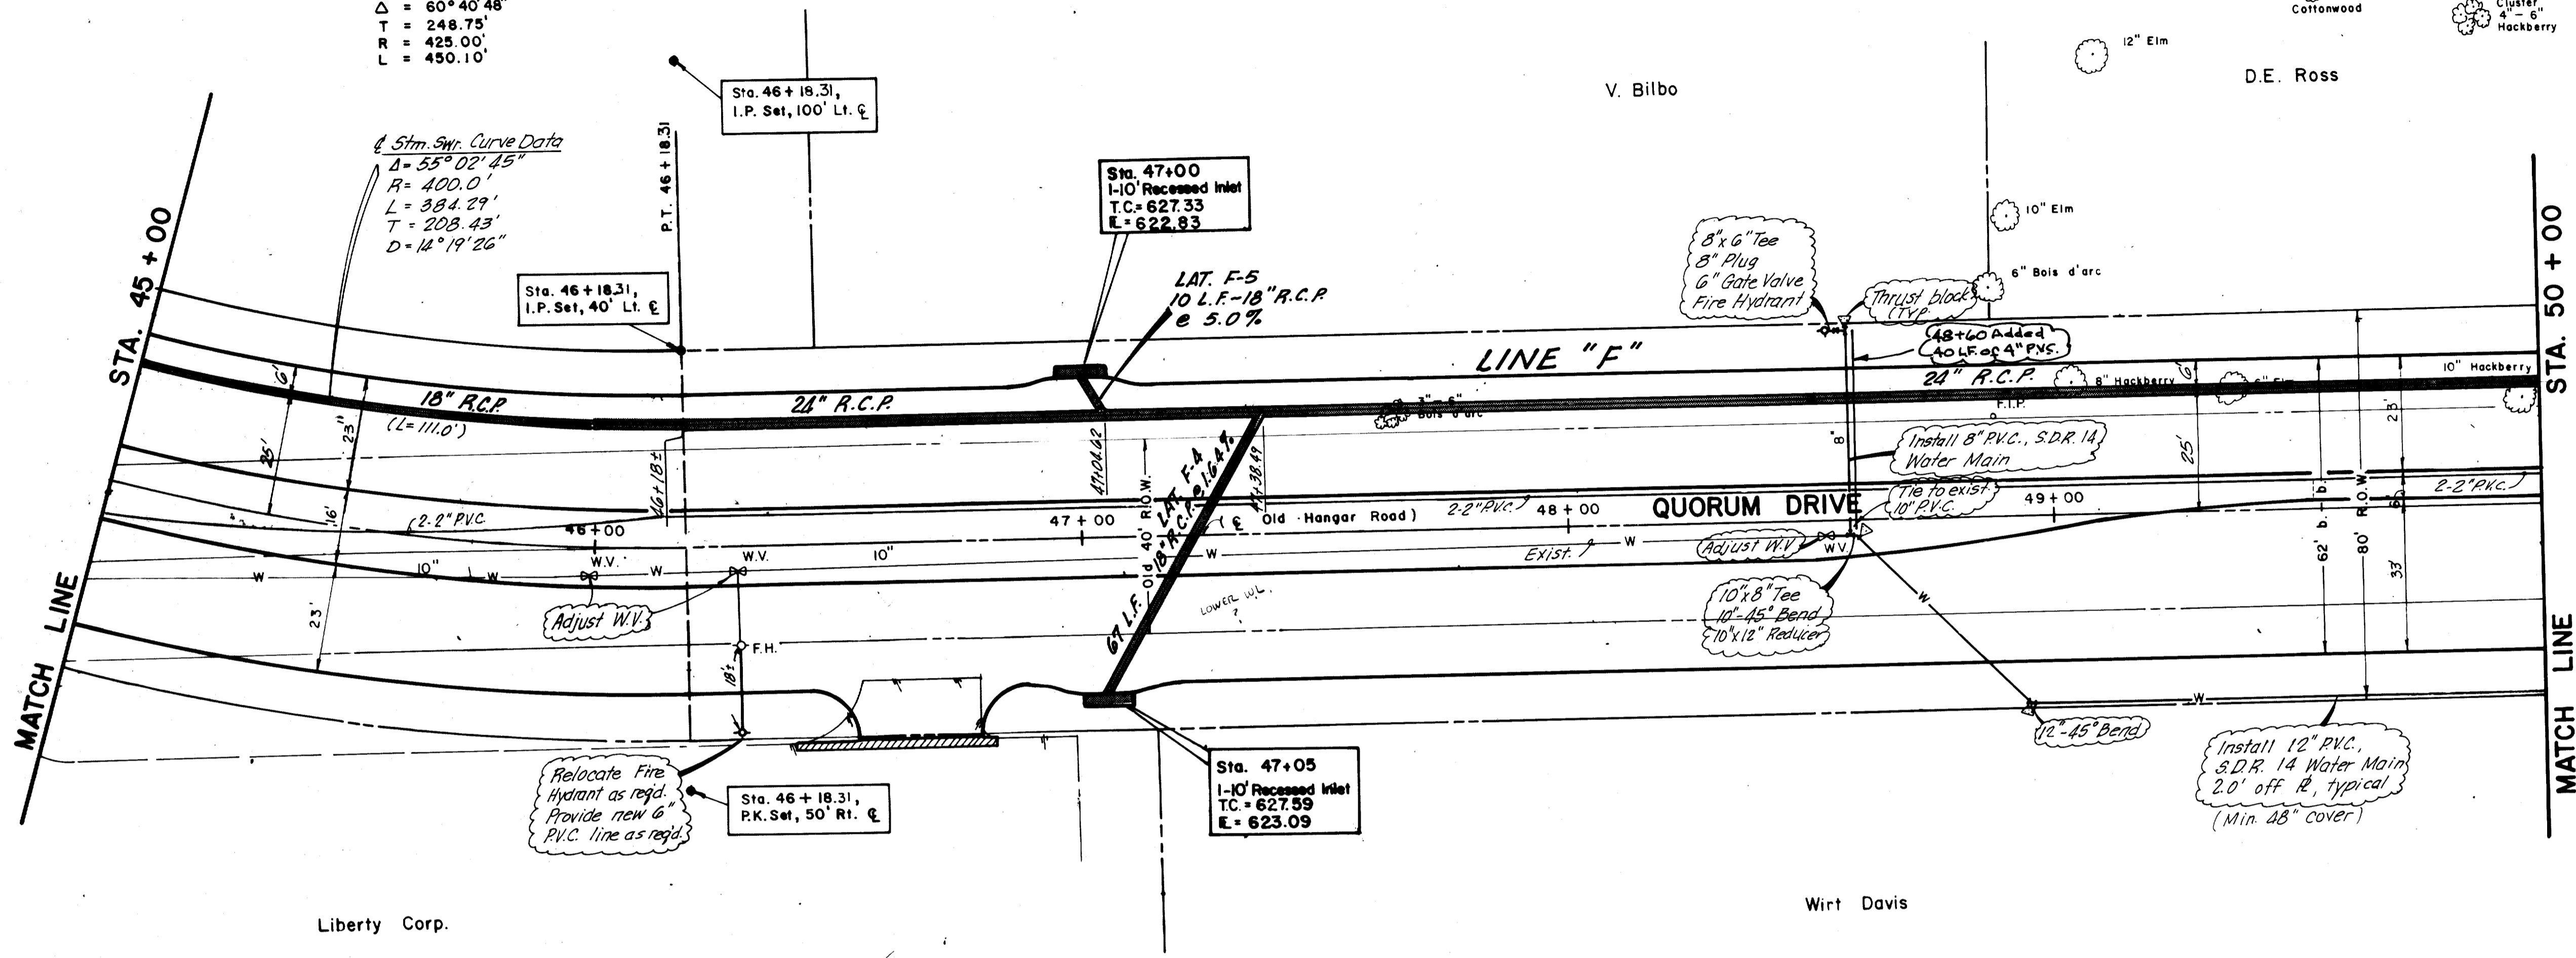

Sta. 46+18.31
I.P. Set, 40' Lt. ξ

Sta. 47+00
1-10' Recessed Inlet
T.C. = 627.33
E. = 622.93


LAT. F-5
10 L.F.-18" R.C.P.
@ 5.0%

Sta. 46+18.31
P.K. Set, 50' Rt. ξ

Sta. 47+05
1-10' Recessed Inlet
T.C. = 627.59
E. = 623.09

Sta. 46+18.31
I.P. Set, 100' Rt. ξ

B.M. "D" On Northmost N.W. Corner United Fidelity Life Ins. Parking Lot - Sta. 46 + 91.50, 39.3' Rt. ξ Elevation 627.58

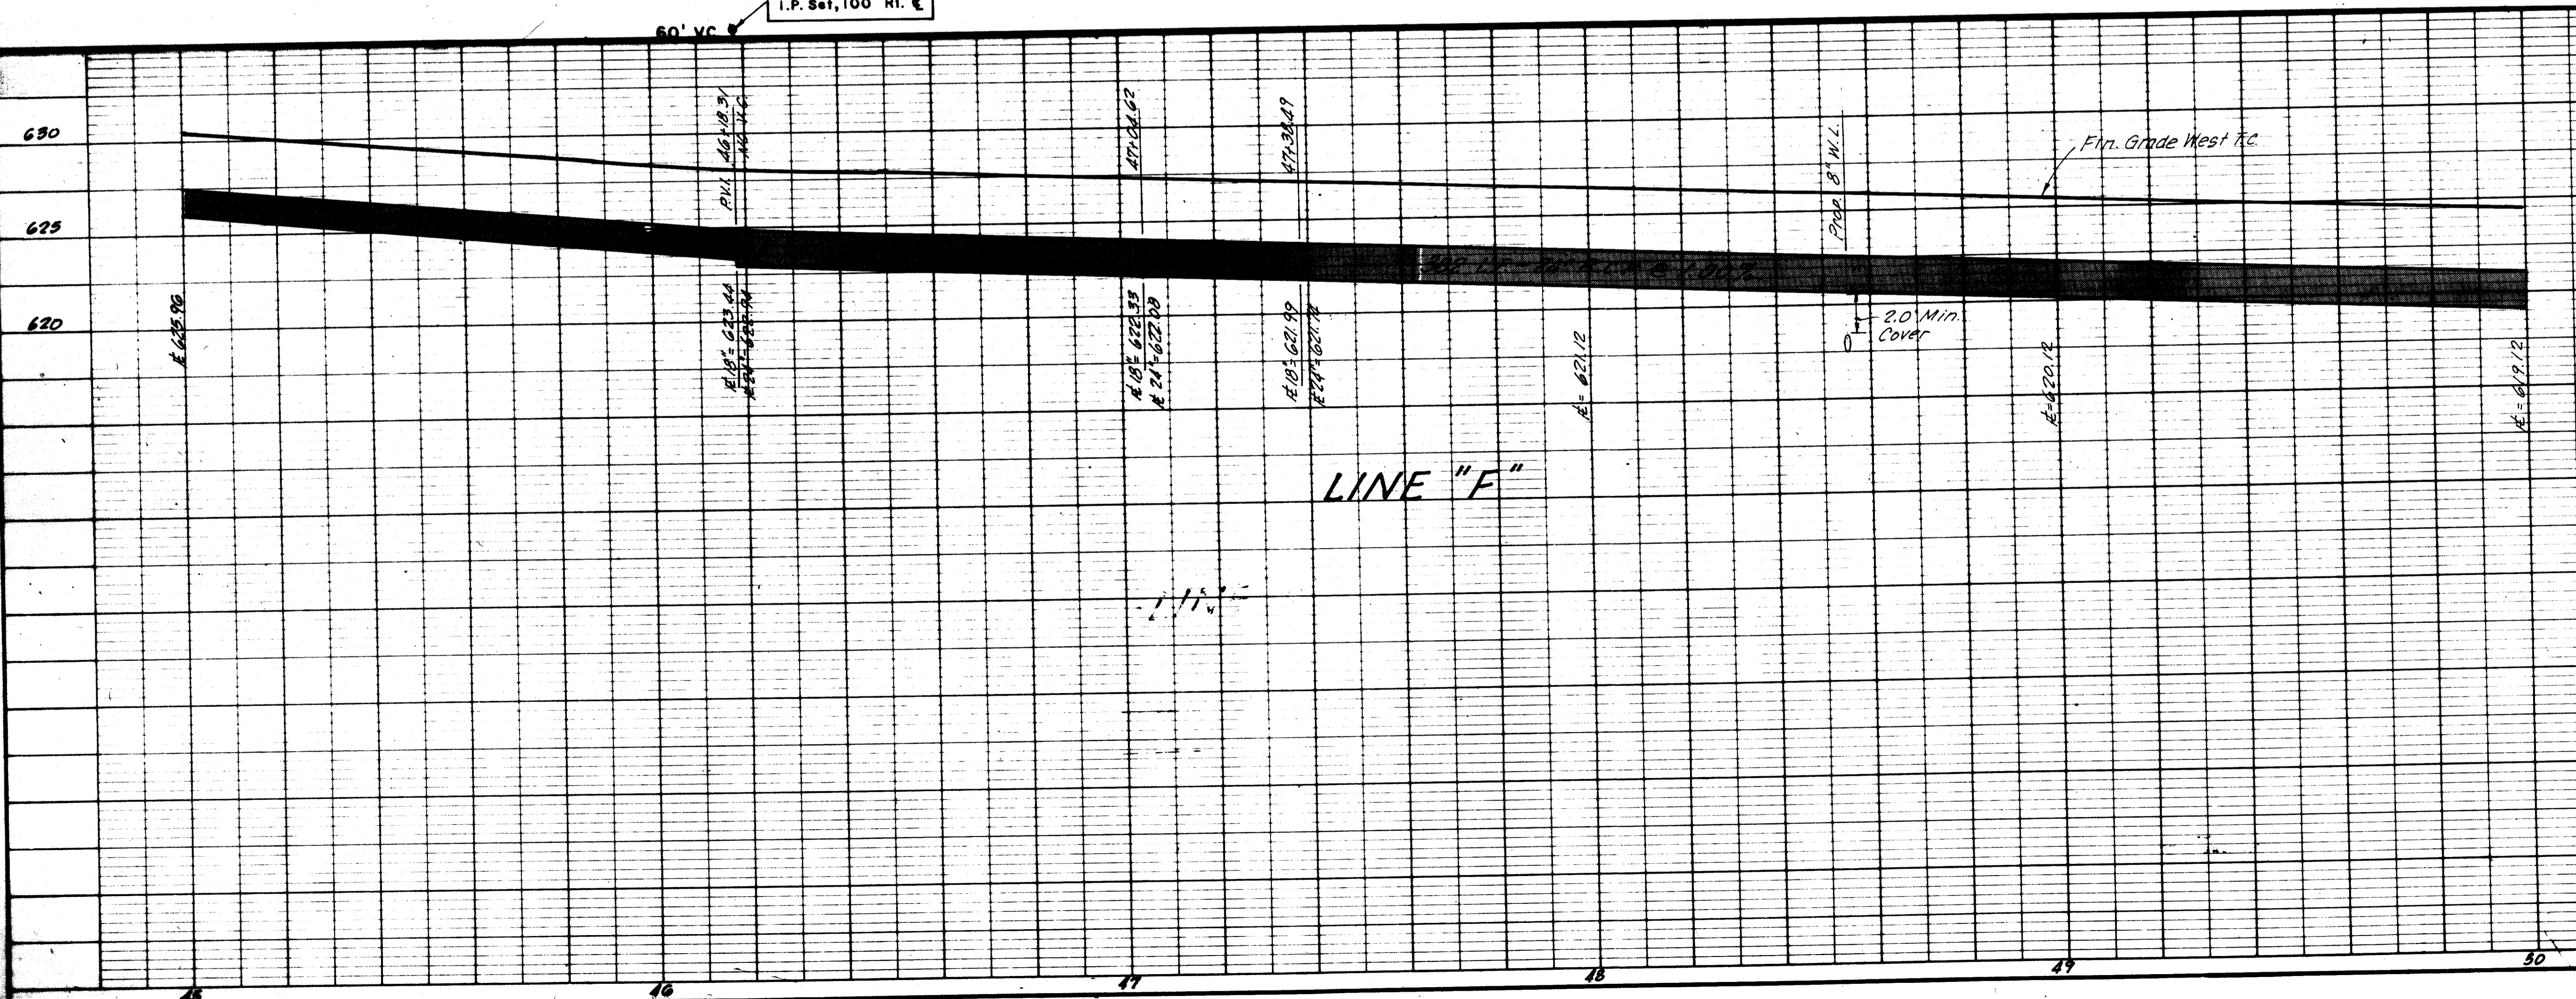

"AS BUILT"			
No.	Revision	By	Date
CITY OF ADDISON DALLAS COUNTY, TEXAS QUORUM DRIVE			
DRAINAGE - STA. 45+00 to 50+00			
GINN, INC. Consulting Engineers Dallas, Texas			
Designed - G.E.	Drawn - G.F.-RB	Date - MAY, 1984	Job No. - 4-100
Approved - HWG	Checked - HBJ	Scale - 1" = 30'	Sheet 27 of 38