


Paving Plan/Profile Street No. Drainage Plan/Profile Sheet No.

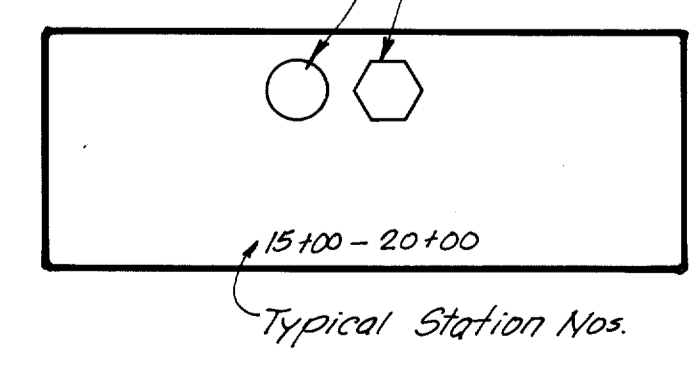

"AS BUILT"

No.	Revision	By	Date
CITY OF ADDISON DALLAS COUNTY, TEXAS QUORUM DRIVE			
SHEET INDEX			
GINN, INC. Consulting Engineers Dallas, Texas			
Designed - GF	Drawn - GF	Date - MAY 1984	Job No - J-203
Approved - WG	Checked - GF	Scale - 1" = 200'	Sheet 2 OF 38