



- GENERAL NOTES:**
- 1.) ALL CONCRETE FOR RIPRAP SHALL BE 6" THK., ATTAIN 3000psi. at 28 DAYS, AND SHALL BE REIN. W/ #3 at 24" o.c., e.w. UNLESS OTHERWISE NOTED.
  - 2.) CONCRETE RIPRAP SHALL BE PAID FOR UNDER PAY ITEM 432.
  - 3.) BOTTOM SLAB AND SLOPE SHALL BE POURED MONOLITHICALLY.


**ENLARGED PLAN - OFFSITE DITCH IMPROVEMENTS**

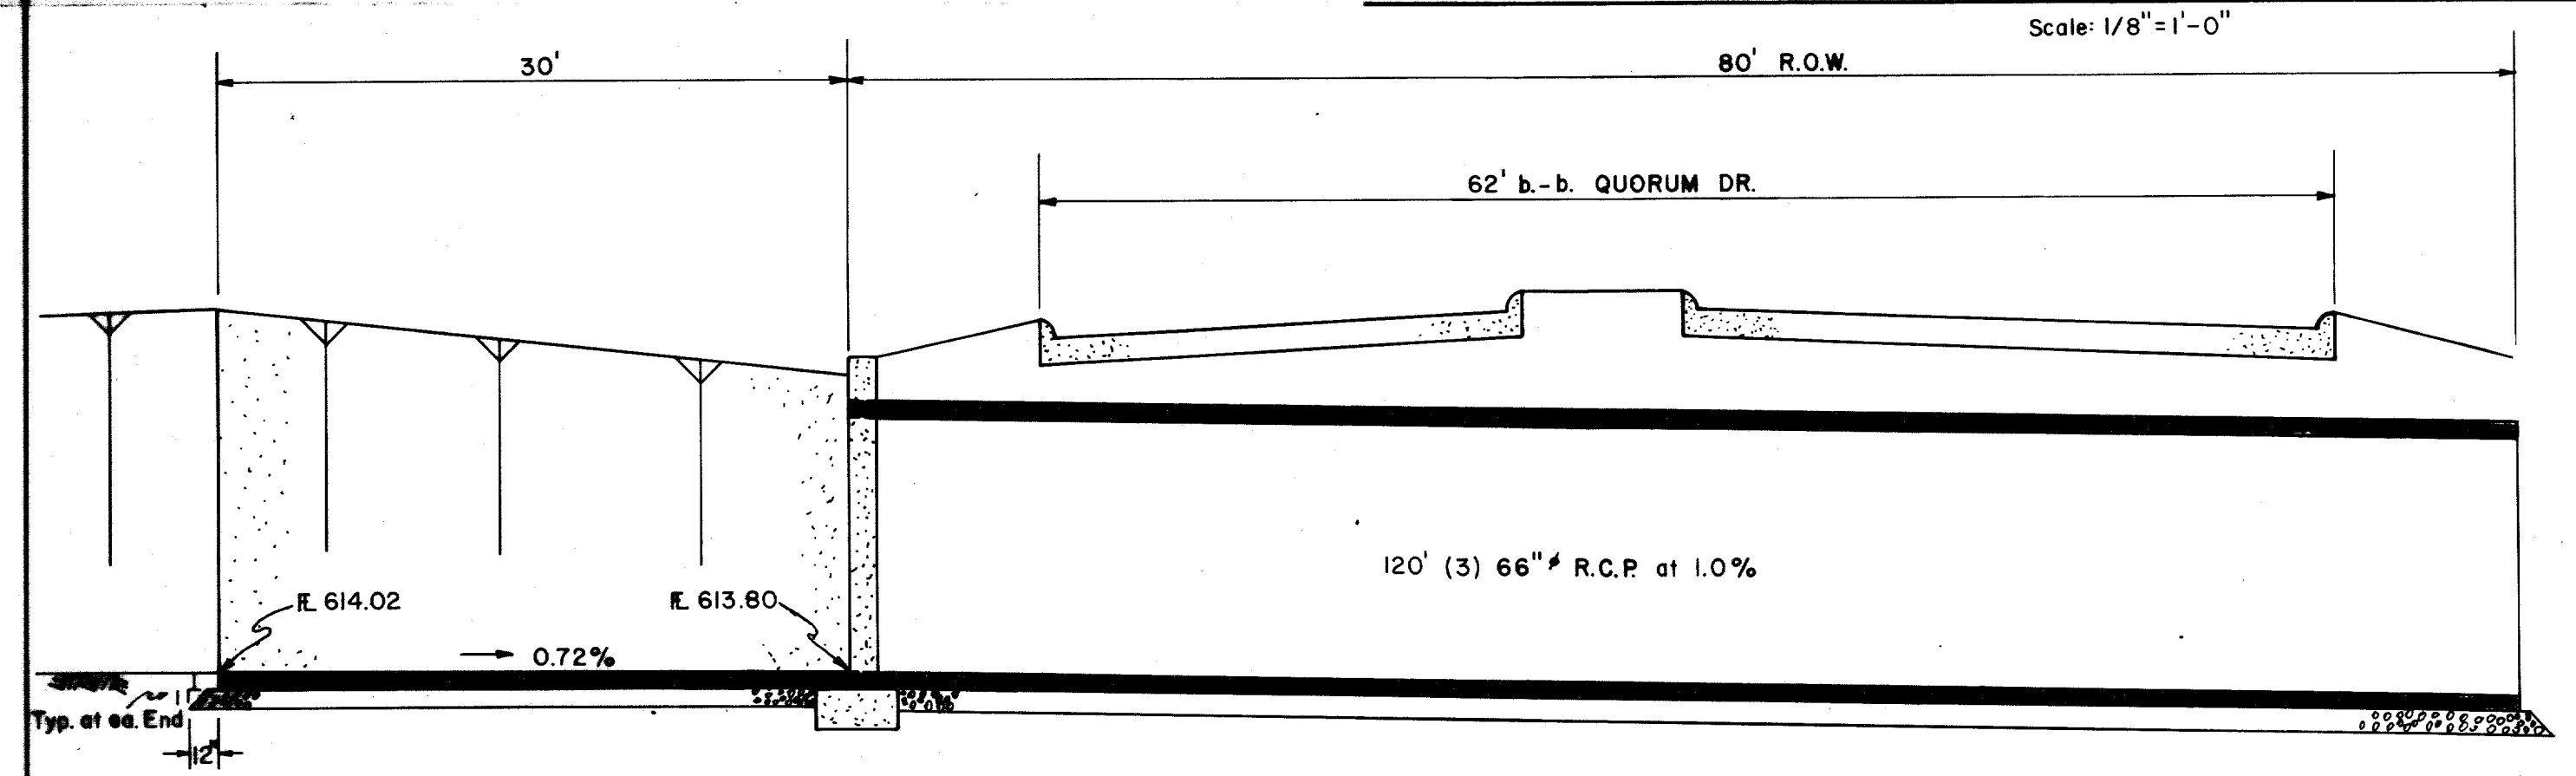


**PROFILE**  
Scale: N.T.S.

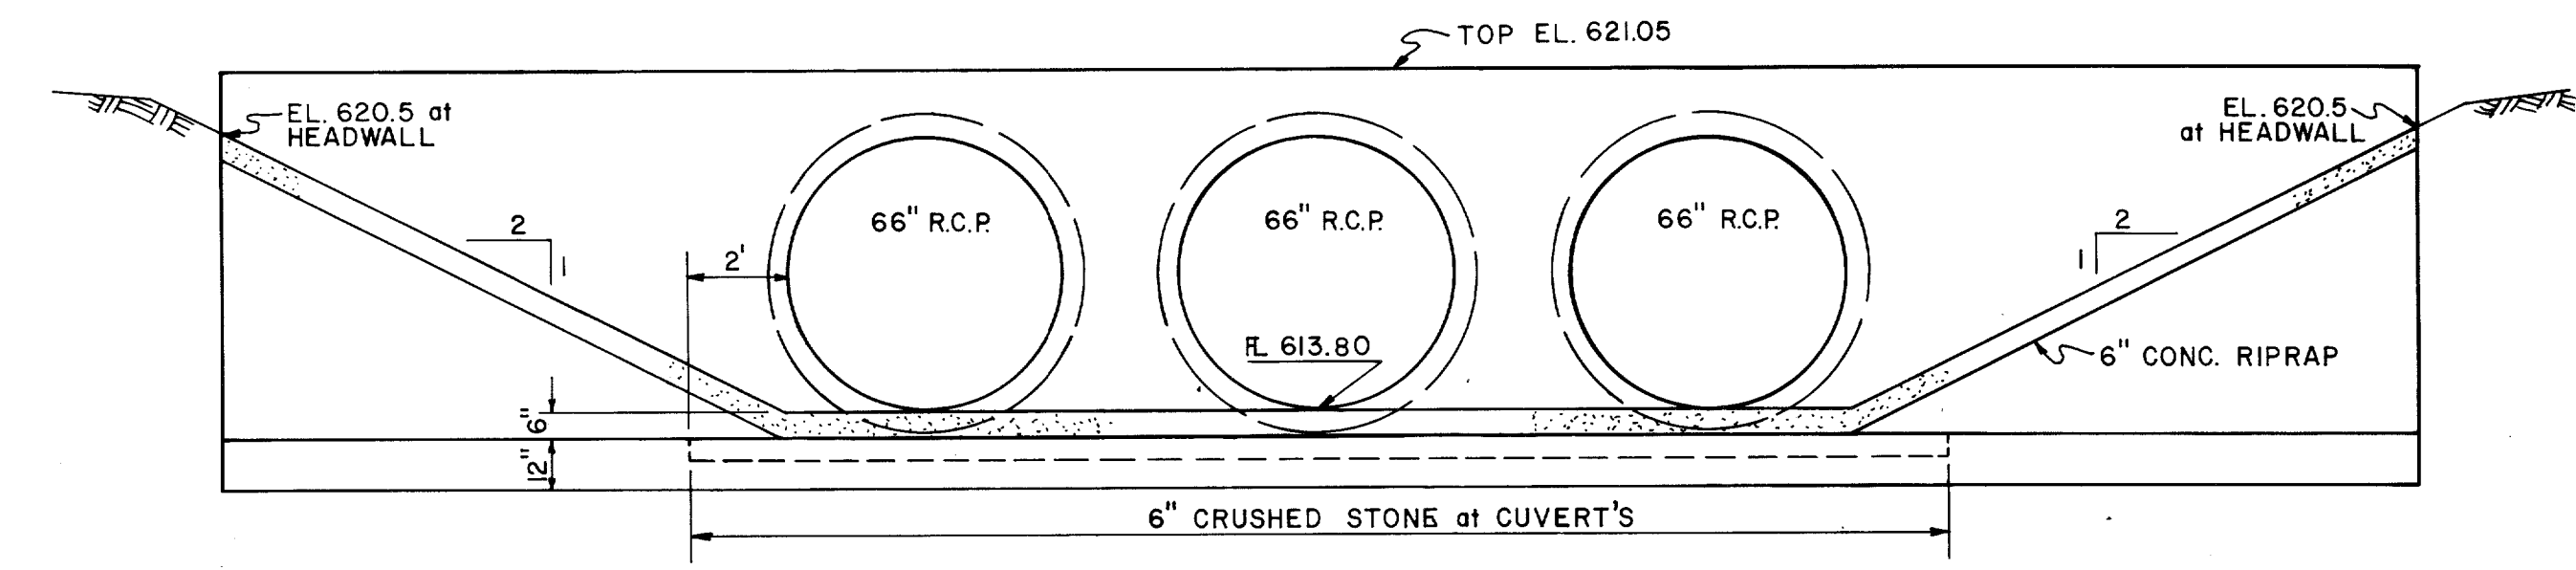


**ELEVATION (UPSTREAM)**

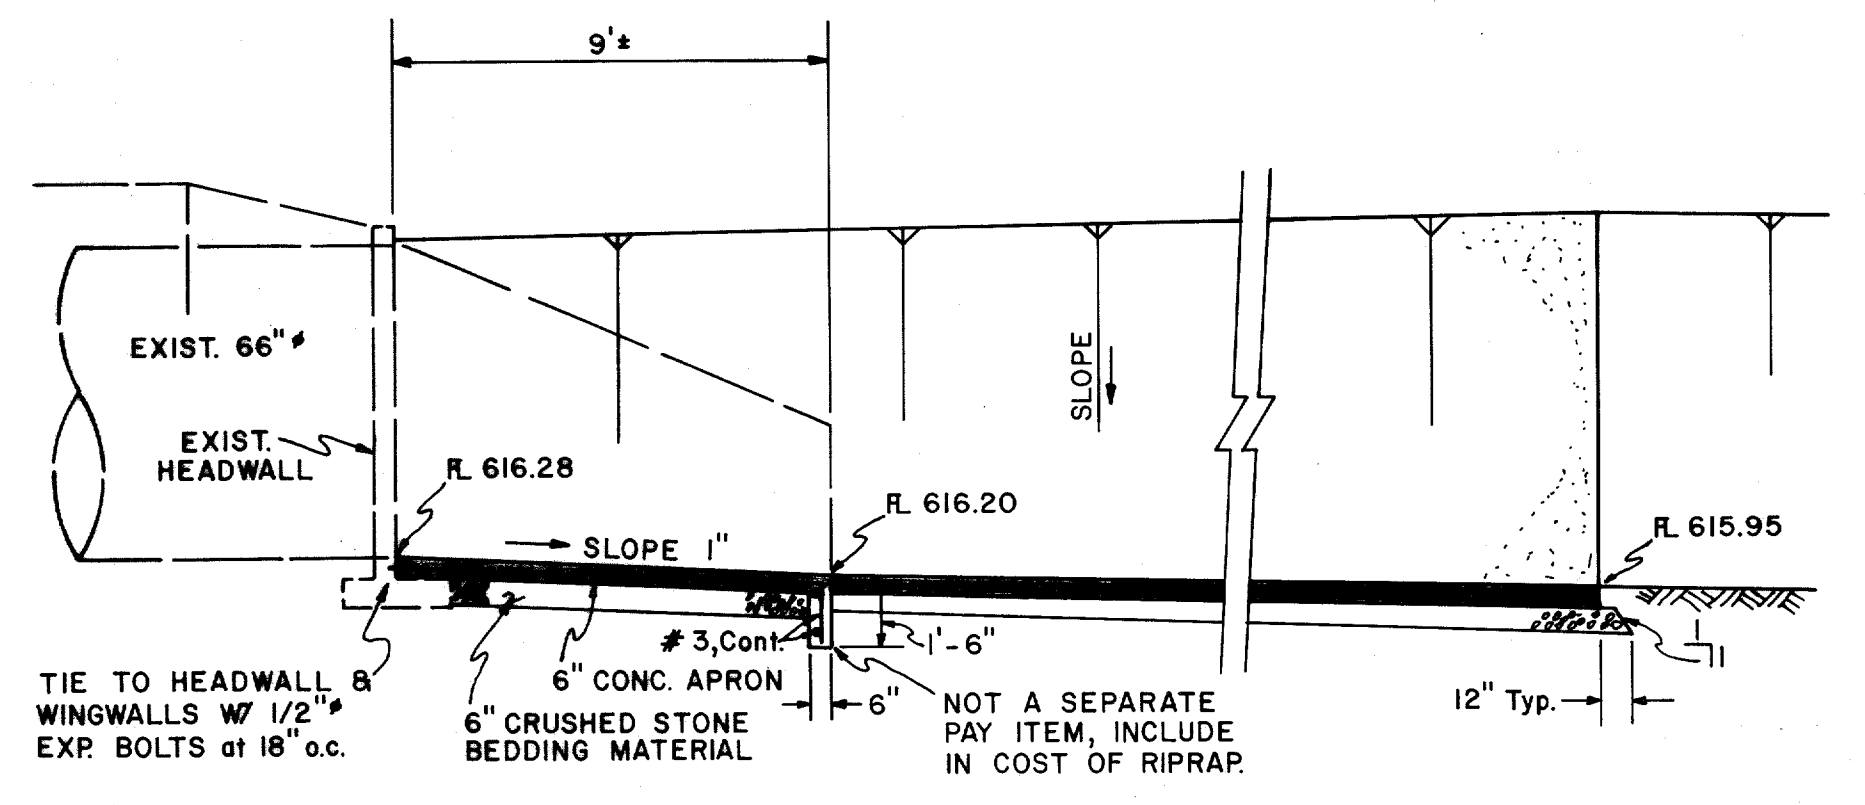

**SECTION**  
Scale: 1/4"=1'-0"

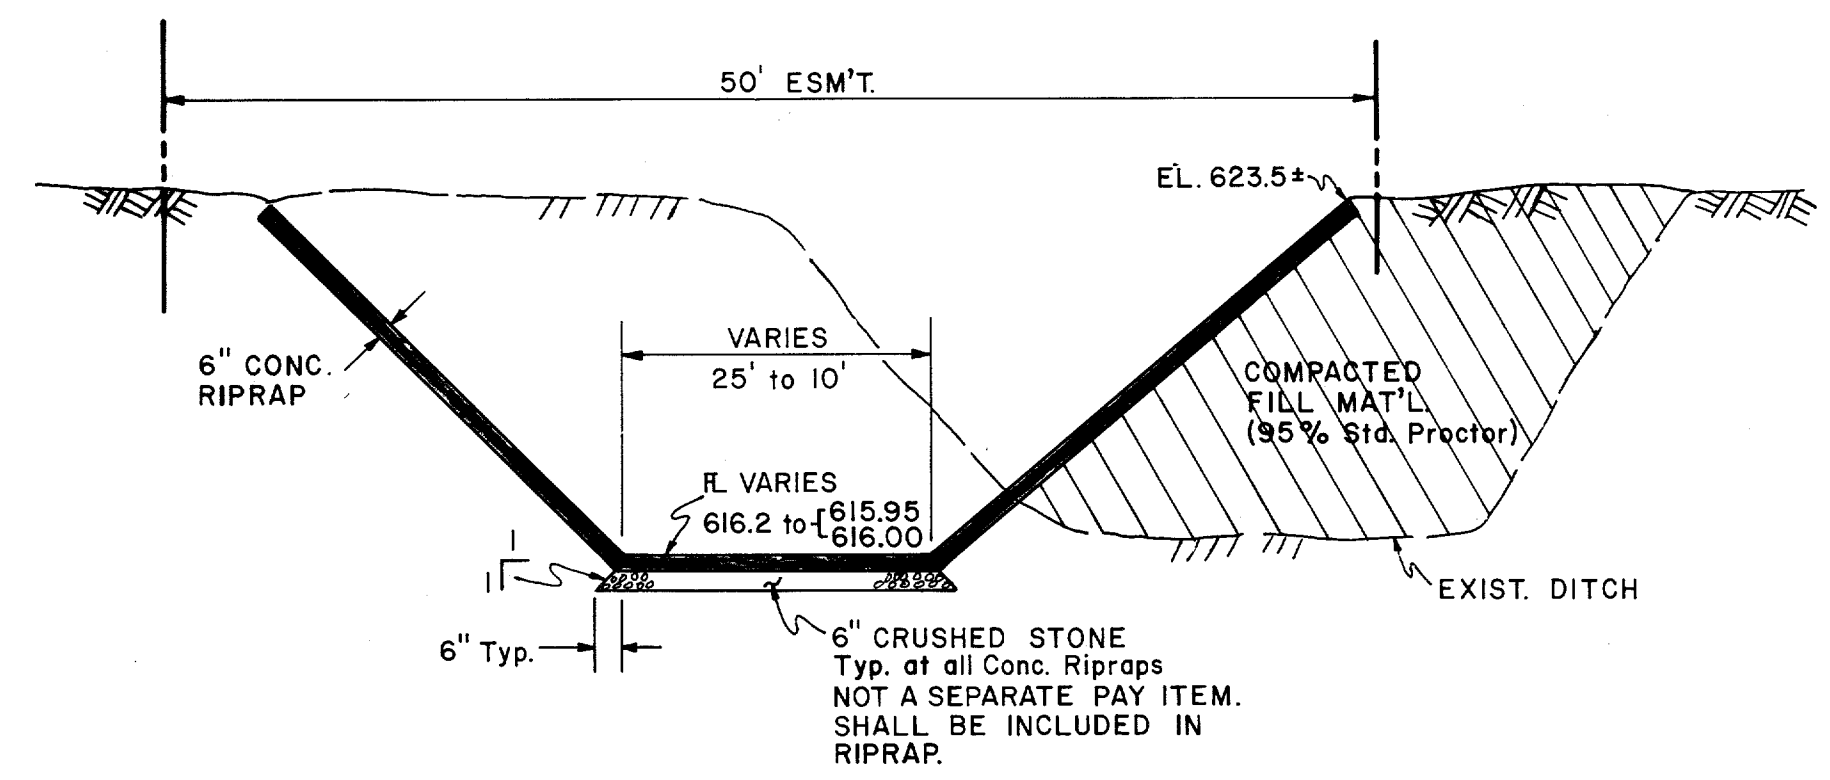

**TYP. SECTION at RIPRAP**  
Scale: 1/8"=1'-0" Horiz.  
1/4"=1'-0" Vert.

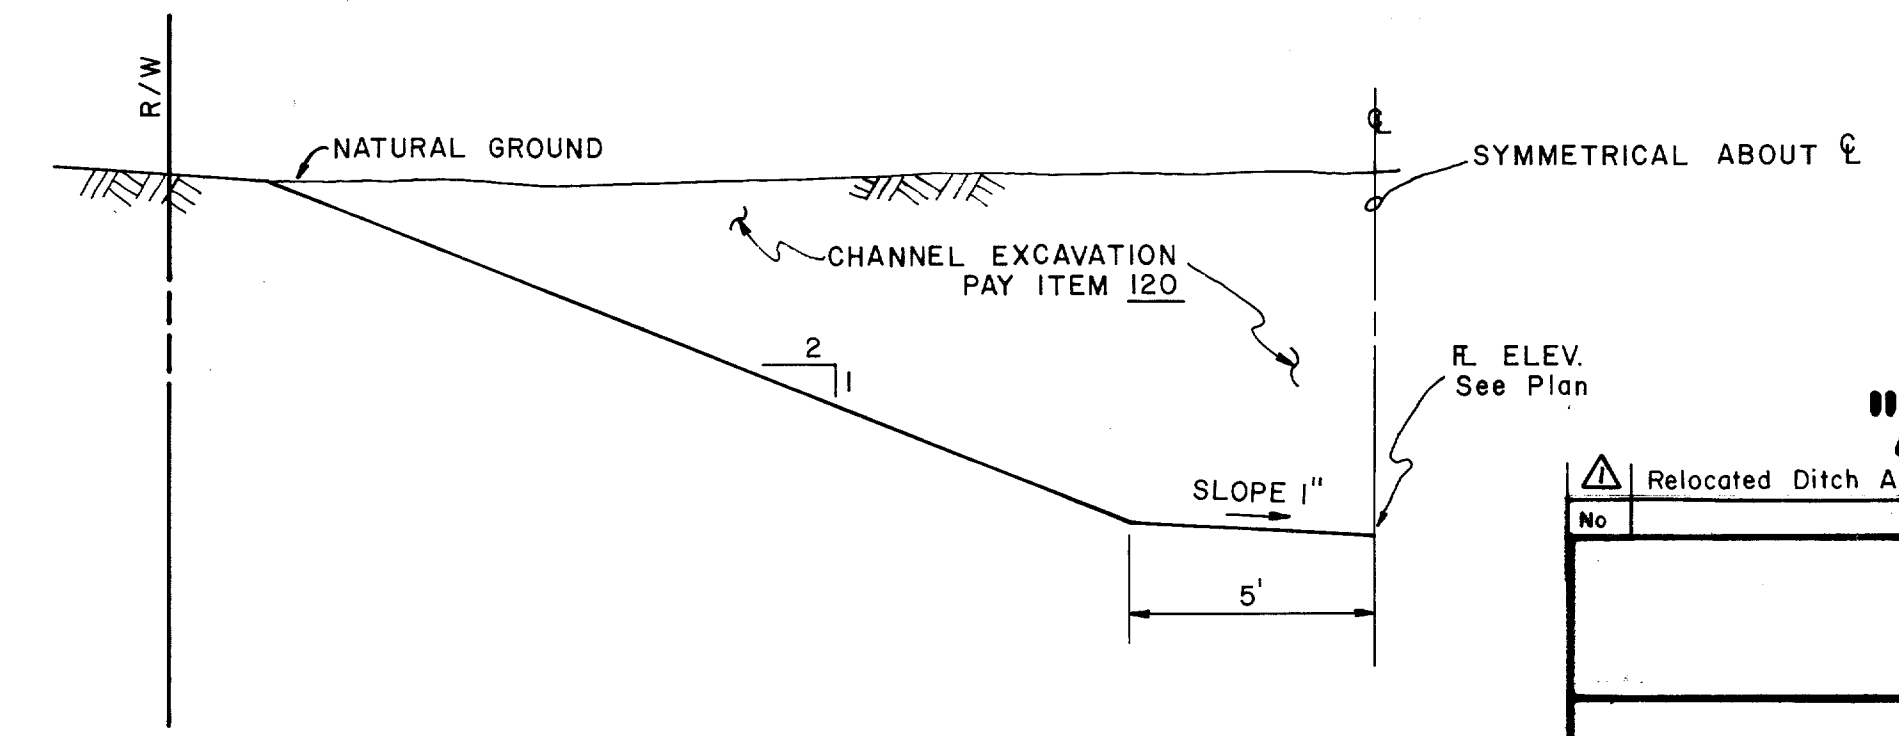

**TYP. EARTH CHANNEL**  
Scale: 1/4"=1'-0"

**"AS BUILT"**

Relocated Ditch And 3-66" R.C.P.		GF-LA-12/12/84
No.	Revision	By Date
CITY OF ADDISON DALLAS COUNTY, TEXAS QUORUM DRIVE		
OFFSITE DRAINAGE MISC. DETAILS/SECTIONS		
GINN, INC. Consulting Engineers Dallas, Texas		
DESIGN - GF	DRAWN - GAP	SCALE - AS SHOWN
APPROV'D - WG	CHK'D - GF	DATE - MAY, 1984
PROJ - J-203		SHEET - 31 of 38