



MATCH LINE

MATCH LINE

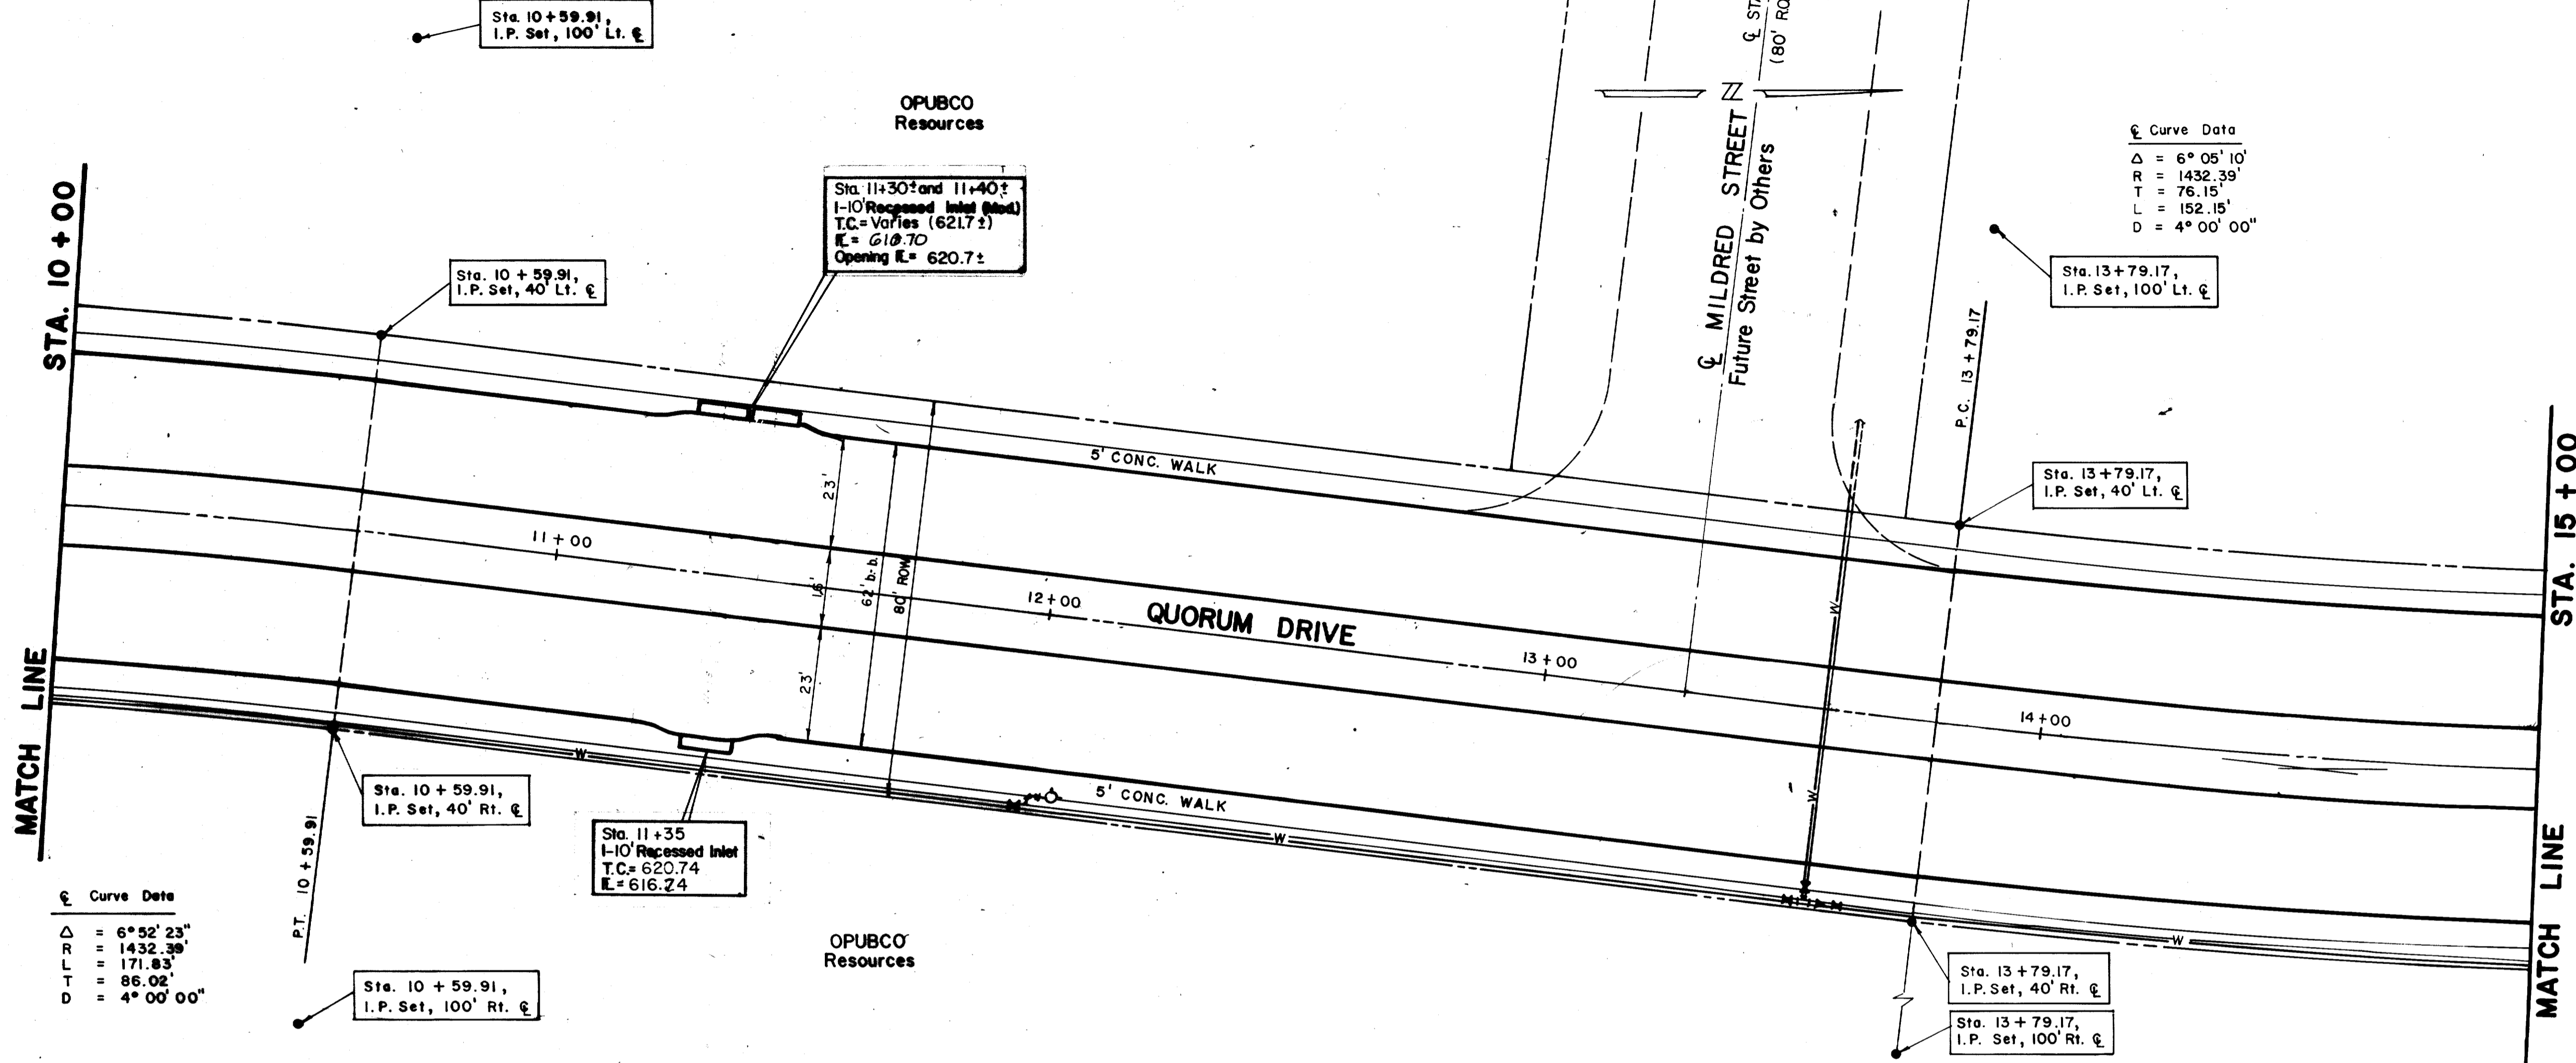

Curve Data
 $\Delta = 6^\circ 52' 23''$
 $R = 1432.39'$
 $T = 171.83'$
 $L = 86.02'$
 $D = 4^\circ 00' 00''$

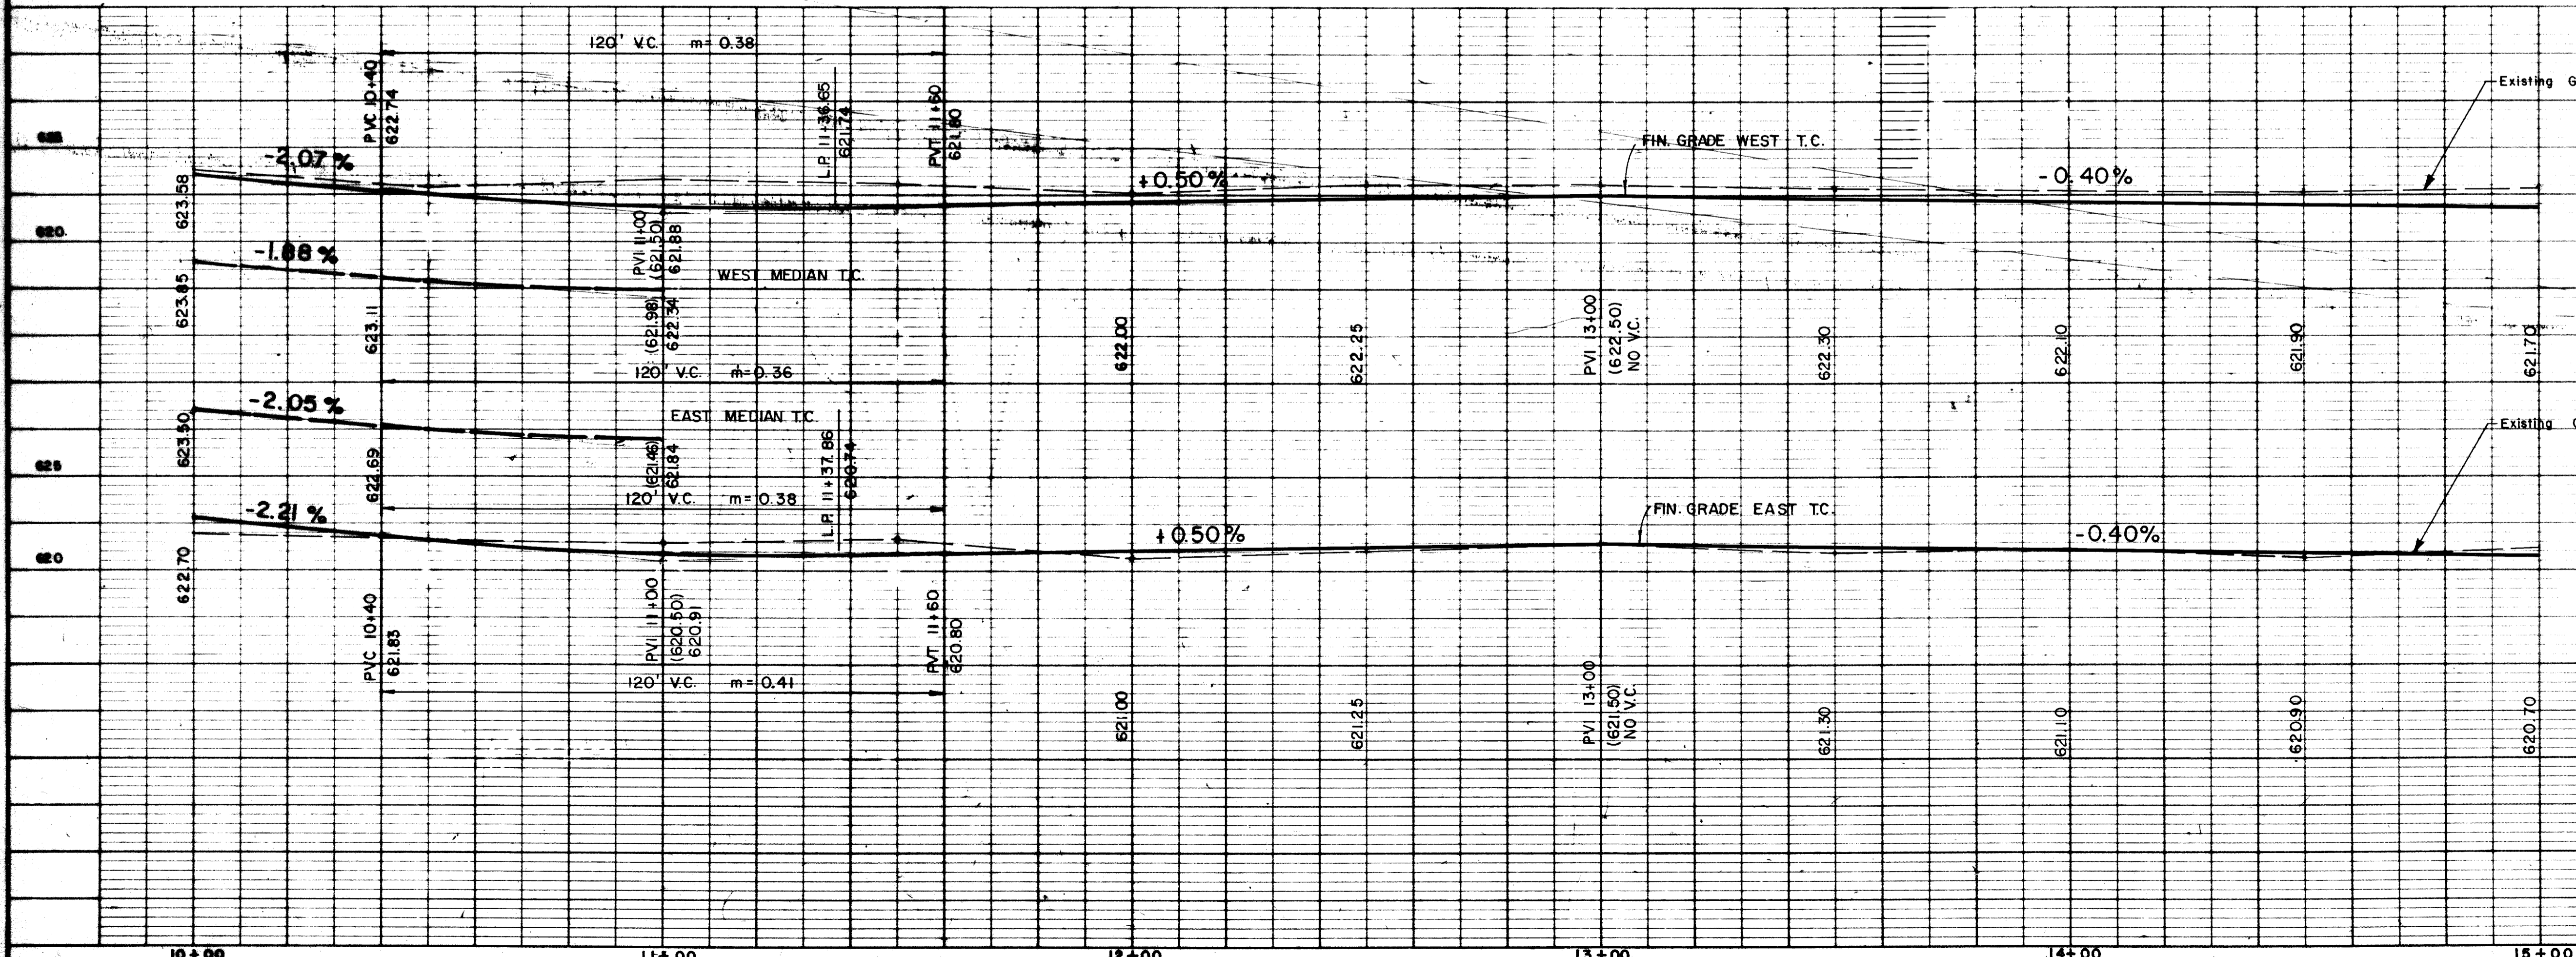

"AS BUILT"

No.	Revision	By	Date
CITY OF ADDISON DALLAS COUNTY, TEXAS QUORUM DRIVE			
PAVING - STA. 10+00 to 15+00			
GINN, INC. Consulting Engineers Dallas, Texas			
Designed - GF	Drawn - GF	Date - MAY, 1984	Job No. - J - 203
Approved - WG	Checked - GF	Scale - 1" = 20'	Sheet 6 of 38