
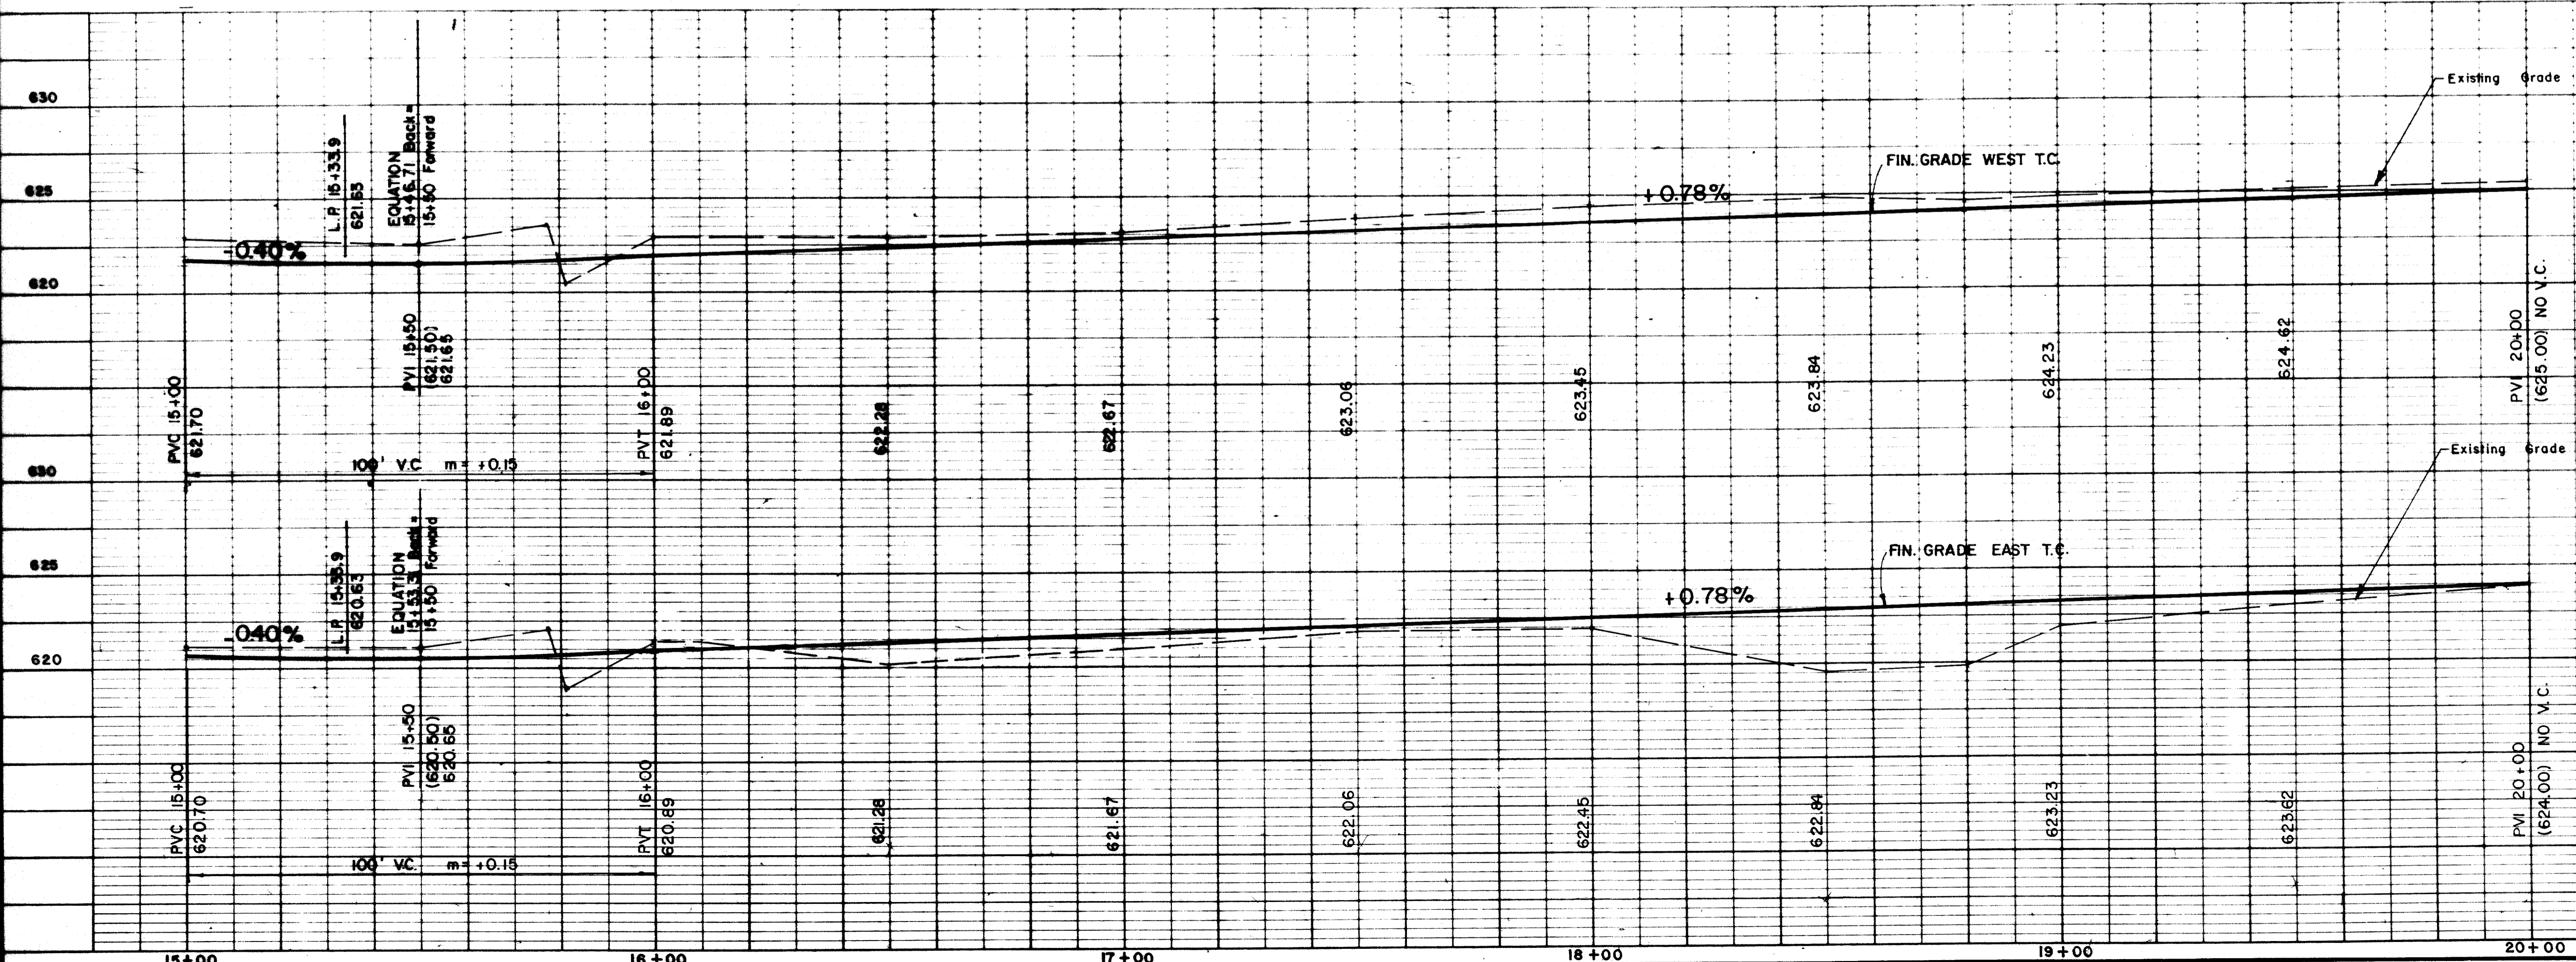


Curve Data

$\Delta = 6^\circ 05' 10''$
 $R = 1432.39'$
 $T = 76.15'$
 $L = 152.15'$
 $D = 4^\circ 00' 00''$

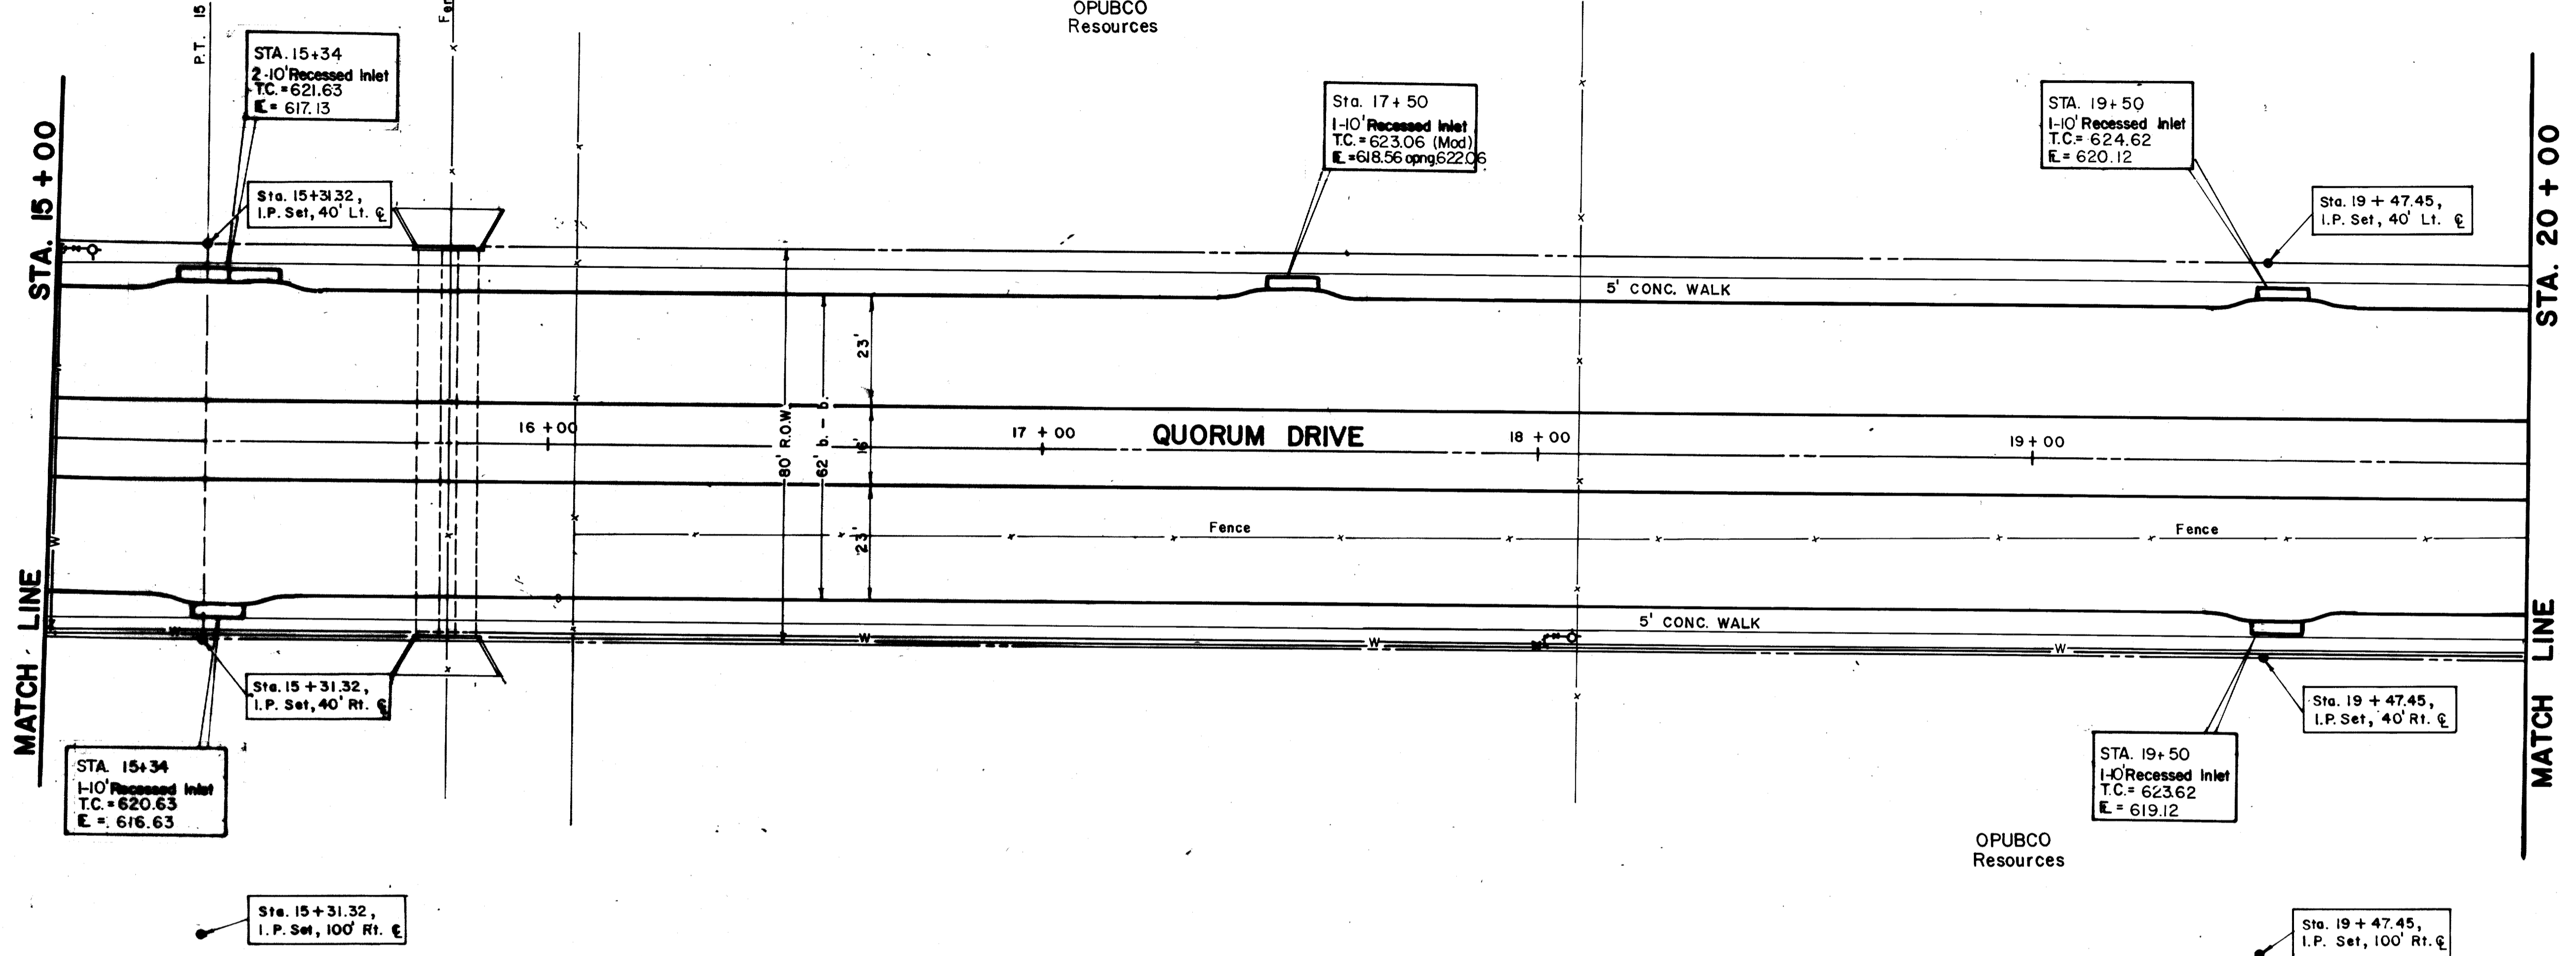

"AS BUILT"

No. _____	Revision _____	By _____	Date _____
CITY OF ADDISON DALLAS COUNTY, TEXAS QUORUM DRIVE			
PAVING - STA. 15+00 to 20+00			
GINN, INC. Consulting Engineers Dallas, Texas			
Designed - GF	Drawn - GF	Date - MAY, 1984	Job No. - J-203
Approved - WG	Checked - GF	Scale - 1" = 20'	Sheet 7 of 38