

OPUBCO
Resources



STA. 20+00

MATCH LINE

STA. 25+00

MATCH LINE

Sta. 21+50
1-10' Recessed Inlet
T.C. = 626.88
E. = 622.38

Sta. 23+50
1-10' Recessed Inlet
T.C. = 629.38
E. = 624.88

Sta. 23+50
1-10' Recessed Inlet
T.C. = 628.38
E. = 624.38

5' CONC. WALK

QUORUM DRIVE

5' CONC. WALK

21+00

22+00

23+00

24+00


62' b. - b.
80' R.O.W.

23'

16'

23'

OPUBCO
Resources

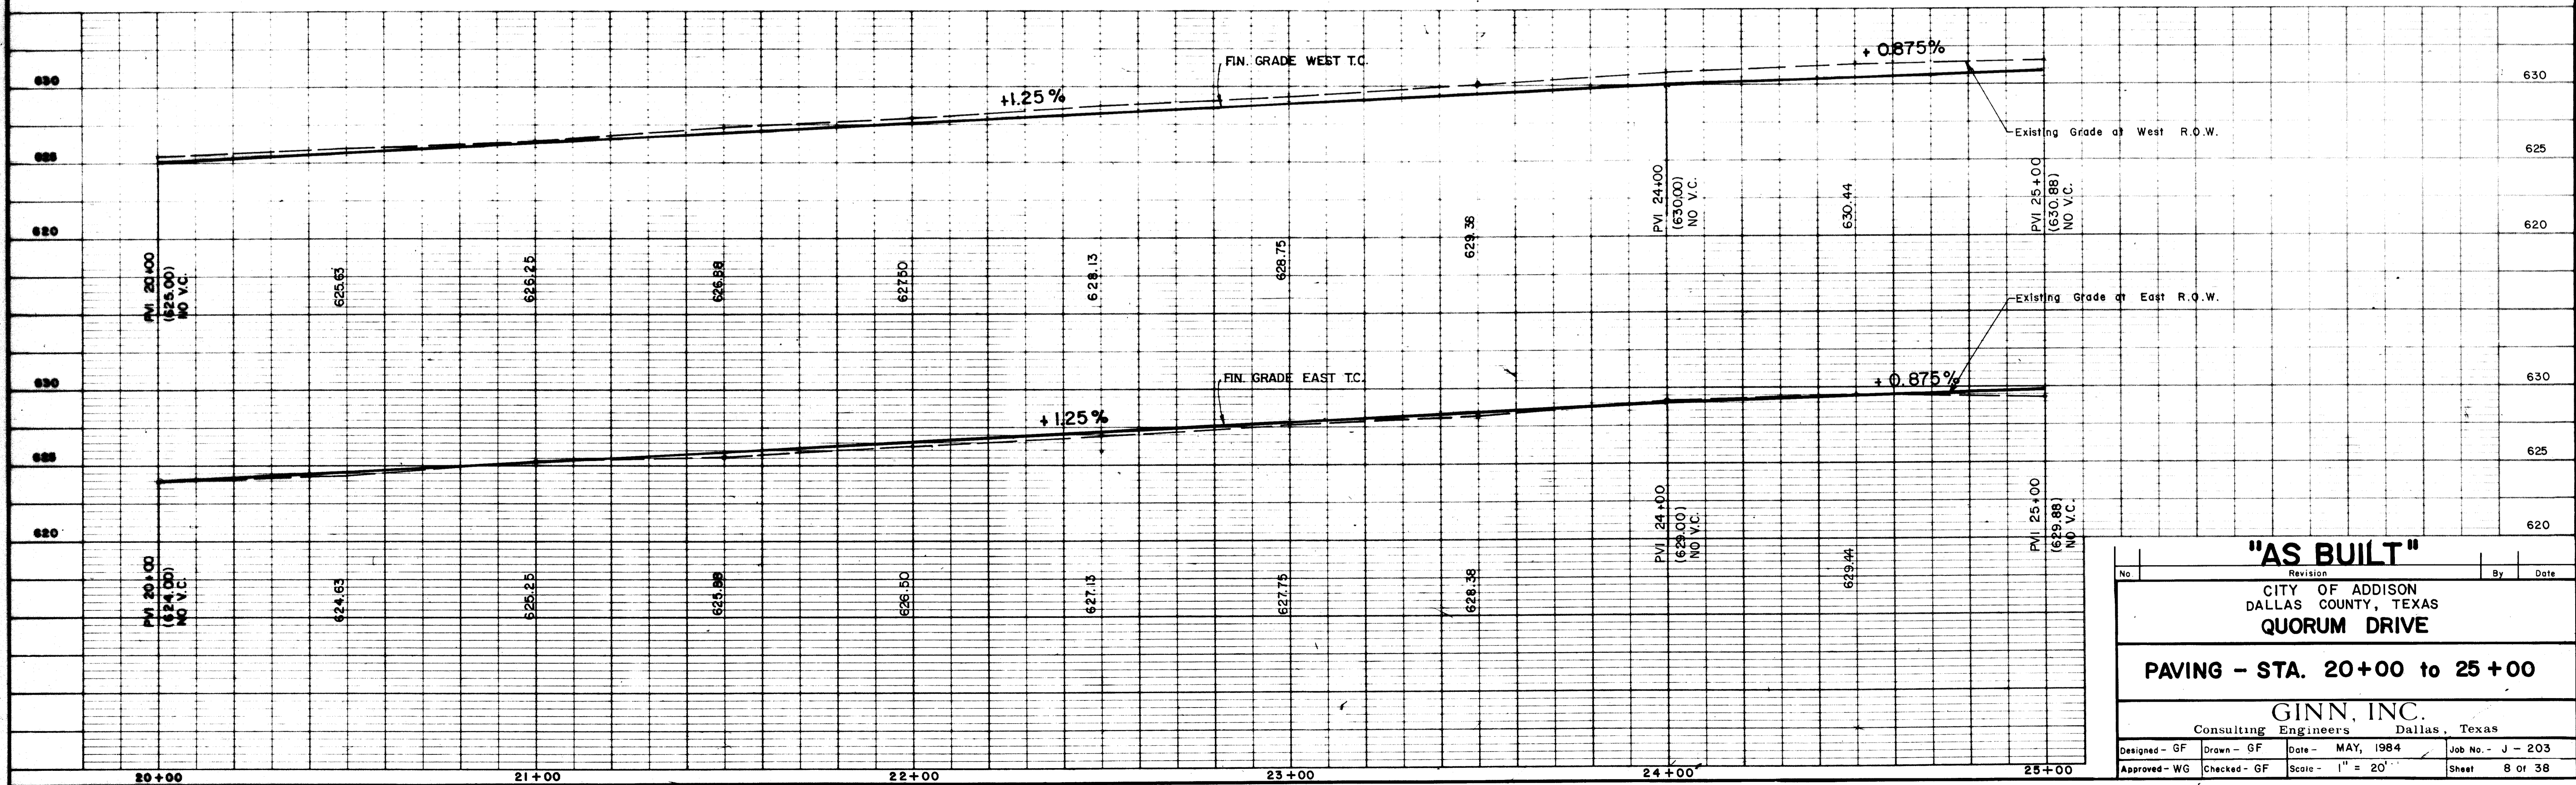

"AS BUILT"

Revision _____ By _____ Date _____

CITY OF ADDISON
DALLAS COUNTY, TEXAS
QUORUM DRIVE

PAVING - STA. 20+00 to 25+00

GINN, INC.
Consulting Engineers Dallas, Texas

Designed - GF	Drawn - GF	Date - MAY, 1984	Job No. - J - 203
Approved - WG	Checked - GF	Scale - 1" = 20'	Sheet 8 of 38