


OPUBCO Resources

OPUBCO Resources

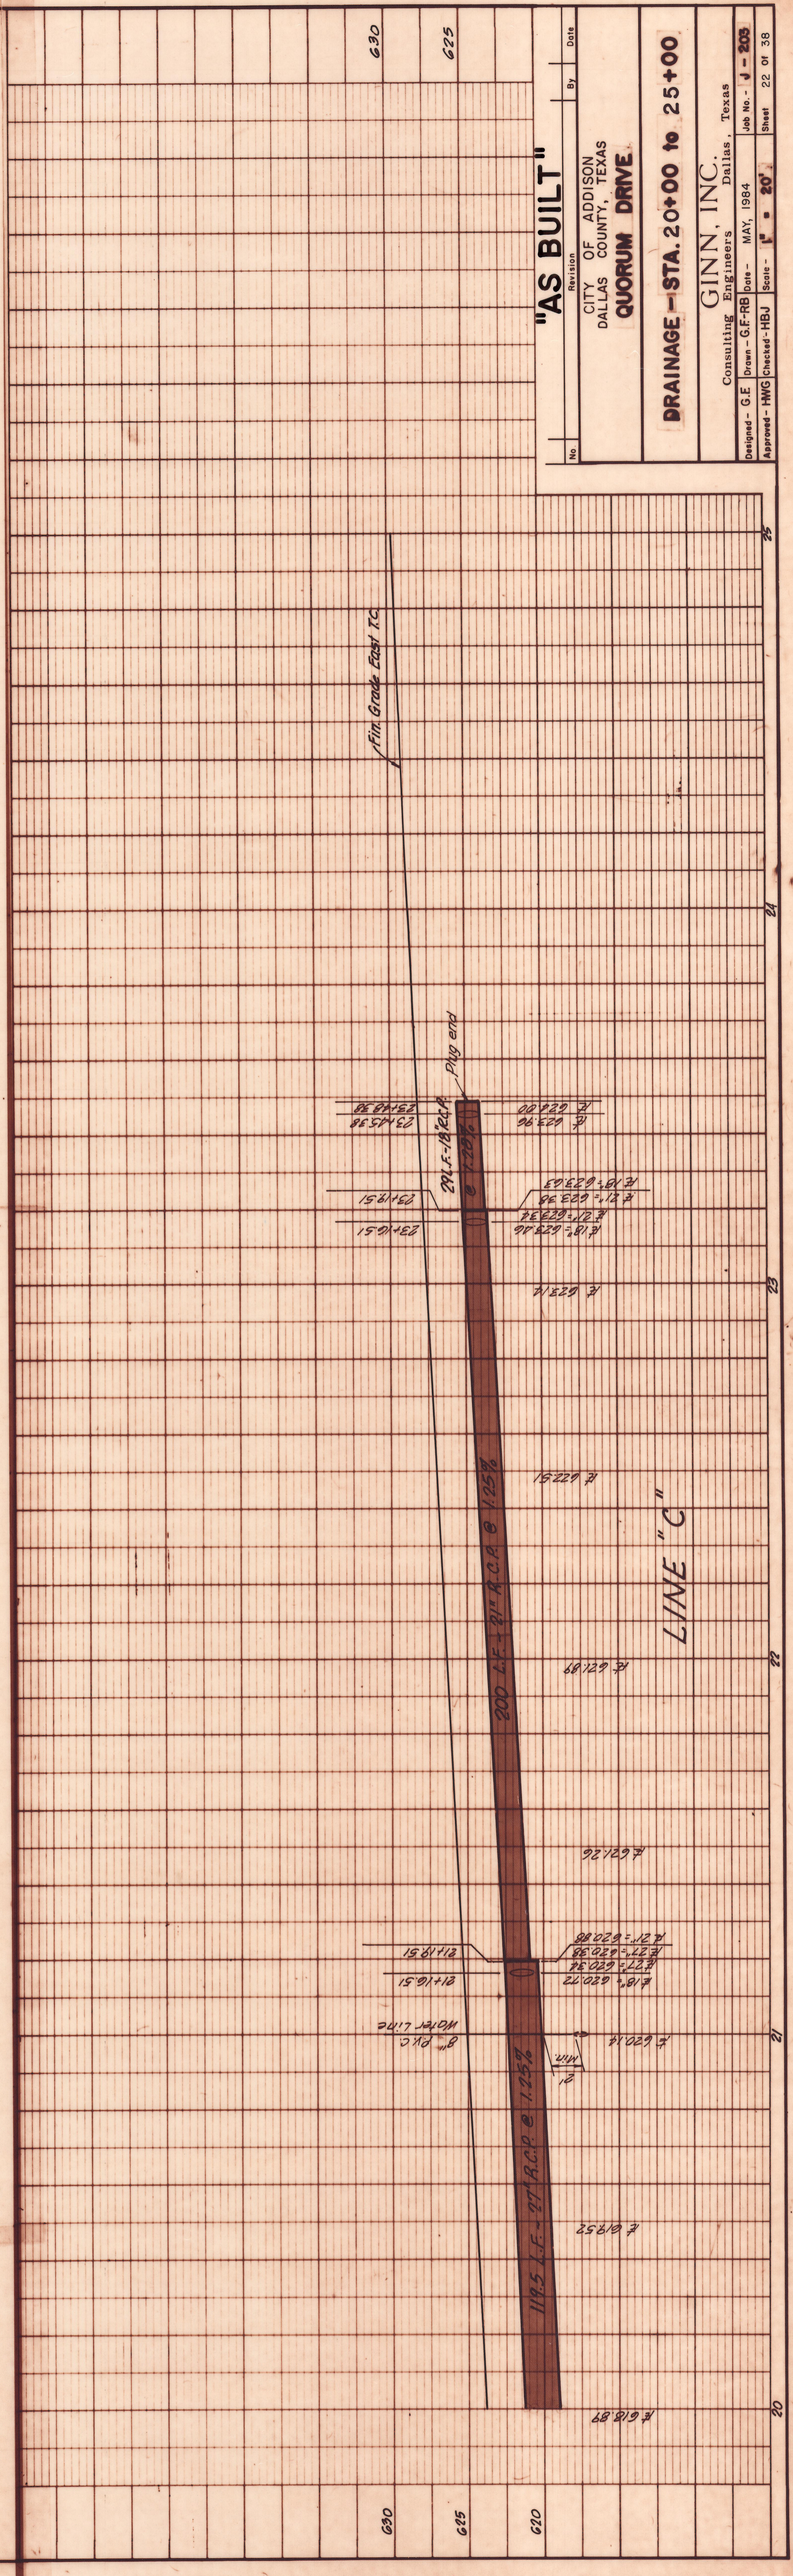

"AS BUILT"

No.	Revision	By	Date
CITY OF ADDISON DALLAS COUNTY, TEXAS QUORUM DRIVE			
DRAINAGE - STA. 20+00 to 25+00			
GINN, INC. Consulting Engineers Dallas, Texas			
Designed - G.E.	Drawn - G.F.-RB	Date - MAY, 1964	Job No. - J - 203
Approved - HMG	Checked - HBJ	Scale - 1" = 30'	Sheet - 22 OF 36