

CIVIL & LANDSCAPE PLANS FOR CONSTRUCTION OF
PAVING, STREETScape & UTILITY IMPROVEMENTS

QUORUM DRIVE

JANUARY 15, 2009

OWNER:


FAIRFIELD RESIDENTIAL, LLC
2045 N. HIGHWAY 360, SUITE 250
GRAND PRAIRIE, TEXAS 75050
(817) 307-8060

ENGINEER:

HUITT-ZOLLARS, INC.
3131 MCKINNEY AVE., SUITE 600
DALLAS, TEXAS 75204
(214) 871-3311 FAX (214) 871-0757
KEVIN N. CARLSON, P.E.
email: kcarlson@huitt-zollars.com
TX. REG. NO. 89232

RECORD DRAWING

THIS DRAWING HAS BEEN MODIFIED FROM THE ORIGINAL TO SHOW ONLY THE FIELD CHANGES AND ADJUSTMENTS MADE DURING CONSTRUCTION BY THE CONTRACTOR WHICH WERE DOCUMENTED AND FURNISHED TO THE ENGINEER FOR THE PURPOSE OF PREPARING THESE RECORD DRAWINGS. FIELD INSPECTION OF CONSTRUCTION WAS PERFORMED BY OTHERS. TO THE BEST OF OUR KNOWLEDGE AND UNDERSTANDING THESE RECORD DRAWINGS REPRESENT THE "AS-BUILT" CONDITIONS.

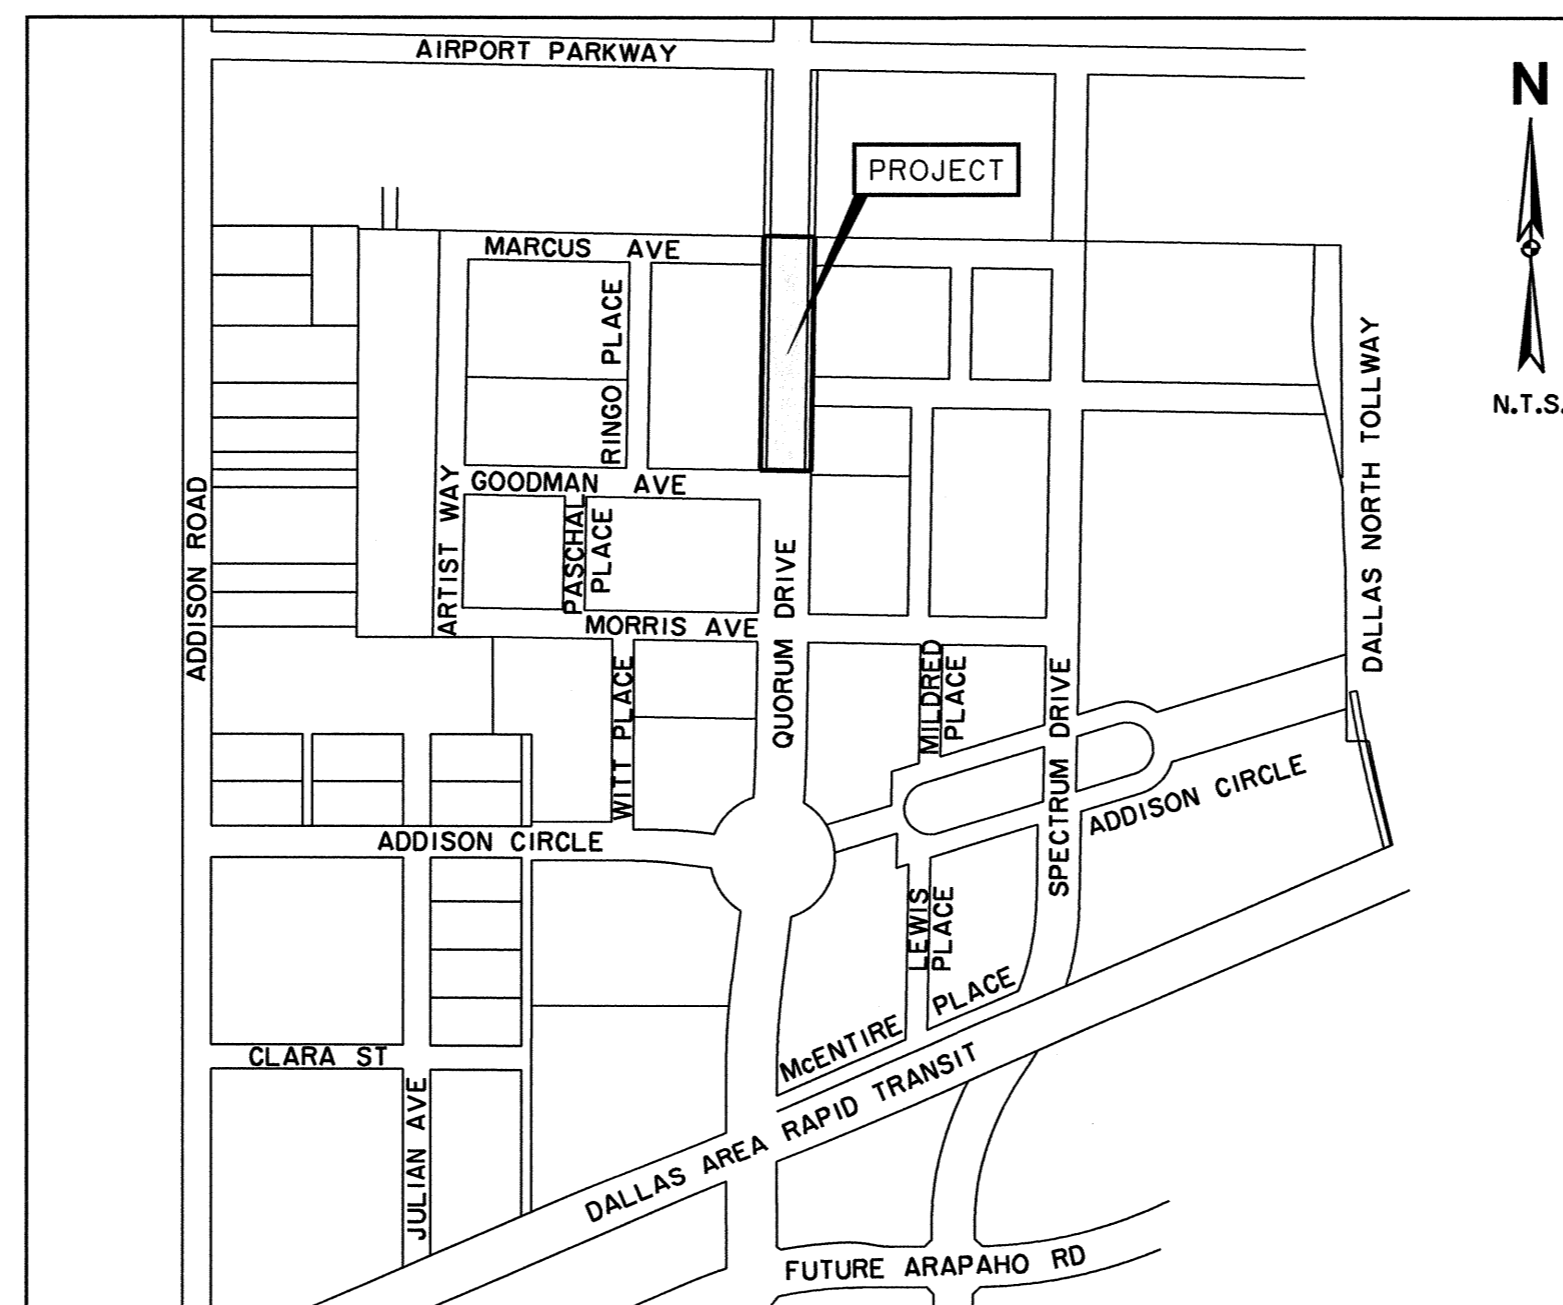

LOCATION MAP

SHEET NO.	INDEX OF DRAWINGS
C1	COVER SHEET
C2	PAVING TYPICAL SECTIONS
C3	RECOMMENDED UTILITY LOCATIONS
C4	SIGNAGE & STRIPING PLAN
C5	PAVING & GRADING PLAN
C6	PAVING DETAILS
C7	STREETScape PLAN
C8, C9	STREETScape, LIGHT & SUBDRAIN DETAILS
C10	DRAINAGE AREA MAP
C11	STORM WATER PLAN & PROFILE
C12, C13	STORM WATER DETAILS
C14	WATER & WASTEWATER PLAN
C14a, C14b	WATER & WASTEWATER PROFILES
C15, C16	WATER DETAILS
C17, C17a	WASTEWATER DETAILS
C18	POLLUTION CONTROL PLAN
C19	POLLUTION CONTROL DETAILS
C20	ELECTRICAL PLAN (NOT IN THIS SET, SEE ADDISON RESIDENTIAL PLANS)
C20a	ELECTRICAL SYMBOLS, NOTES & SCHEDULES (NOT IN THIS SET, SEE ADDISON RESIDENTIAL PLANS)
C21	PLANTING & FURNITURE PLAN (WITH PLANTING DETAILS)
C22	IRRIGATION PLAN
C23	TOWN OF ADDISON IRRIGATION SPECS.
C24	IRRIGATION DETAILS