


22 615.09 150 615.33 23 615.57 150 615.81 24 614.05 150 614.28 25+00 614.48 150 614.68 26 614.68 150 615.08 27 615.28 150 615.48 28 615.68 150 615.88 29 616.08 150 616.28 30+00 616.47 150 616.62 31 616.77 150 616.92 32 617.07 150 617.22 33 617.37 150 617.52 34 617.67

SCALE: HORIZ. 1" = 40'
VERT. 1" = 4'

BENCHMARKS:
□ ON NOSE ISLAND SOUTH SIDE BELT LINE AT DALLAS PARKWAY ELEVATION 630.77
WATER DEPARTMENT BENCHMARK ON INLET ON NORTH-WEST CORNER OF DALLAS PARKWAY & BELT LINE ROAD ELEVATION 632.10

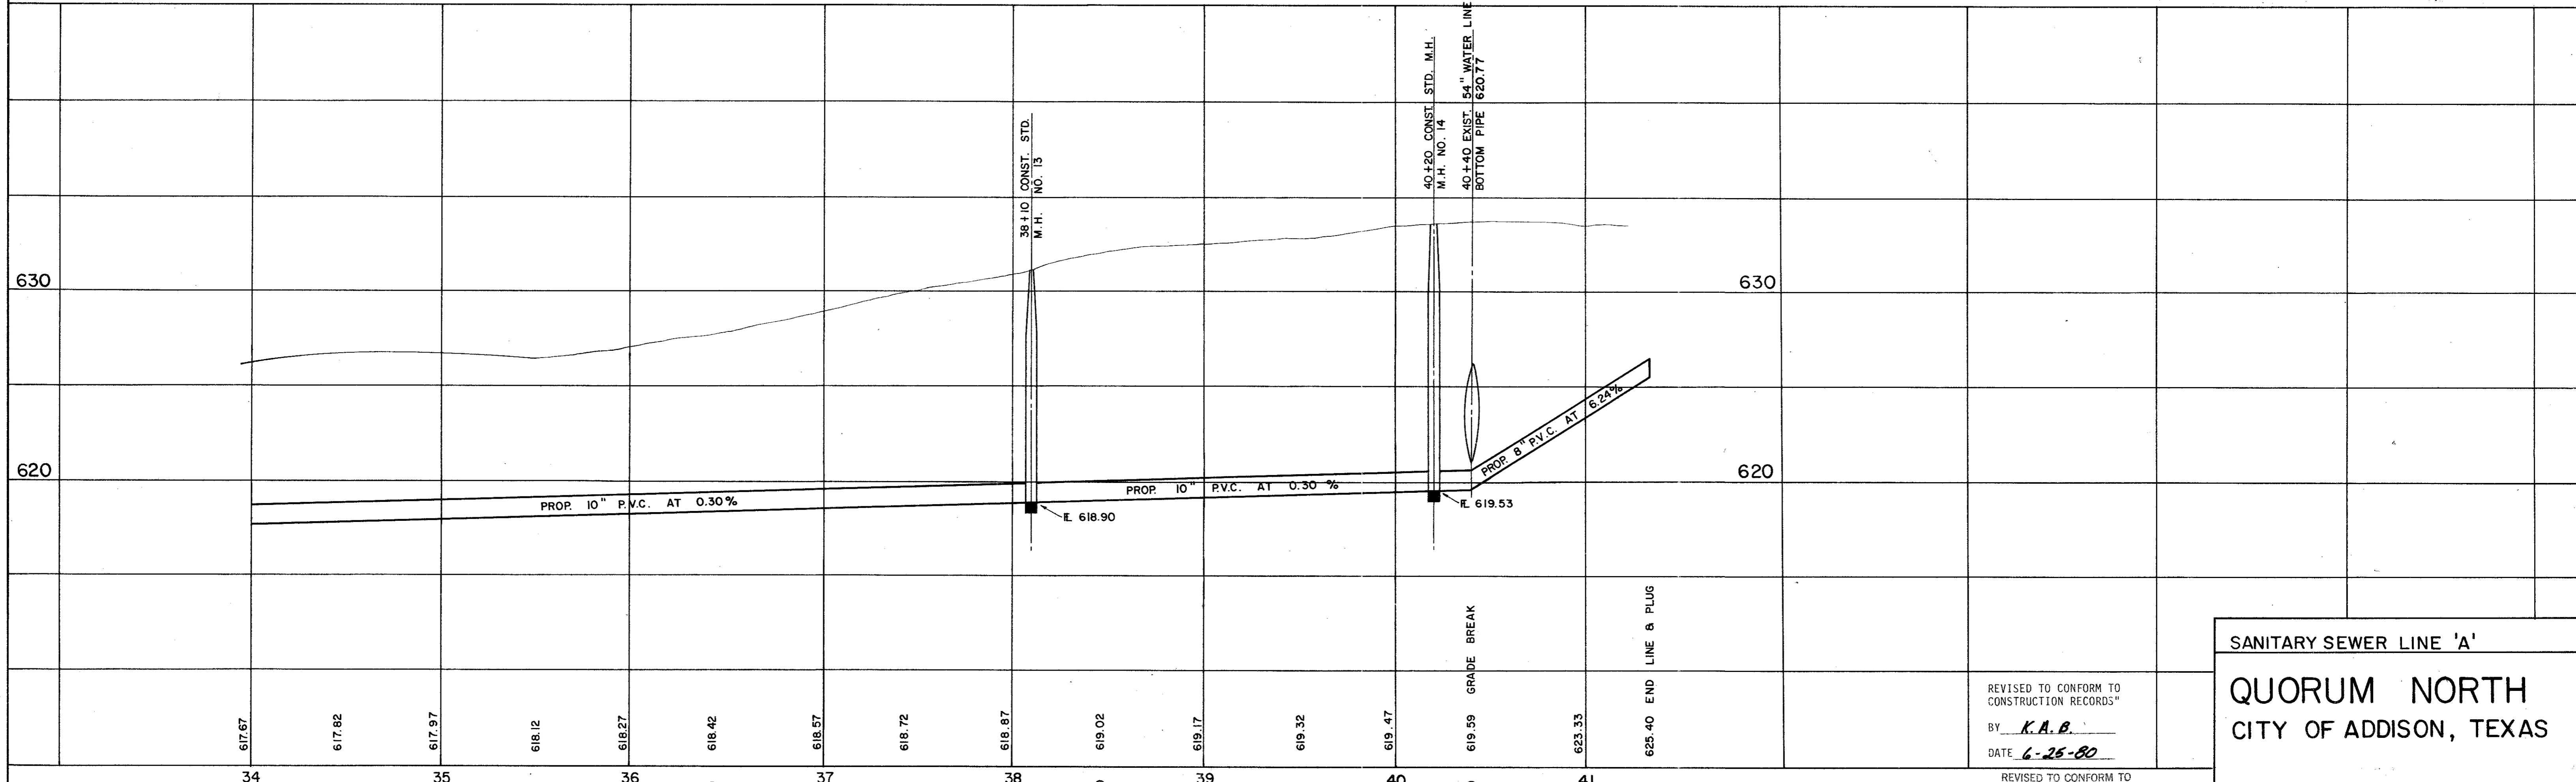

34 617.67 150 617.82 35 617.97 150 618.12 36 618.27 150 618.42 37 618.57 150 618.72 38 618.87 150 619.02 39 619.17 150 619.32 40 619.47 150 619.59 41 623.33 150 625.40

REVISED TO CONFORM TO CONSTRUCTION RECORDS"
BY K.A.B.
DATE 6-25-80

REVISED TO CONFORM TO CONSTRUCTION RECORDS:
BY _____
DATE _____
Grade revision from 29+90.82 to end: 1-25-80

SANITARY SEWER LINE 'A'
QUORUM NORTH
CITY OF ADDISON, TEXAS

Graham Associates, Inc.
CONSULTING ENGINEERS & PLANNERS

Date 9-79
File 314-1441
Drawn By: G.A.I. Sheet 12 Of 19