


- GENERAL NOTES**
1. WATER LINES SHALL BE LOCATED A MINIMUM OF 48" DEPTH EXCEPT WHERE NOTED.
 2. 6" GATE VALVES SHALL BE INSTALLED WITH ALL FIRE HYDRANTS.
 3. ALL FIRE HYDRANTS SHALL BE LOCATED 1.5 FEET INSIDE R.O.W.
 4. ALL STORM DRAIN CURB INLETS SHALL BE RECESSED AND STANDARD 10" INLETS.
 5. ALL MATERIALS AND WORKMANSHIP TO CONFORM TO CITY OF ADDISON STANDARDS.
 6. WATER MAIN TO BE AT THE FOLLOWING DEPTH BETWEEN THE LISTED STATIONS.
 - 1) 7+20 to 7+30 6FT. to E. AT STORM DRAIN.
 - 2) 7+40 8" CROSSING 8FT. to E. AT STORM DRAIN.
 - 3) 29+90 8" CROSSING 8.5FT. to E. AT STORM DRAIN.
 - 4) 35+20 to 35+70 11FT. to E.
 - 5) 12" CROSSING AT FACTORY 8FT. to E. AT STORM DRAIN.
 - 6) 12" FACTORY AT MARCEY 6FT. to E. AT STORM DRAIN.
 7. ALL 8" SANITARY SEWER STUBS to be LAID ON A 1% GRADE.

1737
1567
170
1567
1012
555

1012
592
420

3700' - 12"
385' - 8"

DATE: 2-19-80
NOTE: CONTRACTOR IS RESPONSIBLE FOR VERIFYING ALL REQUIREMENTS OF BOTH LOCAL AND STATE CODES AND/OR ORDINANCES AND FOR OBTAINING ALL NECESSARY APPROVALS AND PERMITS PRIOR TO COMMENCEMENT OF WORK. APPROVAL TO RELIEVE CONTRACTOR OF LIABILITY FOR VARIANCE TO SUCH CODES.

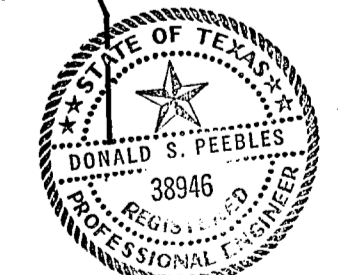

UTILITY SITE PLAN
QUORUM NORTH
CITY OF ADDISON, TEXAS



SCALE 1"=100'

3360
2820
140

3370 3820
2500 3320
3000 450

2700
2687
303

2087
2047
270

2447
1995
952

1995
1737
259

385' - 8"
4200' - 12"
1495
1237
258

592

592
625'